


GEORGE T. DUNHAM
SURVEYING & SUBDIVIDING
DELAVER, WISCONSIN



Scale - 1" = 200'
○ = Iron Pipe
● = Concrete Monuments

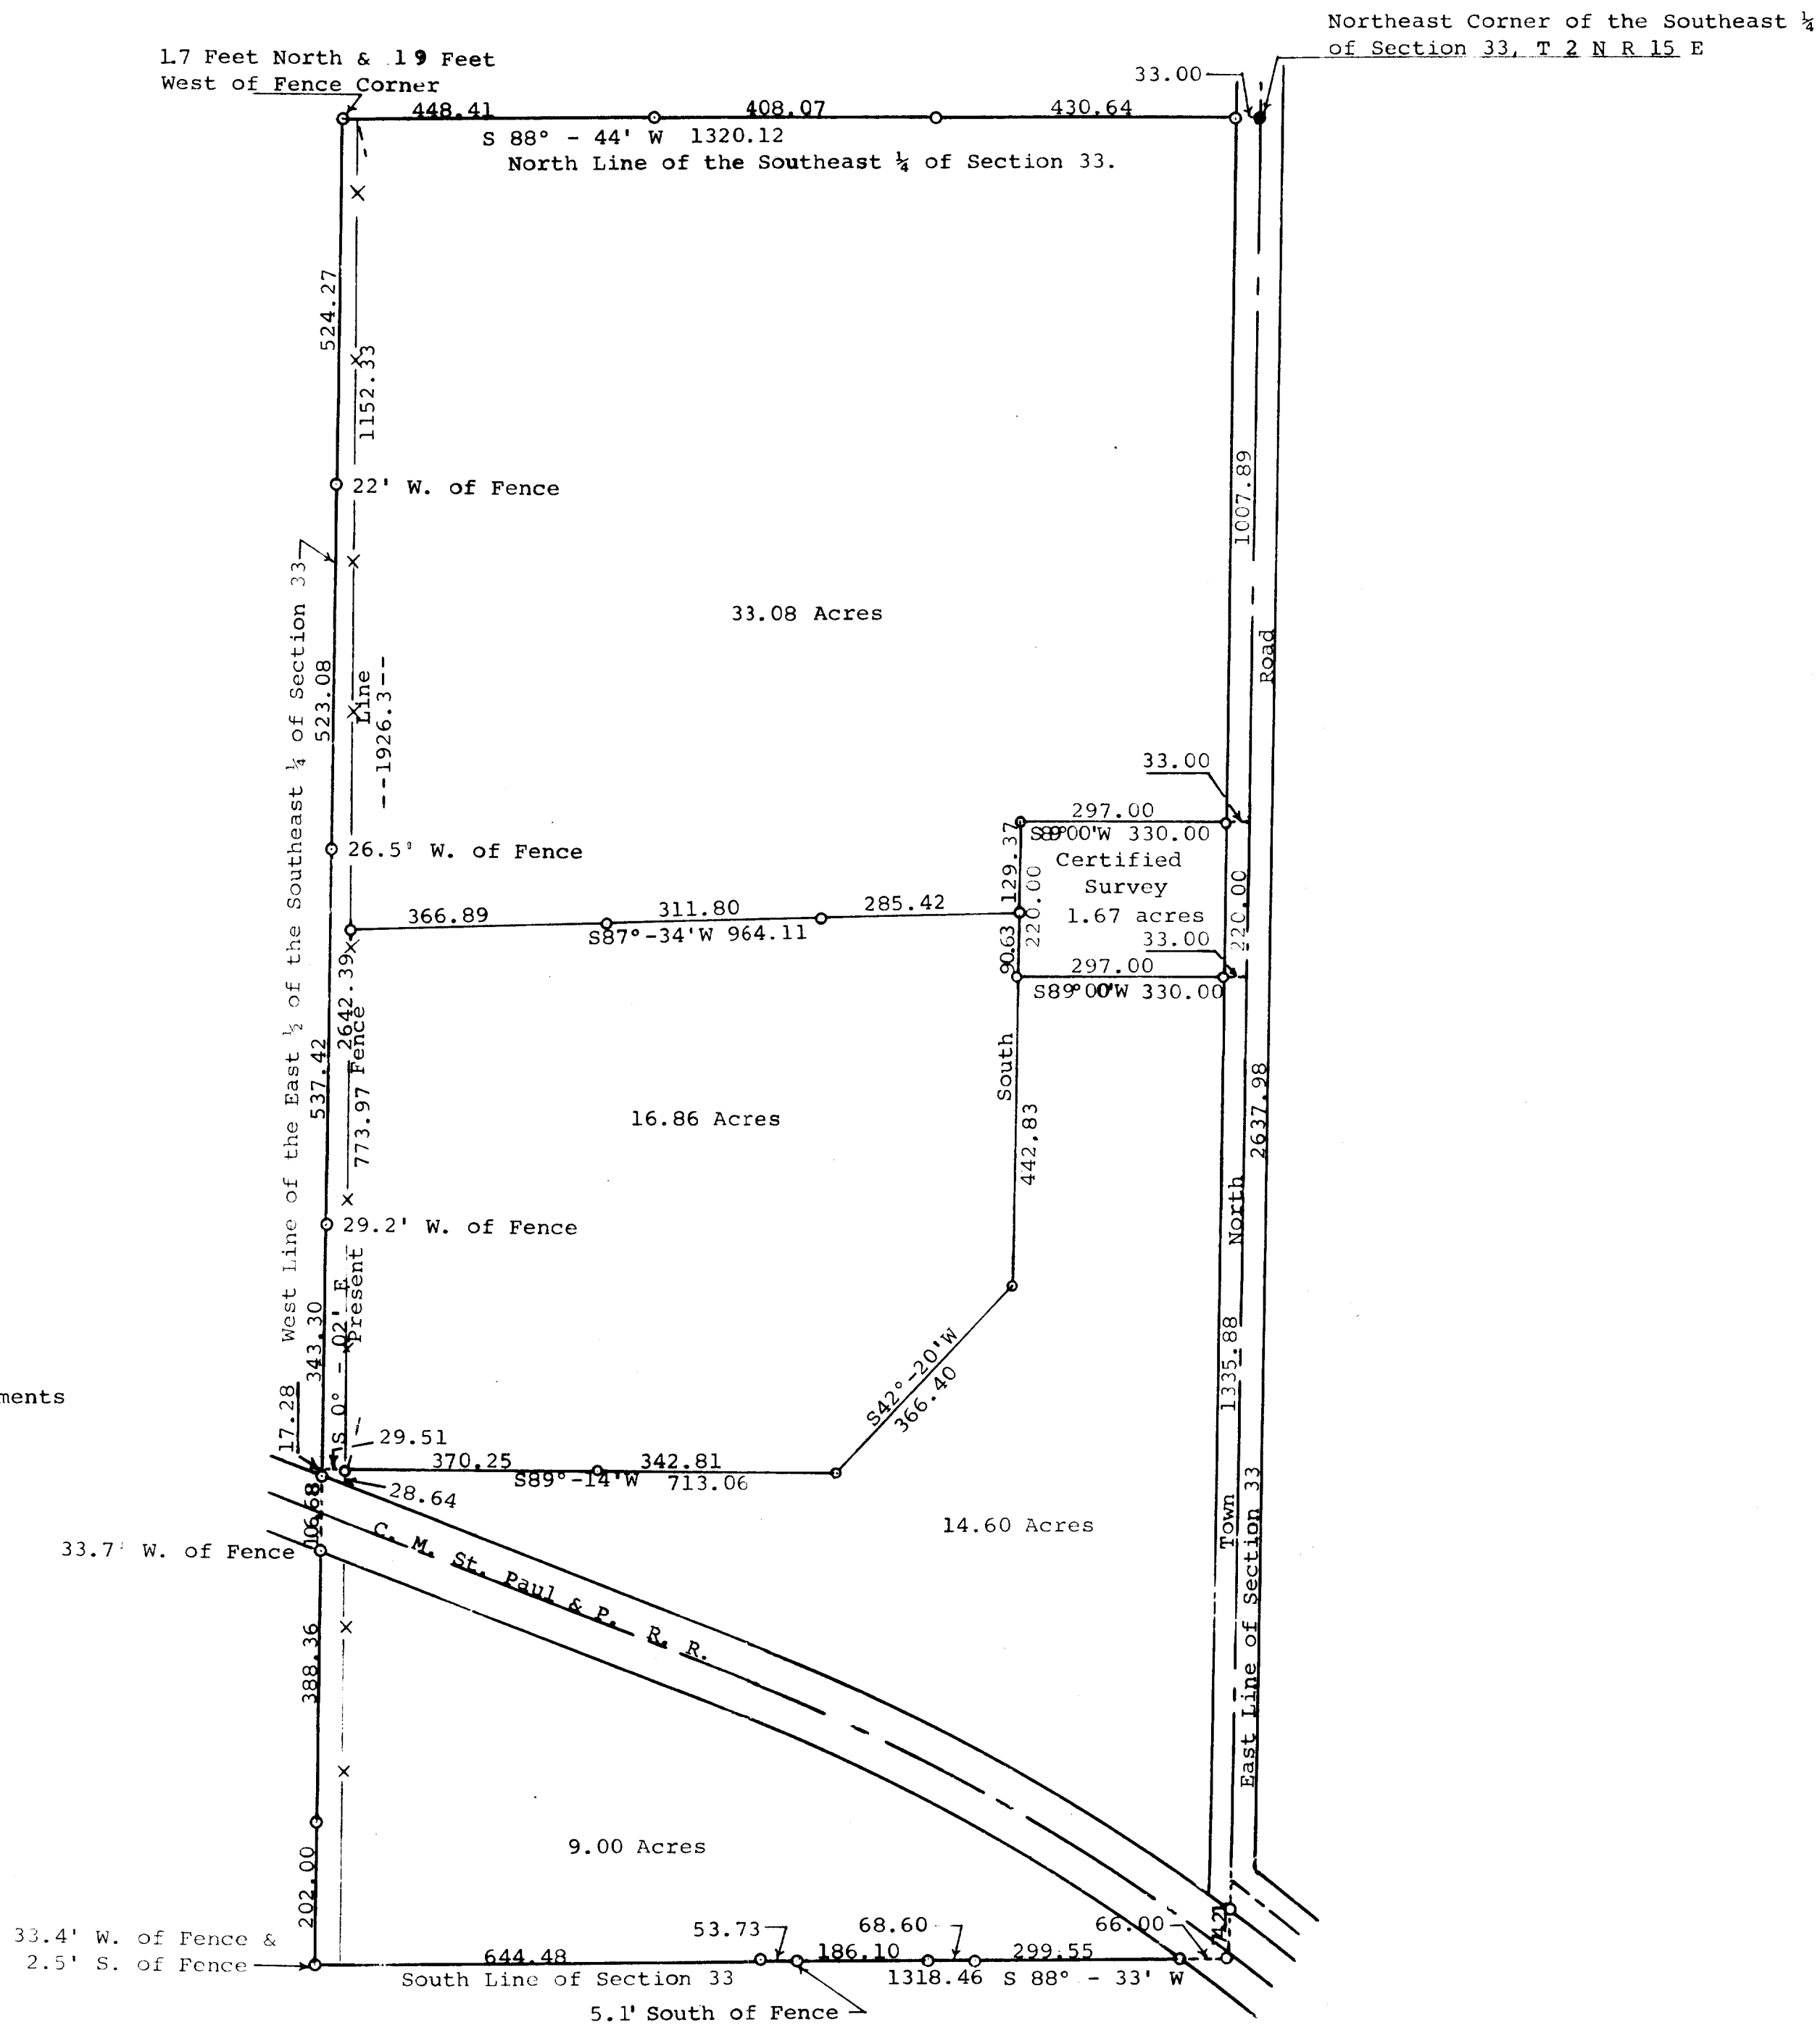

Plat of survey of the East 1/2 of the Southeast 1/4 of Section
33, T 2 N R 15 E, Walworth County, Wisconsin.
May 21, 1964
Revised 11/5/71 *George T. Dunham*
Revised 11/22/74 George T. Dunham, Surveyor

