


DUNHAM SURVEYING, S.C.
SURVEYING & SUBDIVIDING
DELAVAN, WISCONSIN 53115

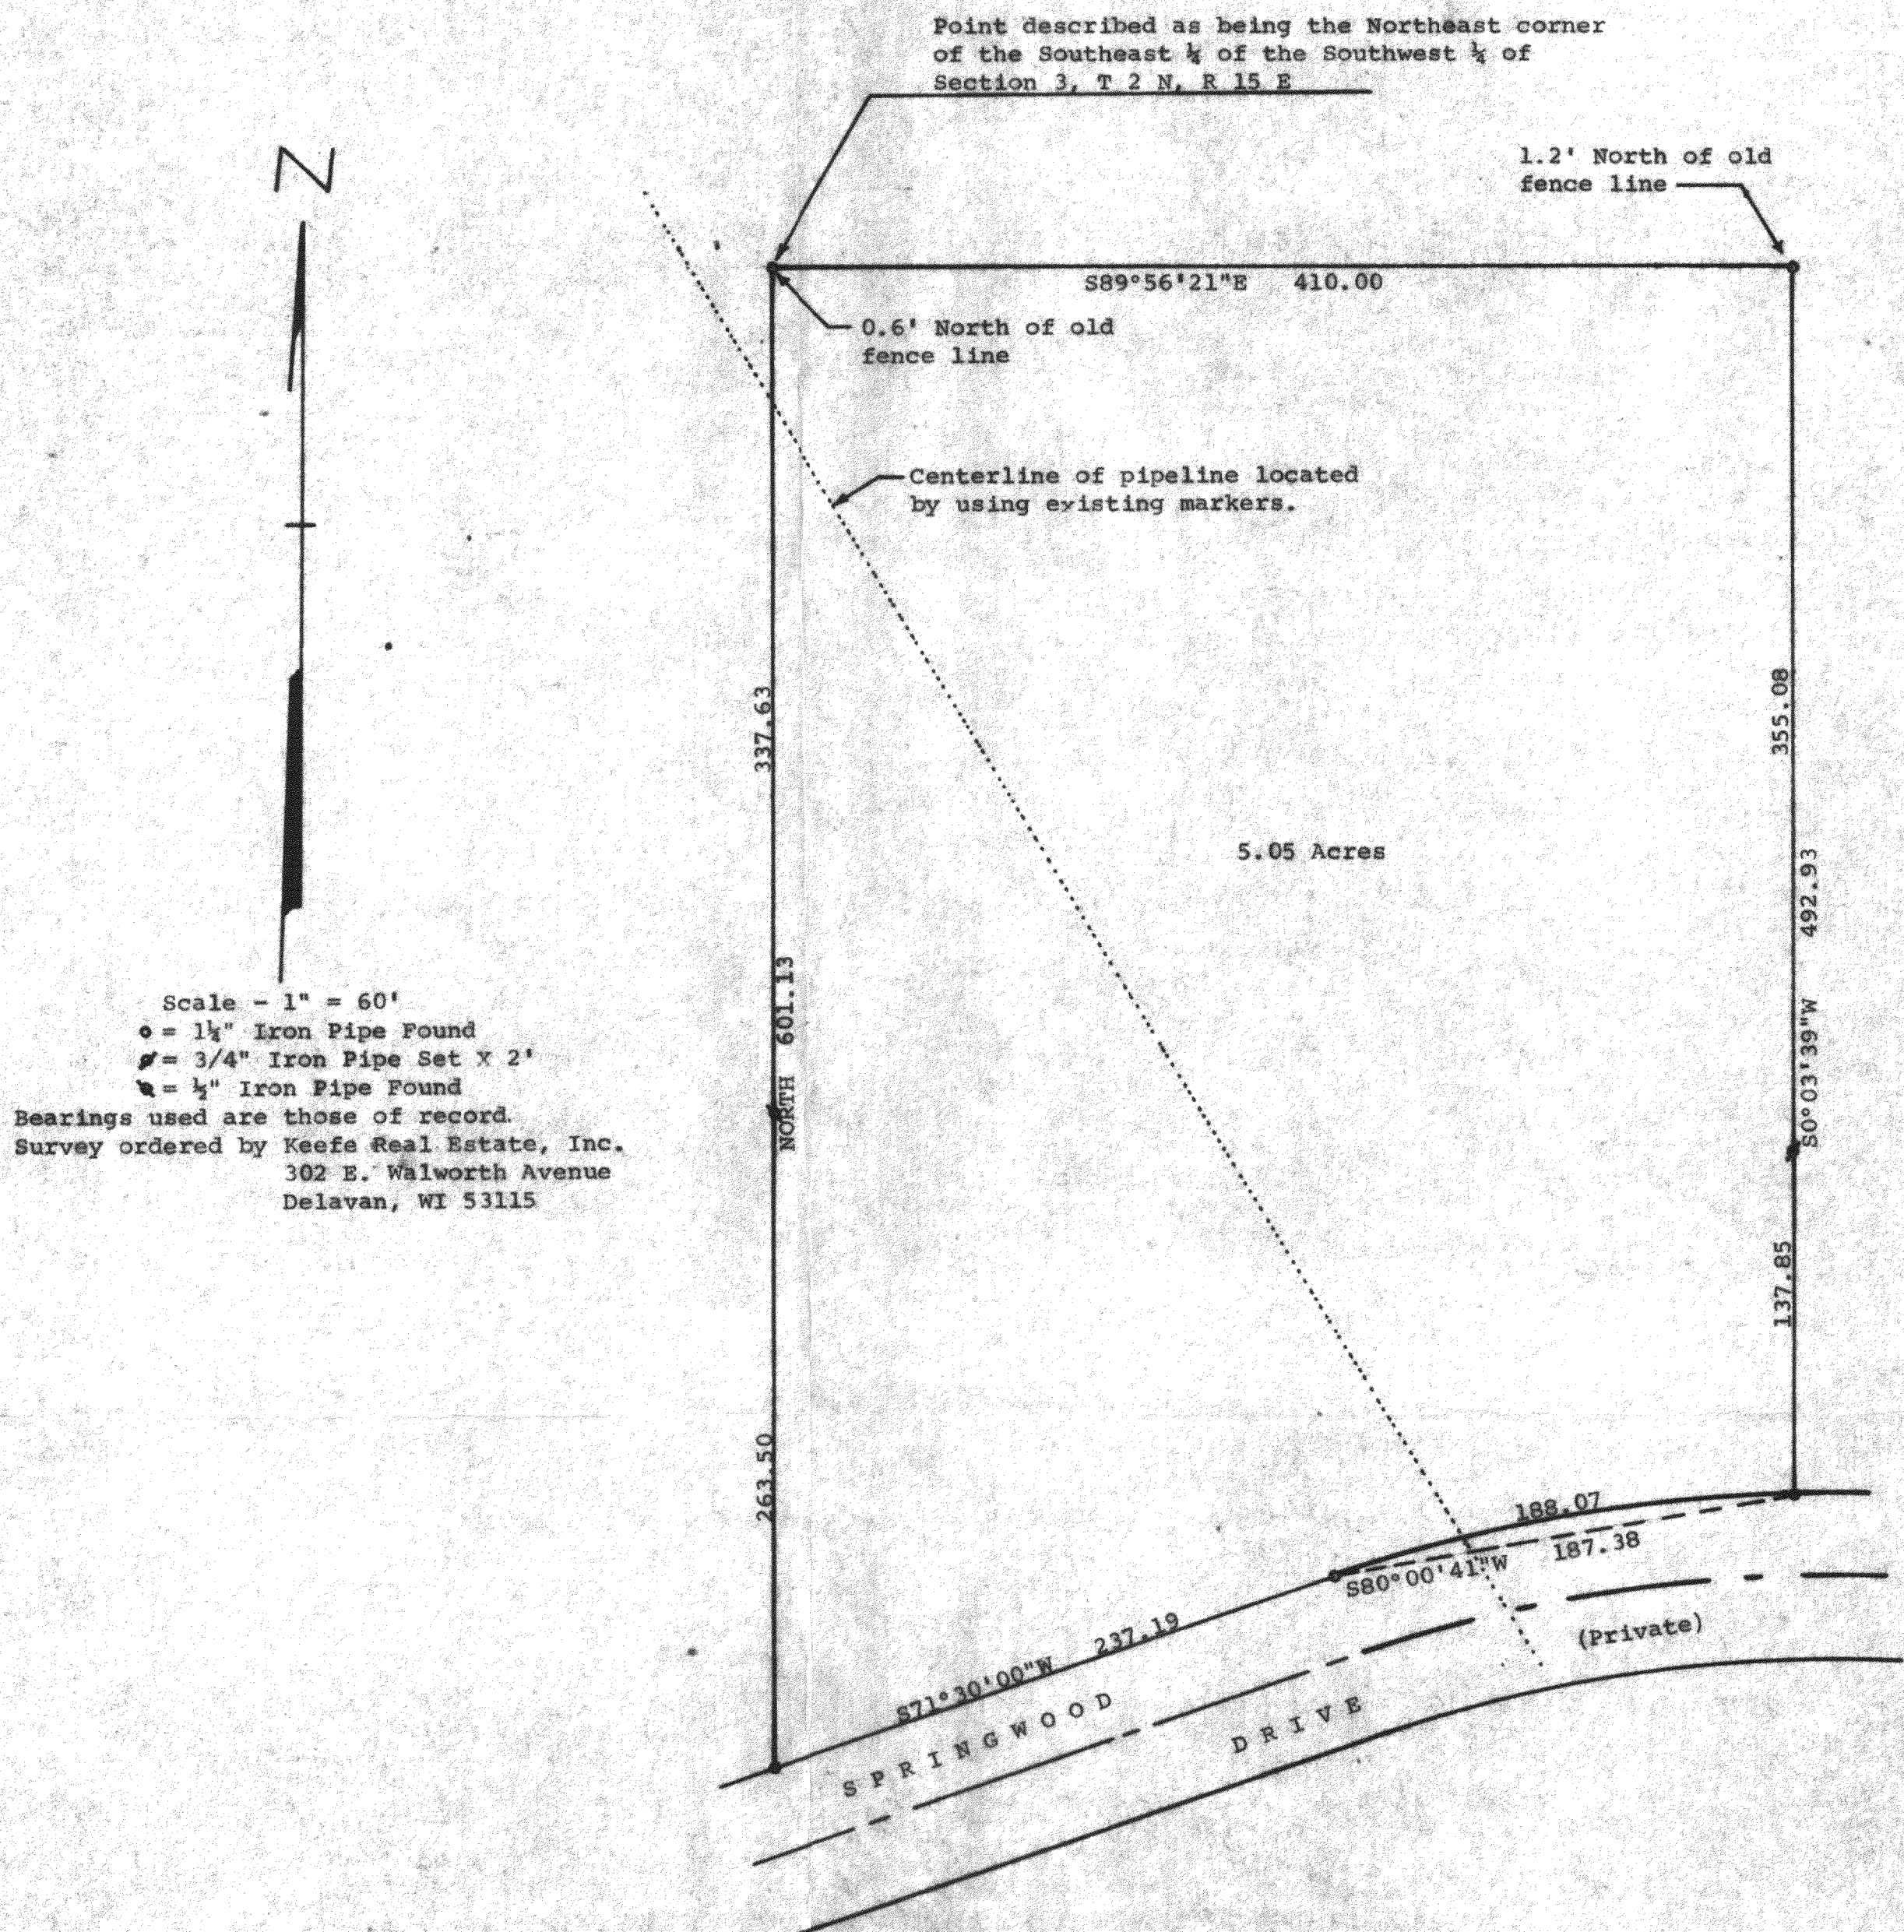

STATE OF WISCONSIN)
COUNTY OF WALWORTH) SS

I, George T. Dunham, Surveyor, certify that I have surveyed the property described as follows:

A parcel of land located in the Southeast $\frac{1}{4}$ of Section 3, T 2 N, R 15 E, Walworth County, Wisconsin, described as follows: Beginning at the northeast corner of the Southeast $\frac{1}{4}$ of the Southwest $\frac{1}{4}$ of Section 3; thence South 89°-56'21\"E along the North line of said $\frac{1}{4}$, $\frac{1}{4}$ section, 410.00 feet; thence S0°03'39\"W 492.93 feet to a point on a curve whose center lies to the south, with a radius of 633.00 feet and a chord bearing S80°00'41\"W 187.38 feet; thence Southwesterly 188.07 feet along said curve; thence S71°30'00\"W 237.19 feet; thence North 601.13 feet to the place of beginning. (also known as Lot 5 of the unrecorded plat of Springwood Farm), subject to easements of record.

and that the above map is a true representation thereof and shows the size and location of the property, its exterior boundaries, the location of all visible structures and dimensions of all principal buildings thereon, boundary fences, apparent easements, roadways and visible encroachments, if any, and that I have surveyed the property hereon described according to the official records, to the best of my knowledge and belief.

May 13, 1983

George T. Dunham
George T. Dunham, Surveyor

