


DUNHAM SURVEYING, S.C.
SURVEYING & SUBDIVISION
DELAWARE, WISCONSIN 53115

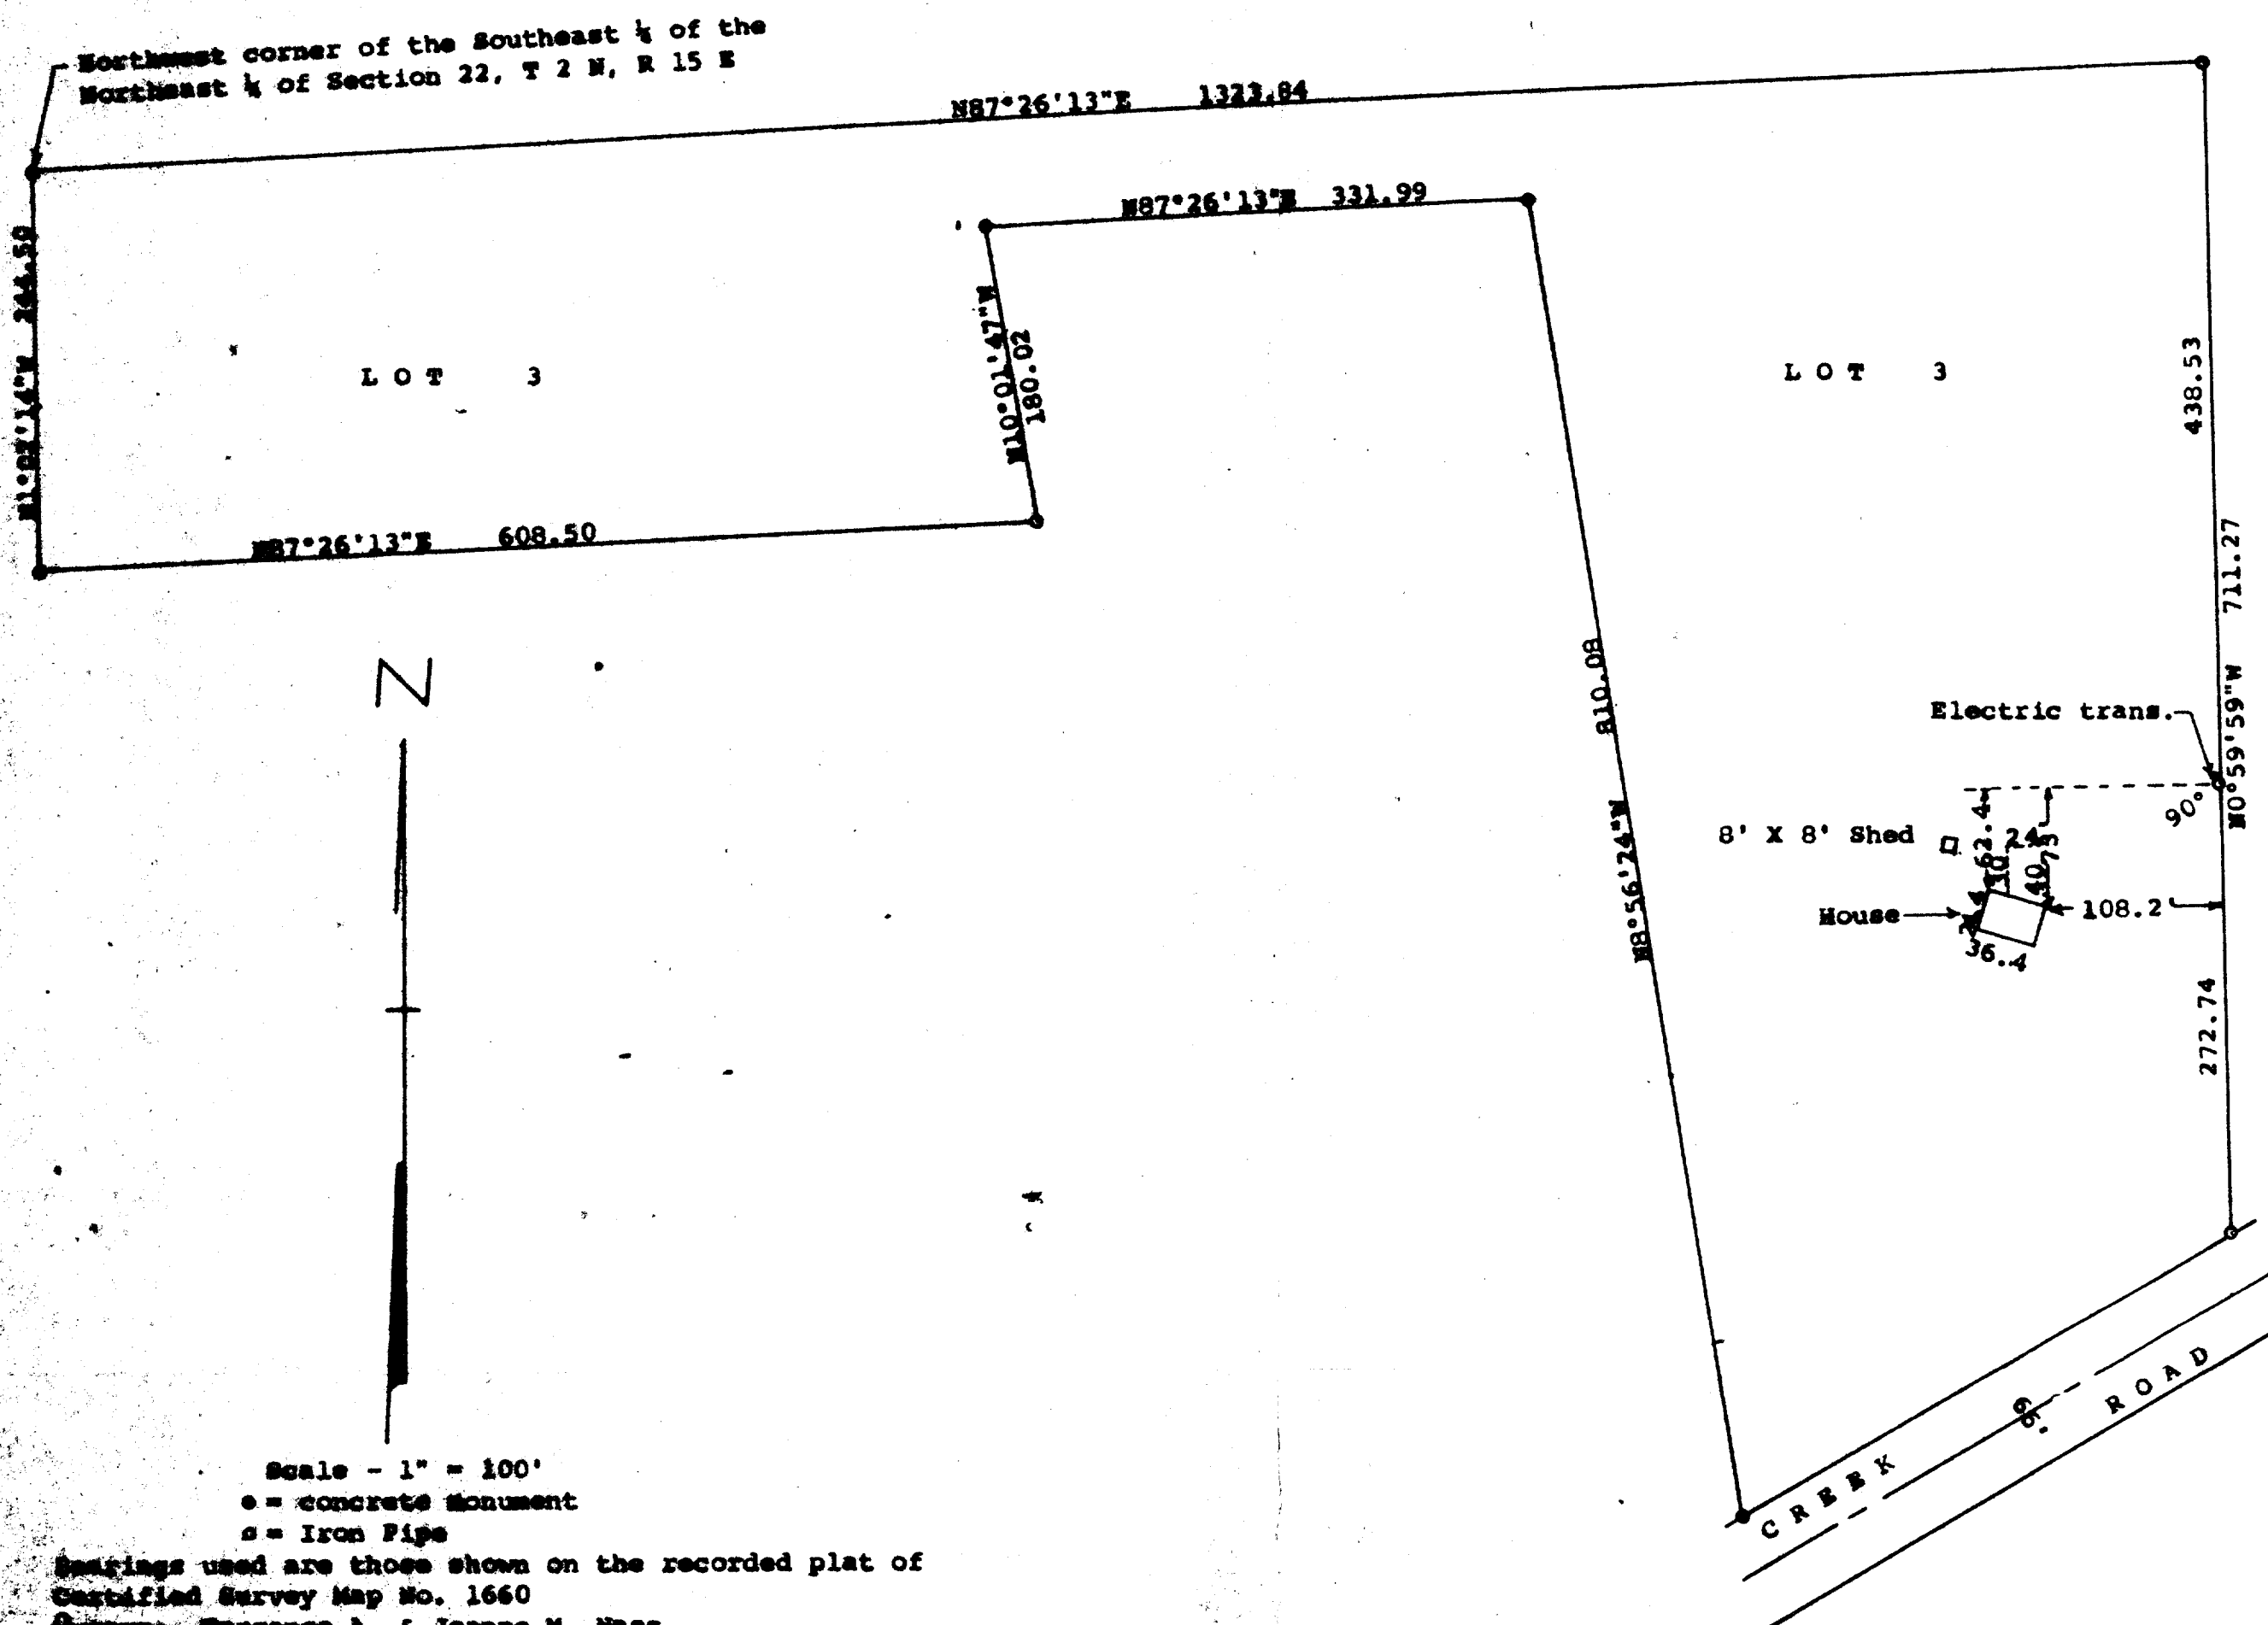

STATE OF WISCONSIN)
COUNTY OF WALWORTH)



I, George T. Dunham, Surveyor, certify that I have surveyed the property described as follows:

Lot 3 of Certified Survey No. 1660, recorded in Vol. 8 of Certified Surveys on Page 15, Document No. 158027, on January 22, 1988, in the Office of the Register of Deeds, Elkhorn, Wisconsin, being a parcel of land located in the Southeast 1/4 of the Northeast 1/4 of Section 22, T 2 N, R 15 E, Walworth County, Wisconsin,

and that the plat shown hereon is a correct representation thereof and shows the size and location of the property, its exterior boundaries, the location of all visible structures and dimensions of all principal buildings thereon, apparent easements, roadways and visible encroachments, if any, and that I have surveyed the property hereon described, according to the official records, to the best of my knowledge and belief.

July 31, 1989

George T. Dunham
George T. Dunham, Surveyor

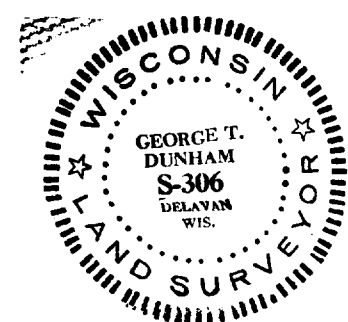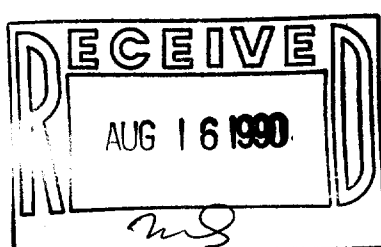

TAX KEY # BA166000003