


DUNHAM SURVEYING, S.C.
SURVEYING & ENGINEERING
DELAVER, WISCONSIN 53118

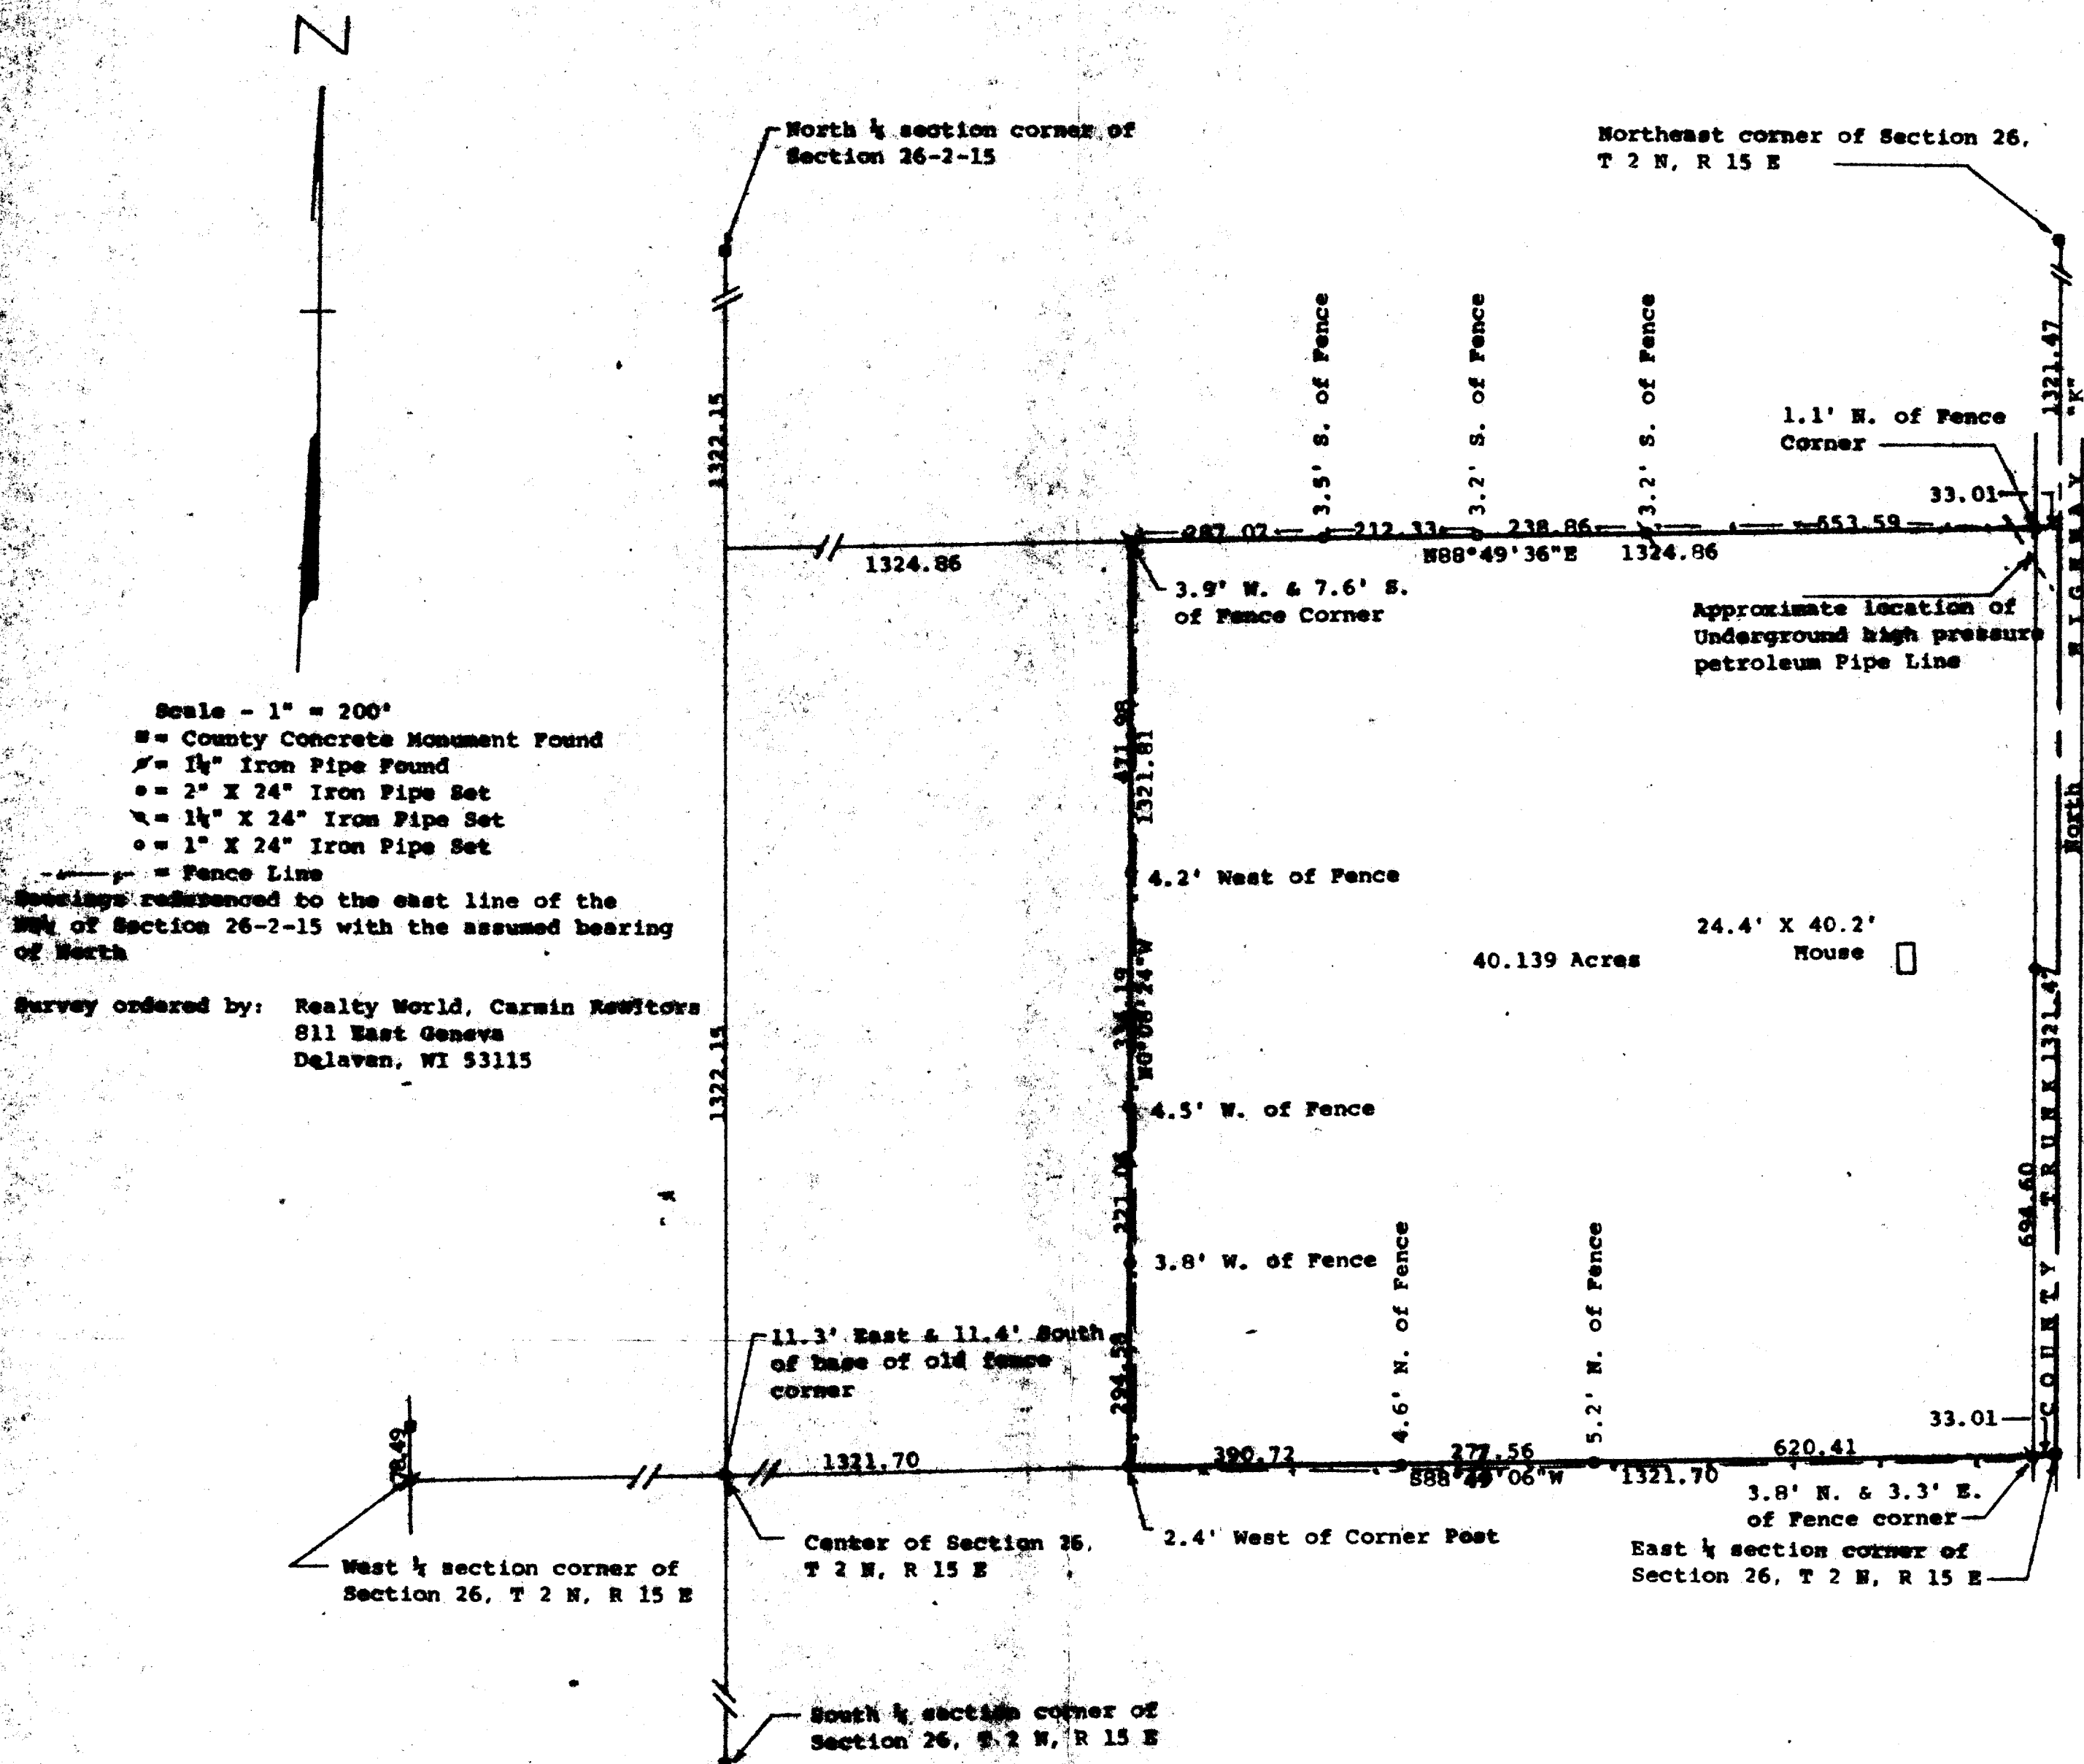

STATE OF WISCONSIN)
COUNTY OF WALWORTH)

I, George T. Dunham, Surveyor, certify that I have surveyed the property described as follows:

The Southeast 1/4 of the Northeast 1/4 of Section 26, T 2 N, R 15 E, Walworth County, Wisconsin, excepting easement for pipe line recorded February 13, 1968 in Volume 659 of Deeds, Page 316,

and that the plat shows hereon is a correct representation thereof and shows the size and location of the property, its exterior boundaries, the location of all visible structures and dimensions of all principal buildings thereon, boundary fences, apparent easements, roadways and visible encroachments, if any, and that I have surveyed the property hereon described, according to the official records, to the best of my knowledge and belief.

March 29, 1990

George T. Dunham
George T. Dunham, Surveyor

