


PLAT OF SURVEY

of Lot 1 of CERTIFIED SURVEY MAP NO. 579, according to the recorded plat thereof, recorded in Volume 3 of Certified Surveys on page 33, as Document No. 04525, located in the East Half of the Northwest Quarter of Section 13, Township 2 North, Range 15 East, Walworth County, Wisconsin.

AMBIT LAND SURVEYING
P.O. Box 42
Bassett, WI. 53101
414-537-4874

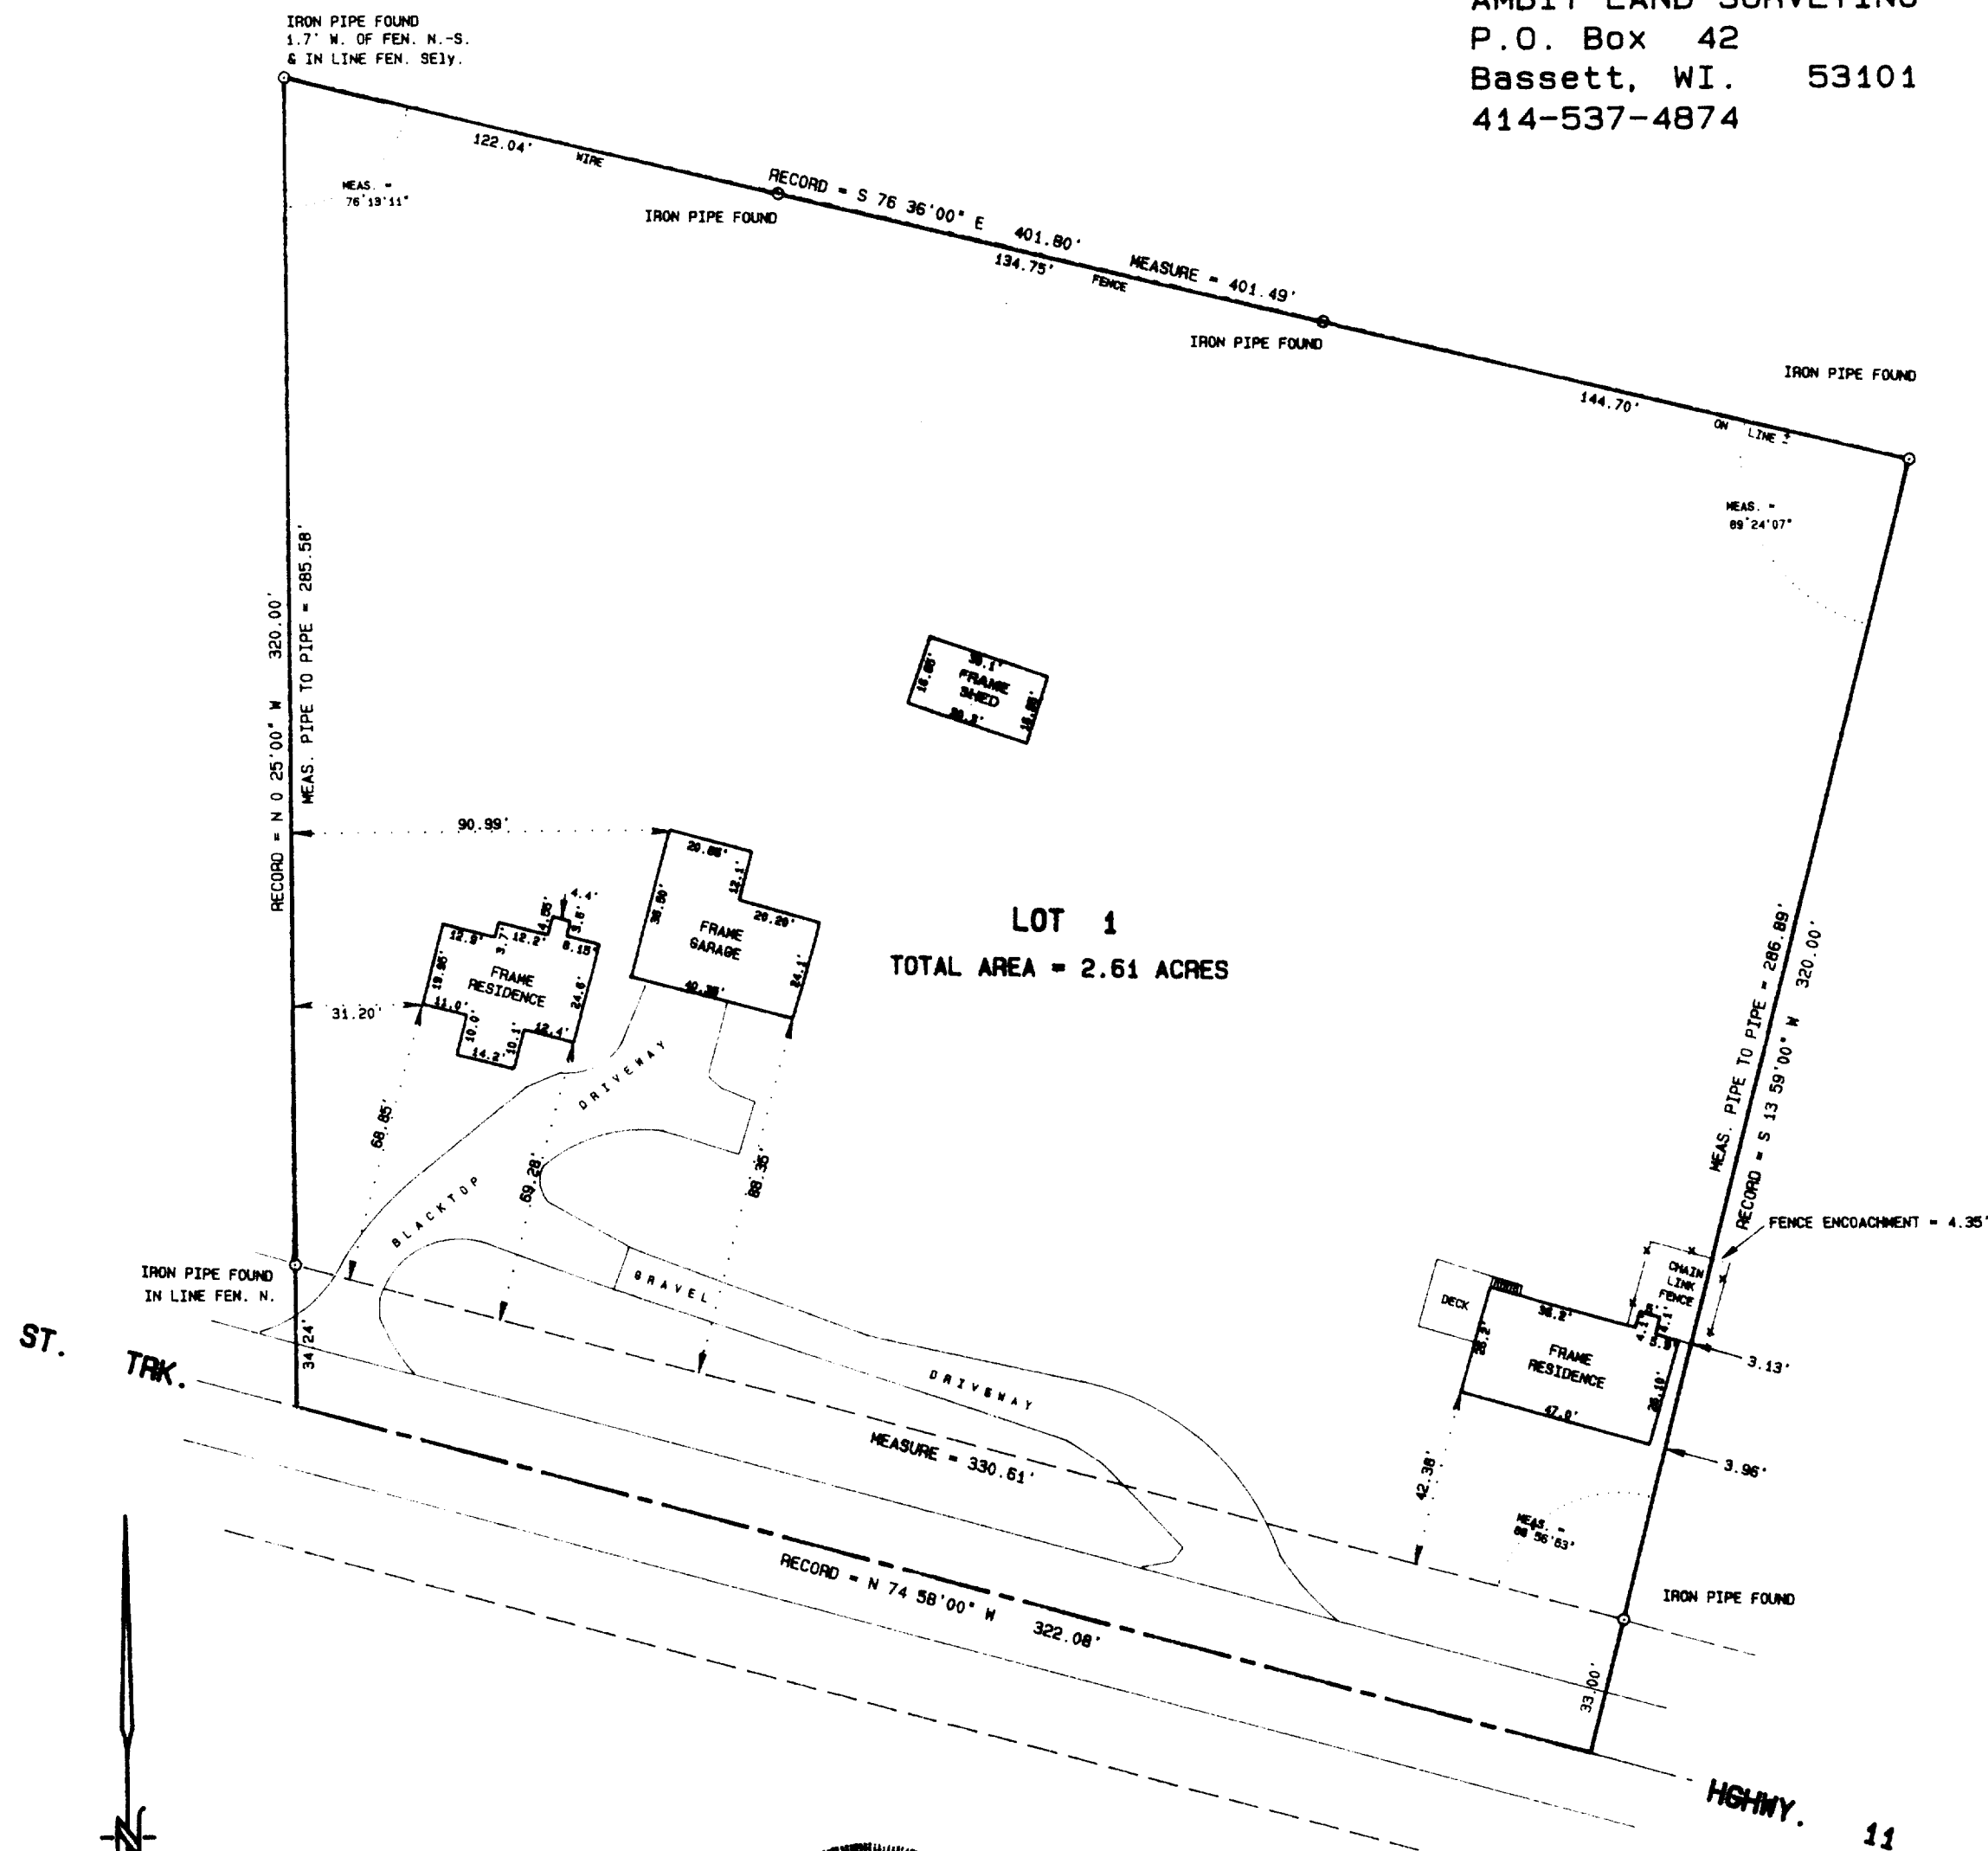


SCALE 1" = 40'
ORDERED BY M. Mathison/RE/MAX Geneva Realty
JOB NO. 91270

I hereby certify that I have surveyed the above described property and the above plat is a true representation thereof and shows the size and location of the property, its exterior boundaries, the location and dimensions of all visible structures thereon, boundary fences, apparent easements and roadways and visible encroachments, if any.

This survey is made for the exclusive use of the present owners of the property, and also those who purchase, mortgage, or guarantee the title thereto within one year from the date hereof.

Dated at Bassett, Wisconsin this 17th day of JANUARY 1992.

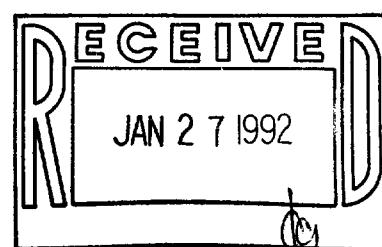

Mark A. Bolender
Mark A. Bolender
Wisconsin Registered Land Surveyor S - 1784

-295

BAS7900001