


ABELL
SURVEYING & MAPPING
 DELAVAN, WISCONSIN 53115
 414-728-8787

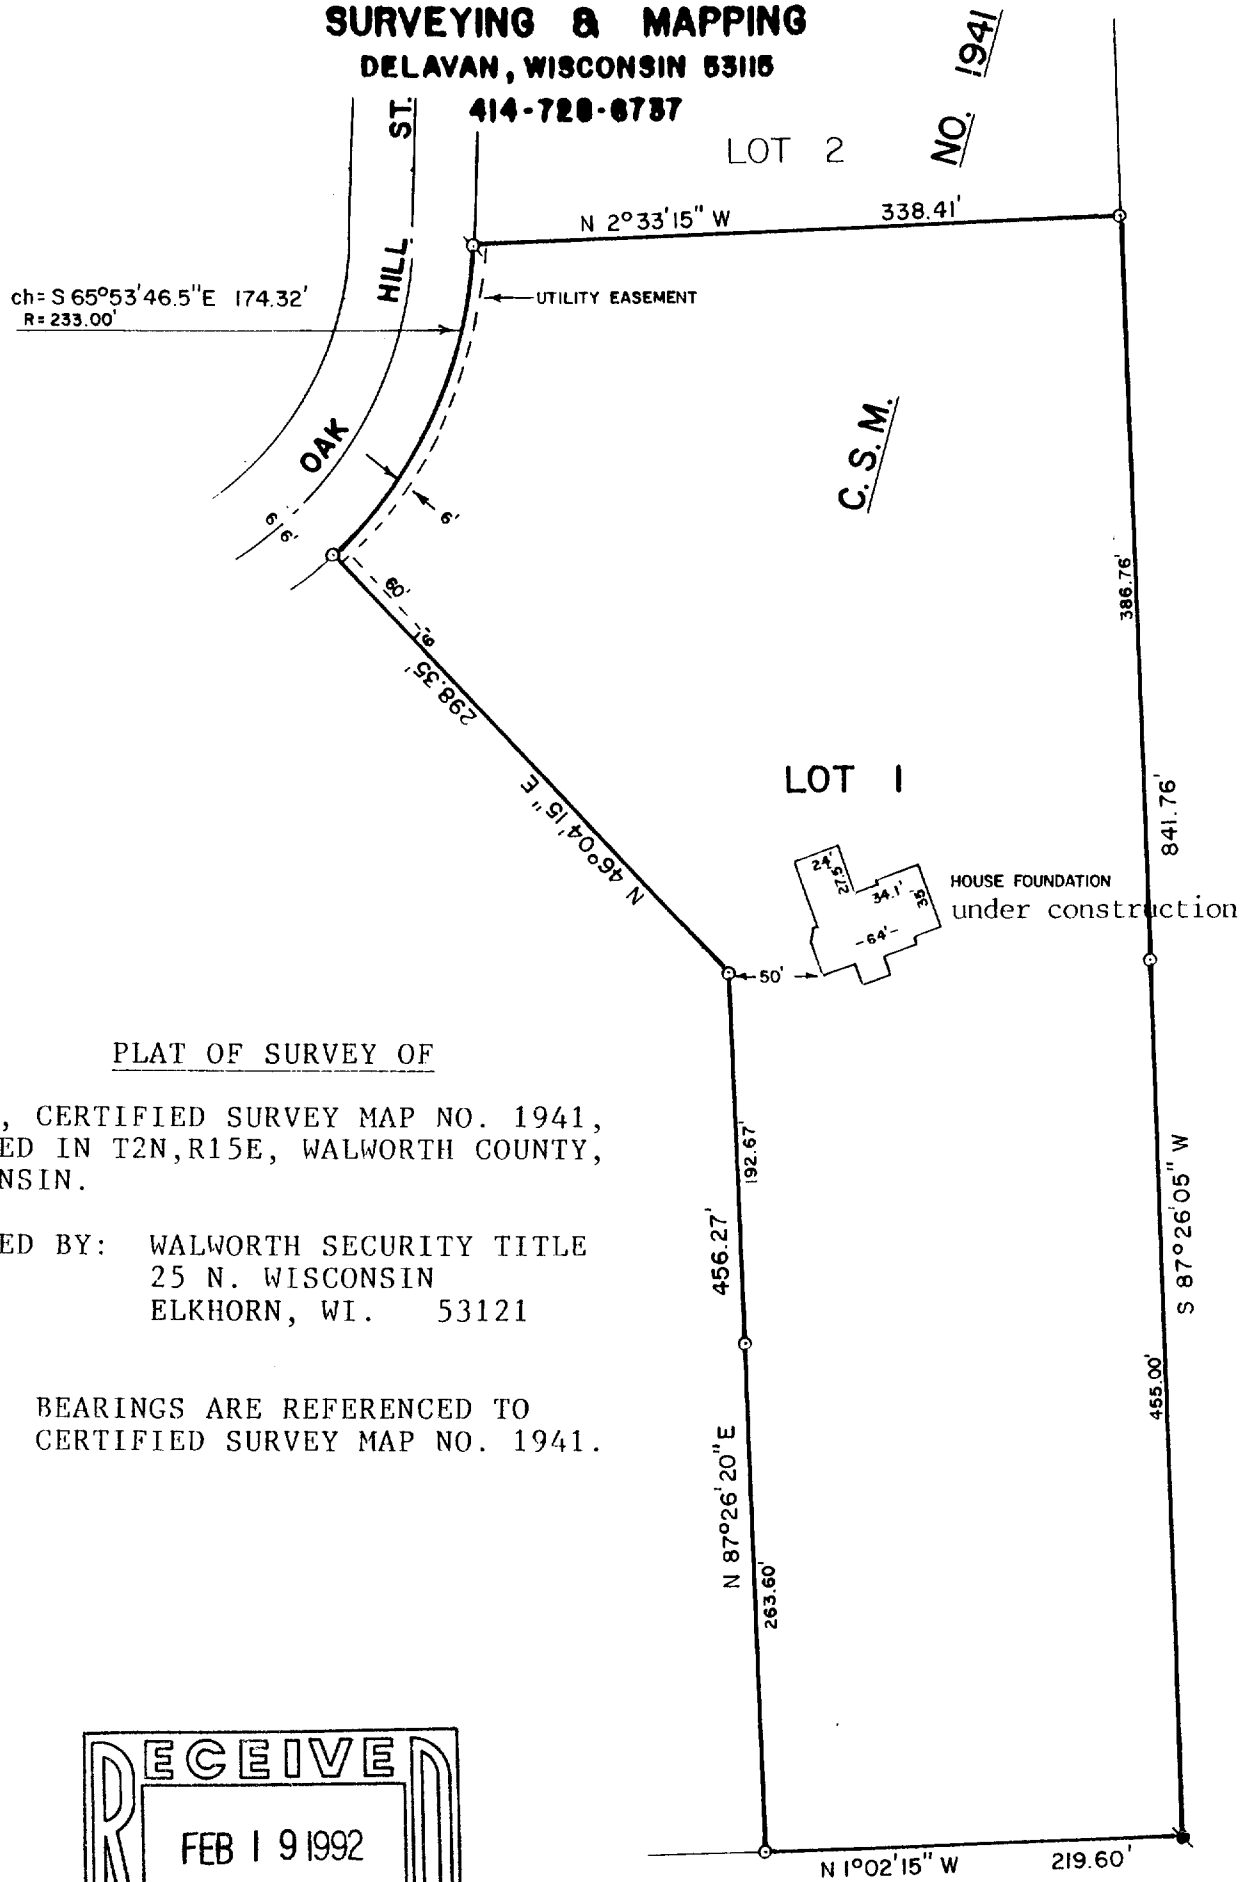


PLAT OF SURVEY OF

LOT 1, CERTIFIED SURVEY MAP NO. 1941,
 LOCATED IN T2N, R15E, WALWORTH COUNTY,
 WISCONSIN.

ORDERED BY: WALWORTH SECURITY TITLE
 25 N. WISCONSIN
 ELKHORN, WI. 53121

NOTE: BEARINGS ARE REFERENCED TO
 CERTIFIED SURVEY MAP NO. 1941.

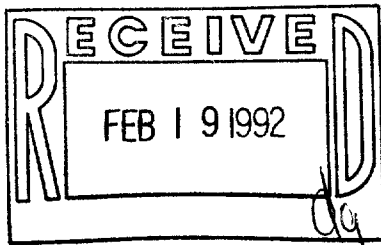

SCALE - 1"=100'

LEGEND

- - IRON ROD FOUND
- - IRON ROD FOUND 1-1/4"
- ⊘ - IRON PIPE FOUND

I HEREBY CERTIFY THAT I HAVE SURVEYED THE ABOVE DESCRIBED PROPERTY AND THAT THE ABOVE MAP IS A TRUE REPRESENTATION THEREOF AND SHOWS THE SIZE AND LOCATION OF THE PROPERTY, ITS EXTERIOR BOUNDARIES, THE LOCATION OF ALL VISIBLE STRUCTURES AND DIMENSIONS OF ALL PRINCIPAL BUILDINGS THEREON, BOUNDARY FENCES, APPARENT EASEMENTS, ROADWAYS AND VISIBLE ENCROACHMENTS, IF ANY, TO THE BEST OF MY KNOWLEDGE AND BELIEF.

THIS SURVEY IS MADE FOR THE USE OF THE PRESENT OWNERS OF THE PROPERTY, AND ALSO THOSE WHO PURCHASE, MORTGAGE, OR GUARANTEE THE TITLE THEREIN WITHIN ONE (1) YEAR FROM DATE HEREOF.

David F. Abell
 DAVID F. ABELL
 WISCONSIN REGISTERED LAND SURVEYOR, S-1596

December 10, 1991

DATE: December 10, 1991 JOB NUMBER: 86065
 NOTE: THIS IS NOT A CERTIFIED COPY UNLESS SEALED.