


DUNHAM SURVEYING, S.C.  
SURVEYING & SUBDIVIDING  
DELAVER, WISCONSIN 53115

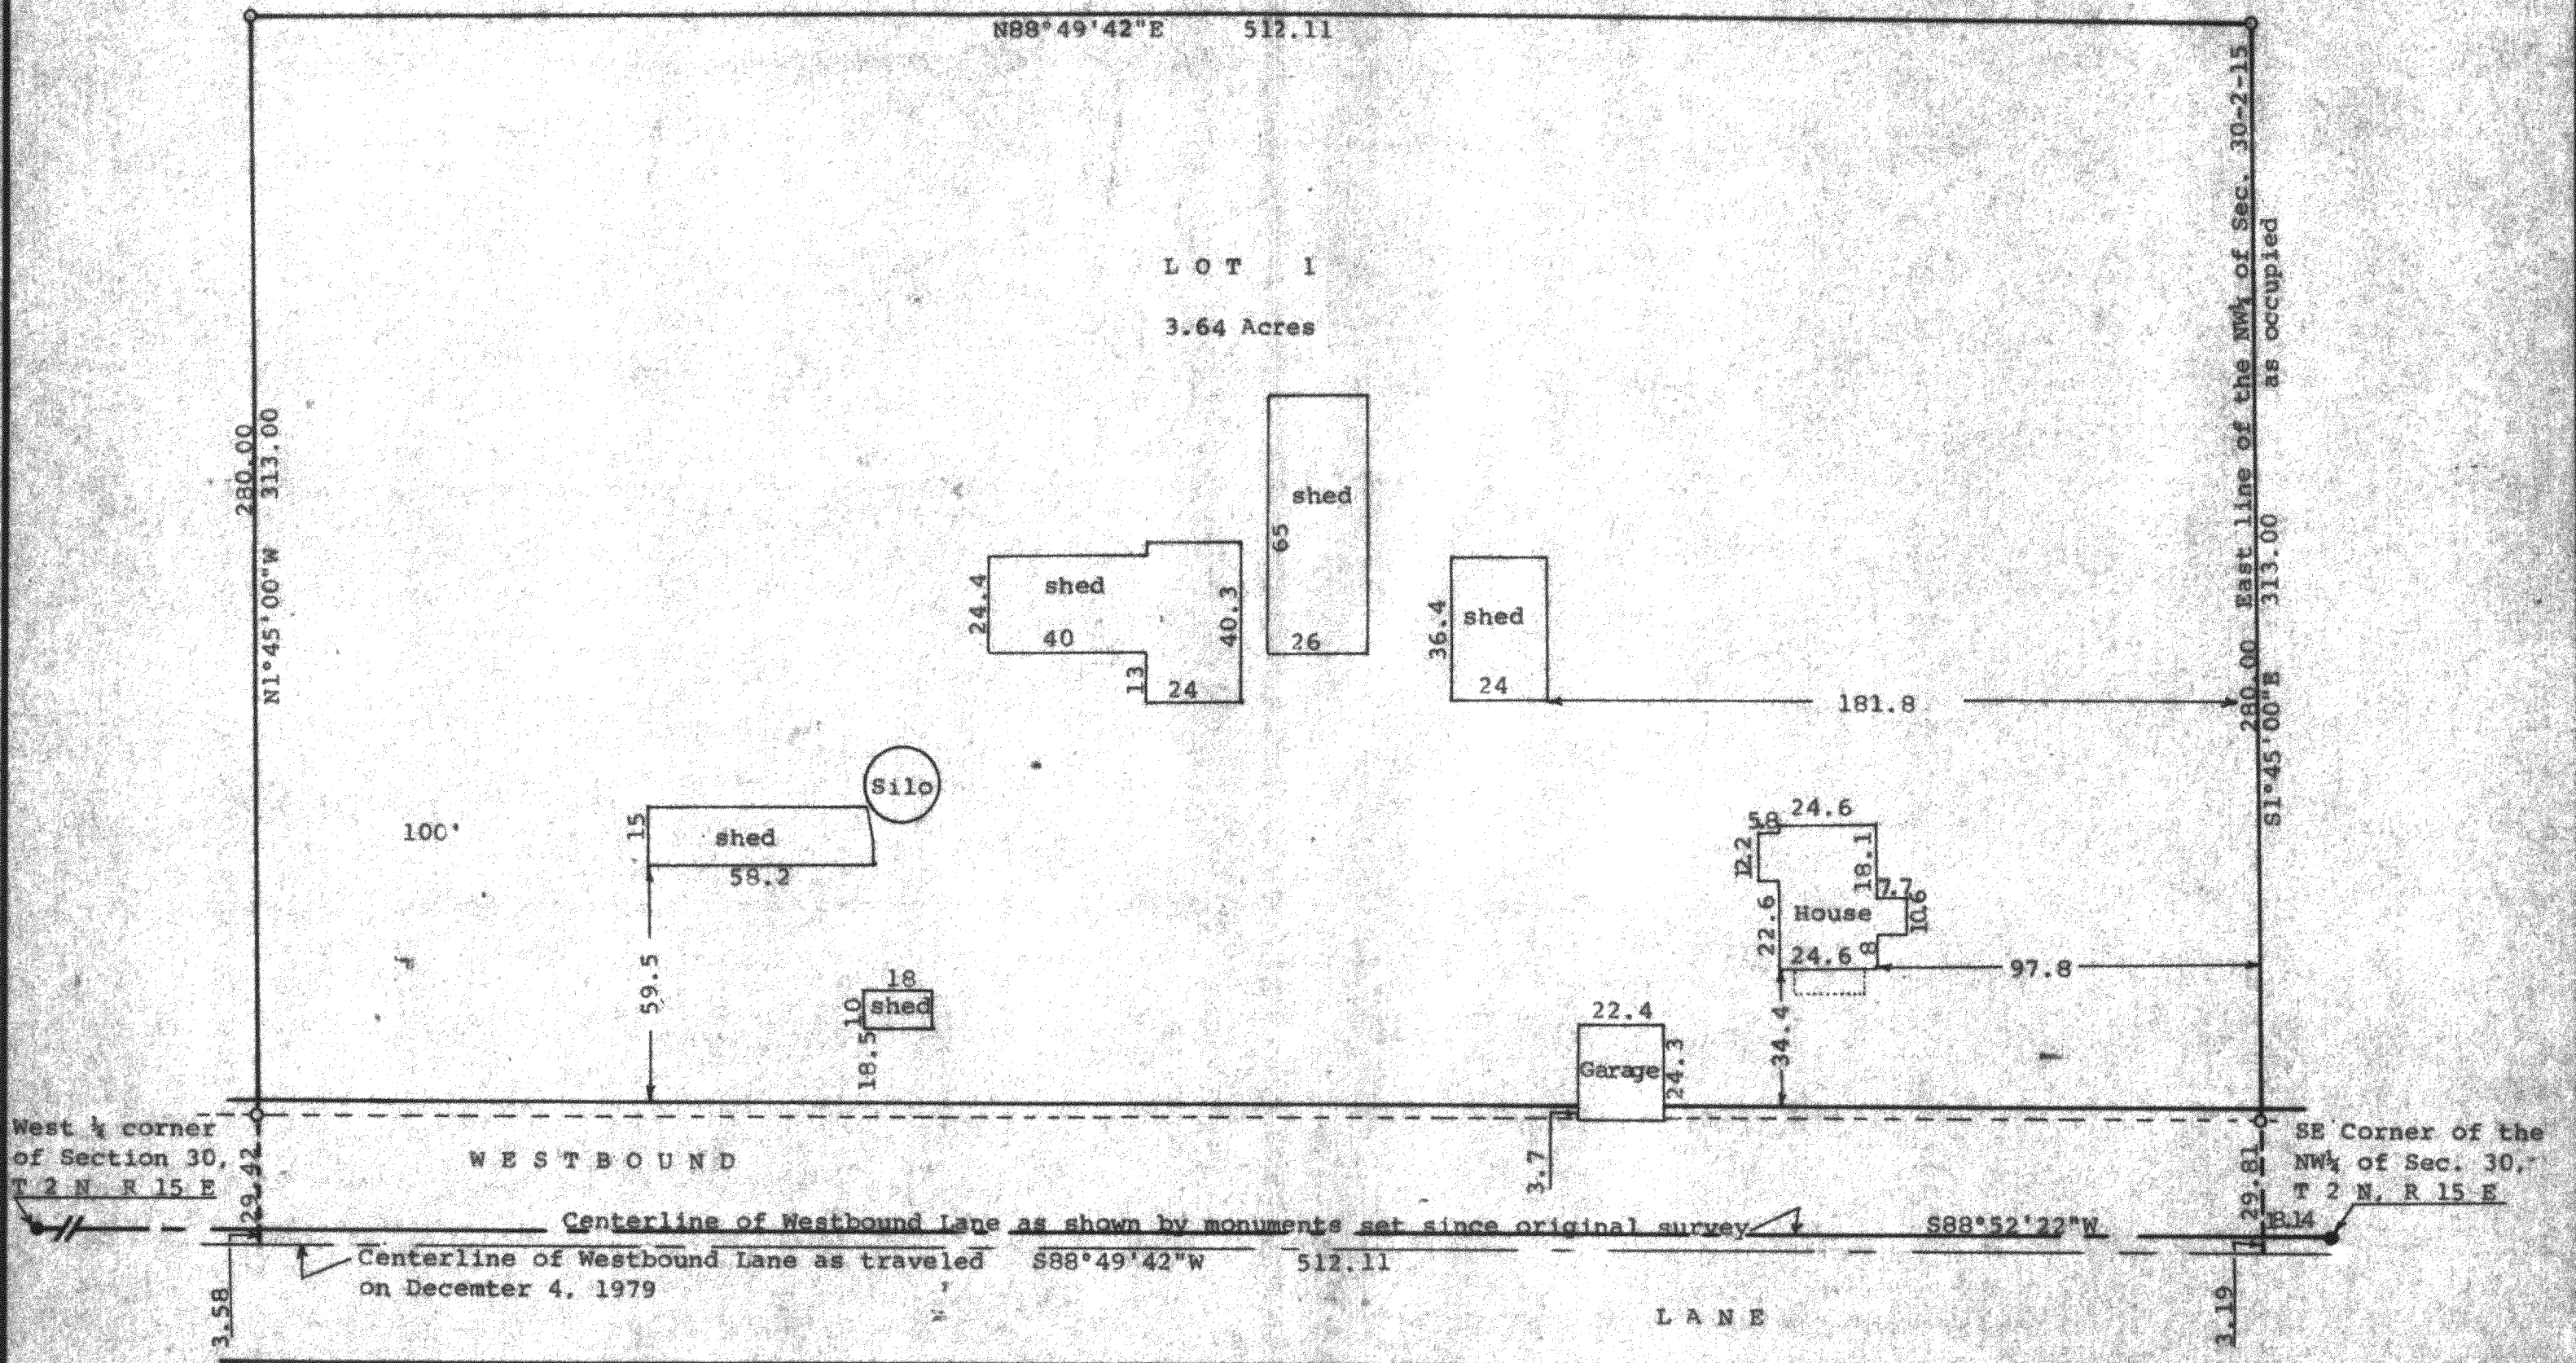



Scale - 1" = 40'  
● = Concrete Monument  
○ = 1" Iron Pipe Found  
Bearings are those on the recorded plat  
of Certified Survey No. 987  
Survey ordered by: The Rauland Agency  
118 Kenosha  
Walworth, WI 53184

STATE OF WISCONSIN  
COUNTY OF WALWORTH

I, George T. Dunham, Surveyor, certify that I have surveyed the  
property described as follows:

Lot 1 of Certified Survey No. 987, recorded in Volume 4 of  
Certified Surveys on Page 254, in the Office of the Register  
of Deeds, Document No. 54331, on December 14, 1979, Elkhorn,  
Wisconsin, being a parcel of land located in the Northwest 1/4  
of Section 30, T 2 N, R 15 E, Walworth County, Wisconsin,  
and that the plat shown hereon is a correct representation thereof and shows  
the size and location of the property, its exterior boundaries, the location  
of all visible structures and dimensions of all principal buildings thereon,  
boundary fences, apparent easements, roadways and visible encroachments, if  
any, and that I have surveyed the property hereondescribed, according to the  
official records, to the best of my knowledge and belief.  
June 15, 1993

*George T. Dunham*  
George T. Dunham, Surveyor

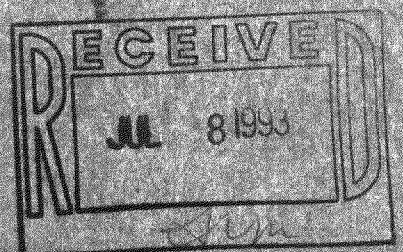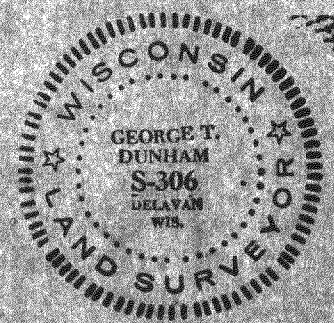

BA-987-1

215-339