


DUNHAM SURVEYING, S.C.
SURVEYING & SUBDIVIDING
DELAVER, WISCONSIN 53115

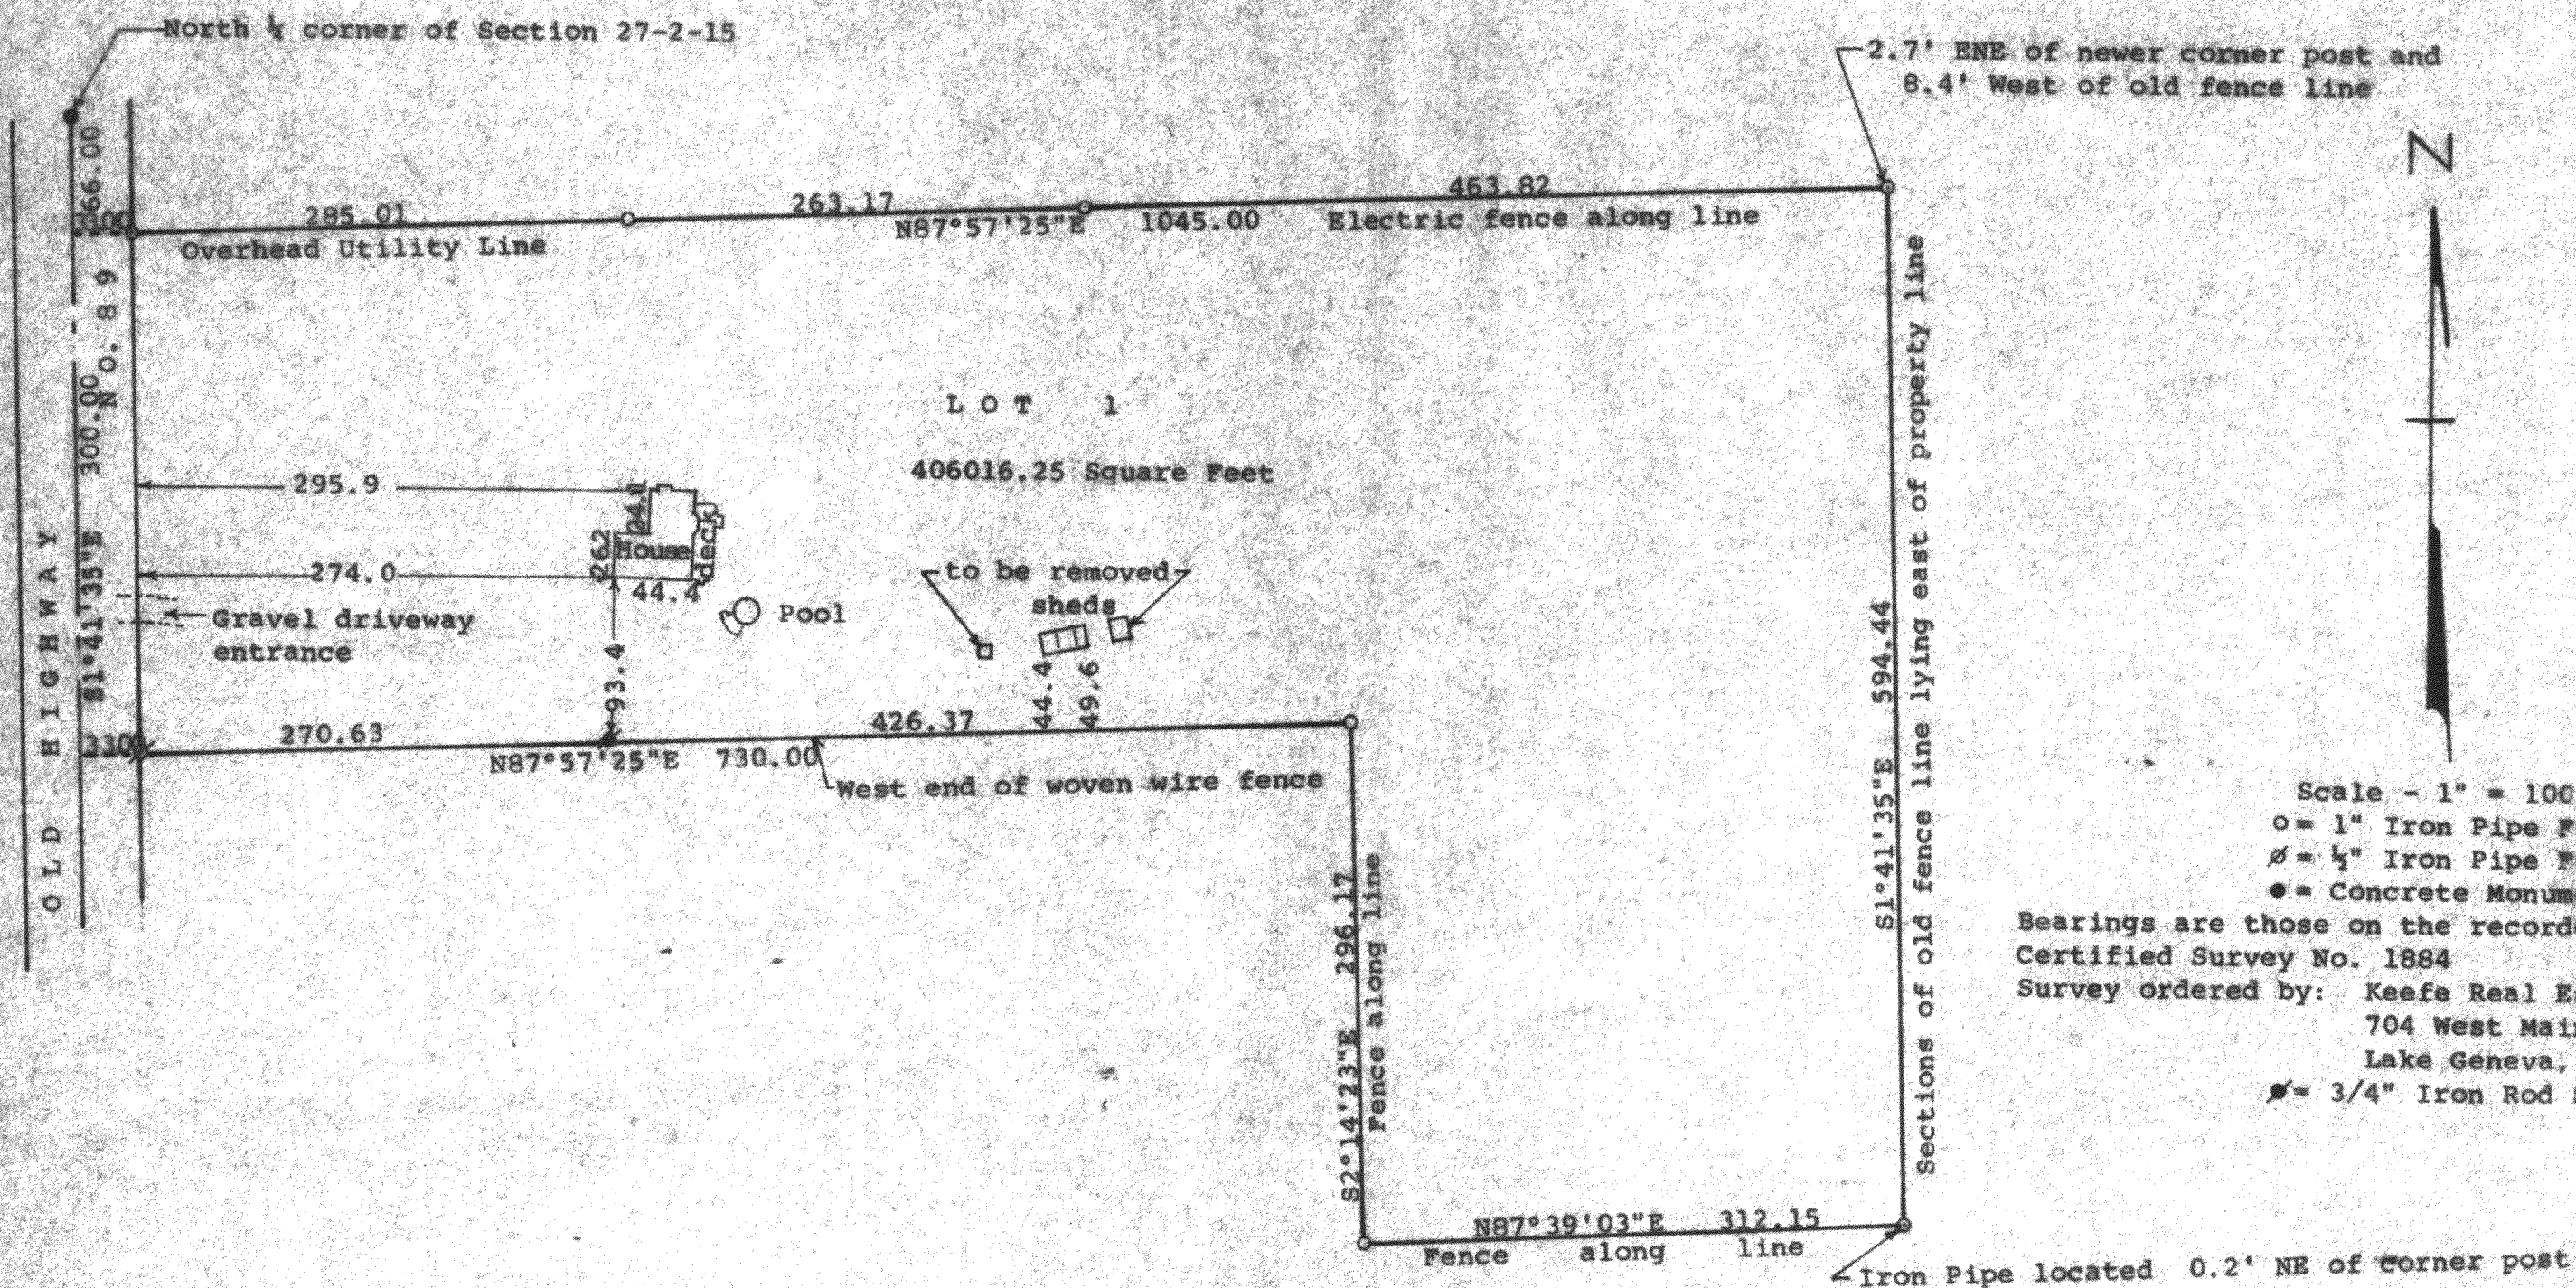



STATE OF WISCONSIN) ss
COUNTY OF WALWORTH)

I, George T. Dunham, Surveyor, certify that I have surveyed the property described as follows:

Lot 1 of Certified Survey No. 1884, recorded in Volume 9 of Certified Surveys, Page 60, Document No. 186180, on November 9, 1989, at the Office of the Register of Deeds, City of Elkhorn, County of Walworth, State of Wisconsin and being a parcel of land located in the North-east 1/4 of Section 27, T 2 N, R 15 E, Walworth County, Wisconsin, and that the plat shown hereon is a correct representation thereof and shows the size and location of the property, its exterior boundaries, the location of all visible structures and dimensions of all principal buildings thereon, boundary fences, apparent easements, roadways and visible encroachments, if any, and that I have surveyed the property hereon described, according to the official records, to the best of my knowledge and belief.

December 2, 1994

George T. Dunham
George T. Dunham, Surveyor

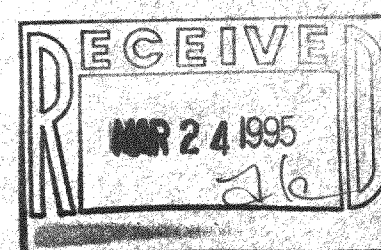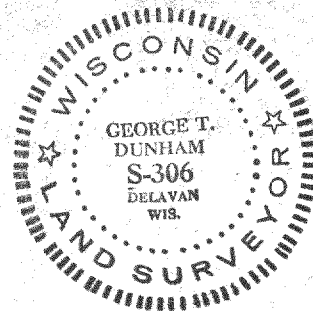

215-367

BA-1884-1