


DUNHAM SURVEYING, S.C.
SURVEYING & SUBDIVIDING
DELAVAL, WISCONSIN 53115

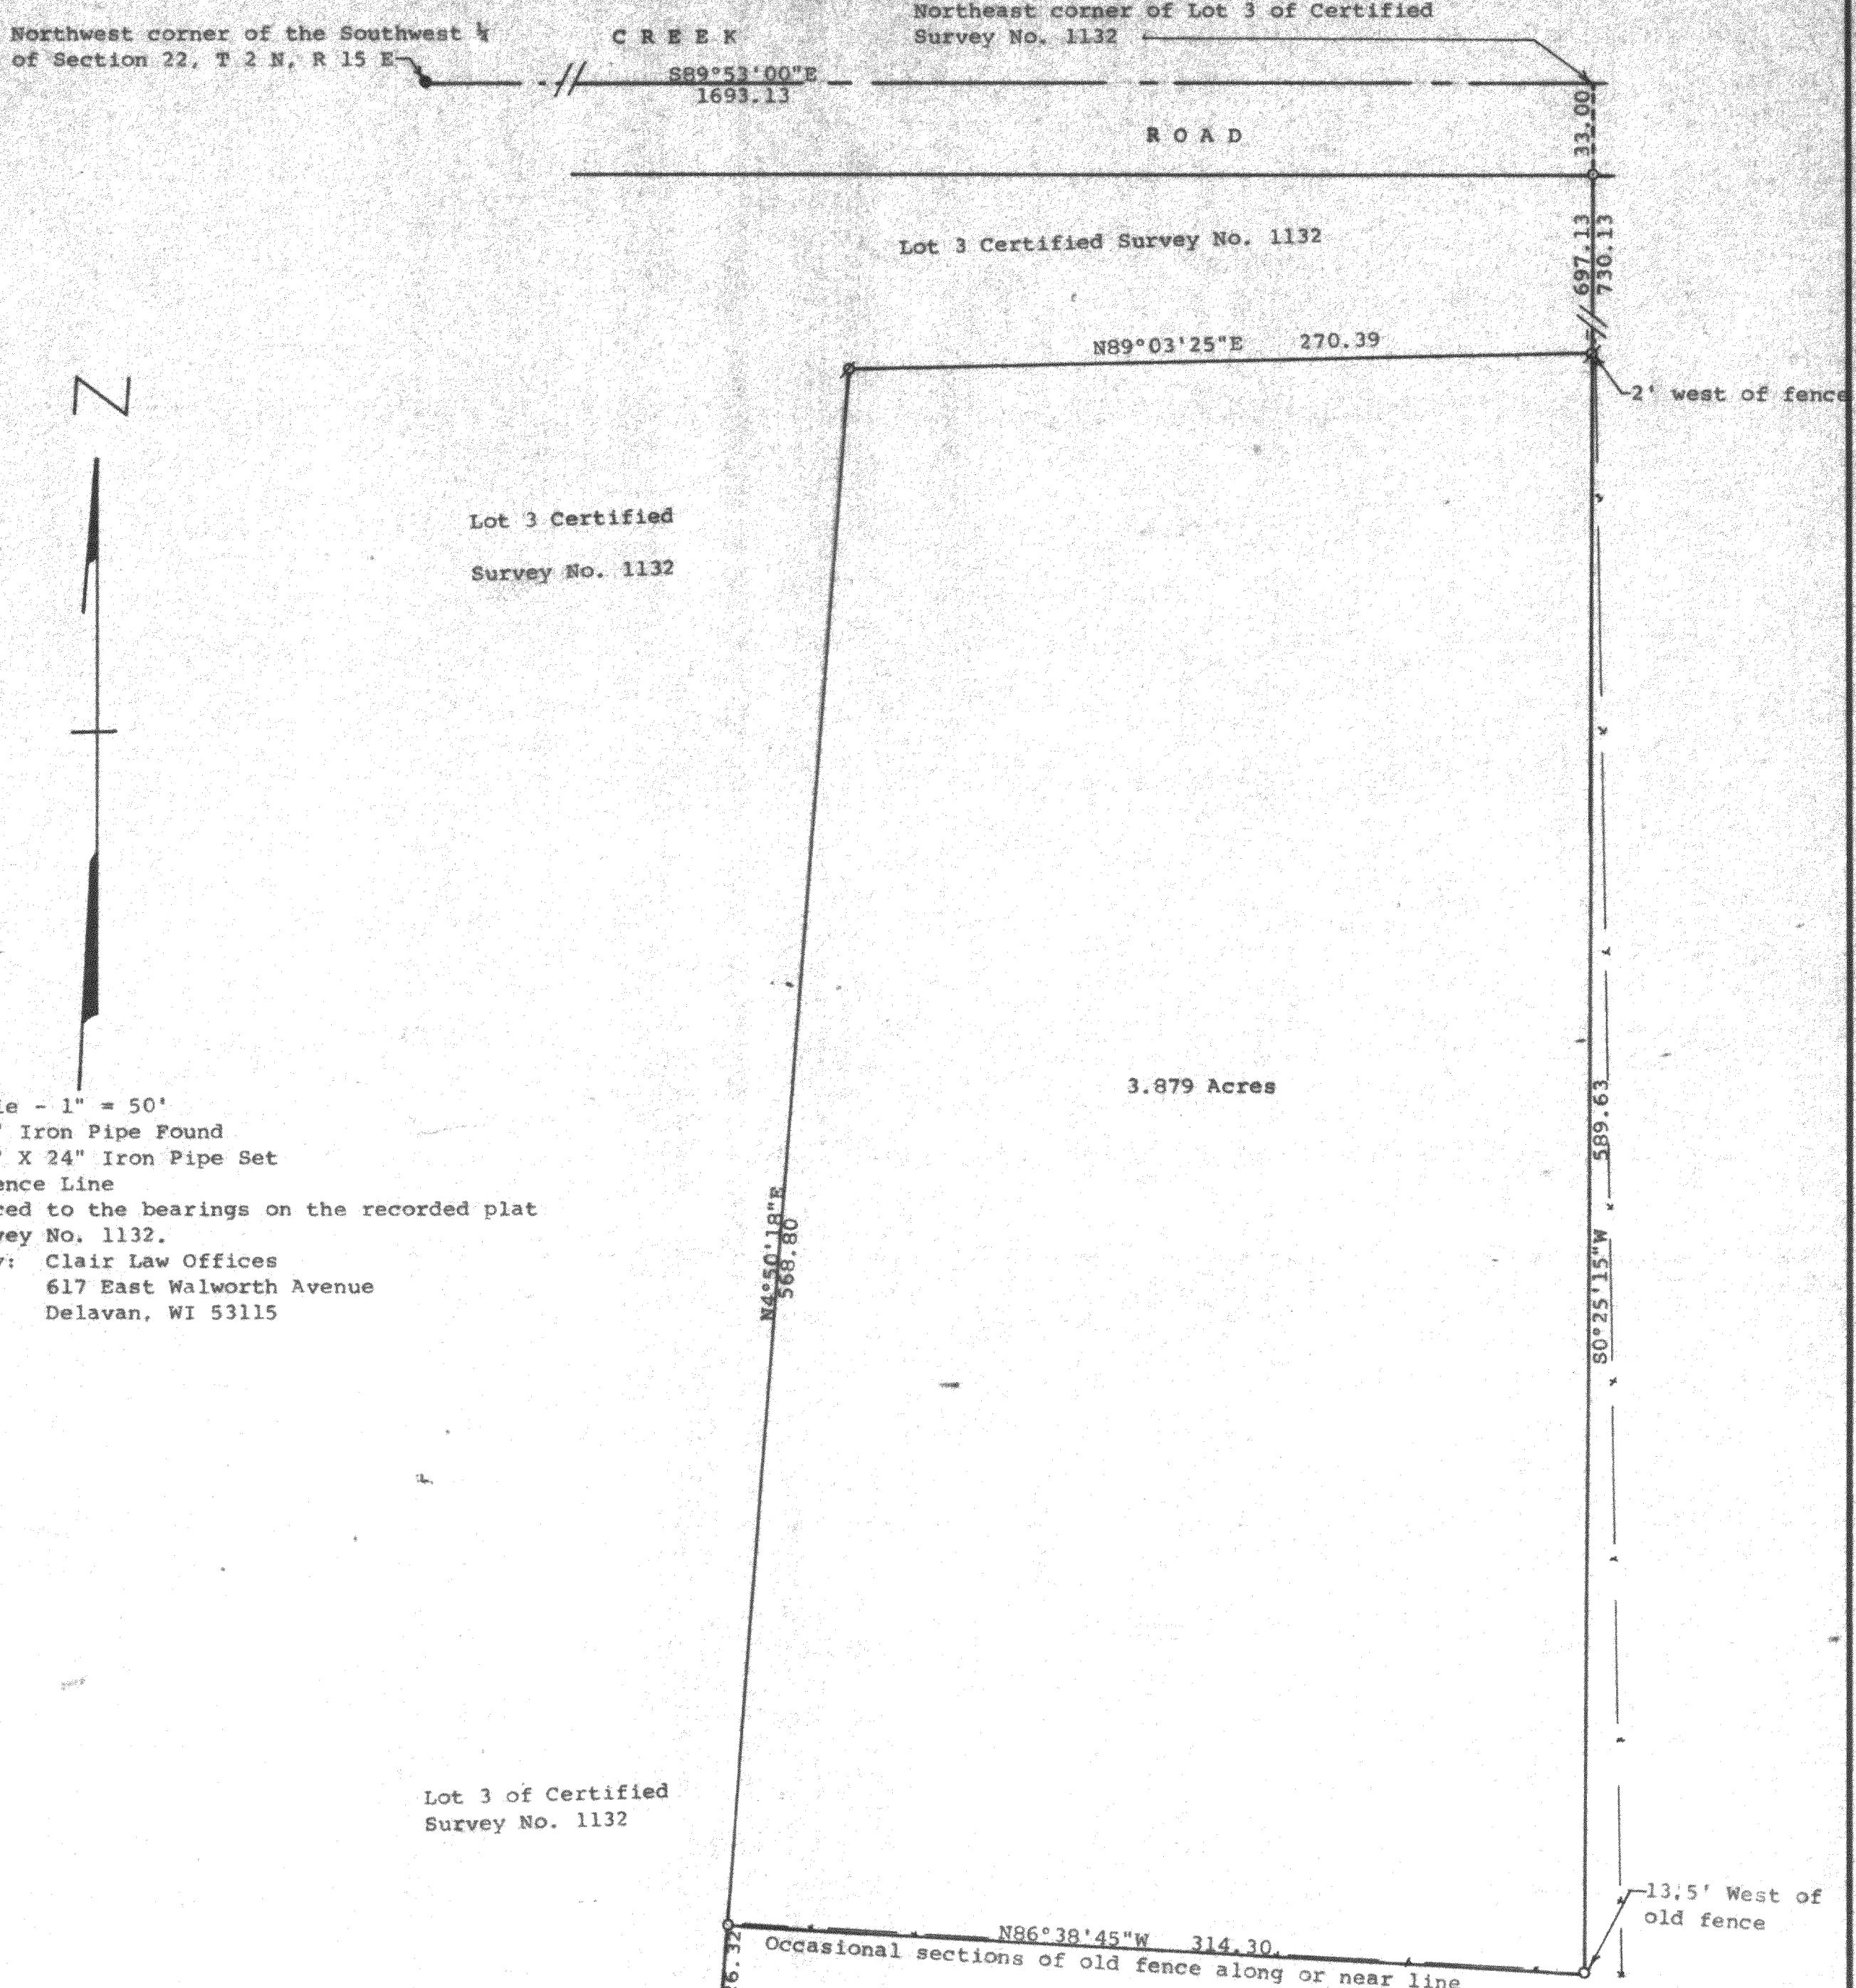

STATE OF WISCONSIN) ss
COUNTY OF WALWORTH)



I, George T. Dunham, Surveyor, certify that I have surveyed the property described as follows:

A parcel of land located in the Southwest $\frac{1}{4}$ of Section 22, T 2 N, R 15 E, Walworth County, Wisconsin, described as follows: Commencing at the northwest corner of said Southwest $\frac{1}{4}$; thence S89°53'00"E along the north line of said Southwest $\frac{1}{4}$, 1693.13 feet to the northeast corner of Lot 3 of Certified Survey No. 1132, recorded in Volume 5 of Certified Surveys, Pages 165 and 166, Document No. 68225, in the Office of the Register of Deeds, Walworth County, Wisconsin; thence 80°25'15"W along the east line of said certified survey, 730.13 feet to the place of beginning; thence continue 80°25'15"W 589.63 feet; thence N86°38'45"W, 314.30 feet to the easterly line of Lot 3 of said Certified Survey No. 1132; thence N4°50'18"E along said easterly line 568.80 feet; thence N89°03'25"E along the southerly line of said Lot 3, 270.39 feet to the place of beginning containing 3.879 acres of land more or less. (Said survey and description are prepared for a lot line adjustment and not for creating a new building site.)

and that the plat shown hereon is a correct representation thereof and shows the size and location of the property, its exterior boundaries, the location of all visible structures and dimensions of all principal buildings thereon, boundary fences, apparent easements, roadways and visible encroachments, if any, and that I have surveyed the property hereon described, according to the official records, to the best of my knowledge and belief.

September 24, 1993

George T. Dunham
George T. Dunham, Surveyor

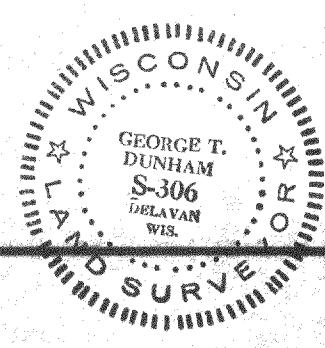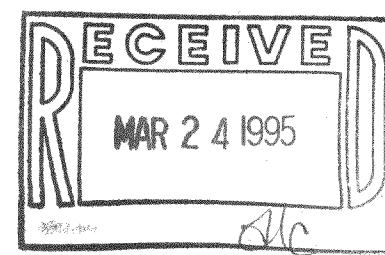

BA 1132-1

GMB 1020

215-378