


PLAT OF SURVEY

LOTS 36 AND 37 ALSO LOTS 1 THROUGH 8 INCLUSIVE IN BLOCK 2 IN
SIDNEY ALLEN'S ADDITION TO THE VILLAGE OF ALLEN'S GROVE, BEING A
SUBDIVISION IN THE SOUTH PART OF THE EAST HALF OF THE SOUTHWEST
QUARTER AND ALSO THE SOUTH PART OF THE WEST HALF OF THE SOUTHEAST
QUARTER OF SECTION 31, TOWNSHIP 2 NORTH, RANGE 15 EAST OF THE
FOURTH PRINCIPAL MERIDIAN, IN WALWORTH COUNTY, WISCONSIN.

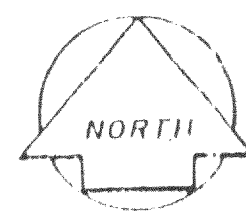

SCALE:
1 inch equals 30 feet



State of Wisconsin)
County of Walworth) 5.5.

I, Charles E. Smith, do hereby state that I have surveyed the
property described hereon, and that the above map is a true
representation thereof and shows the size and location of the
property, its exterior boundaries, the location of all visible
structures and dimensions of all principal buildings thereon,
boundary fences, apparent easements, roadways and visible
encroachments, if any, and that I have surveyed the property
hereon described according to the official records, to the best
of my knowledge and belief.

May 30, 1995

Charles E. Smith

Charles E. Smith, Wisconsin
Registered Land Surveyor No. 5-1038

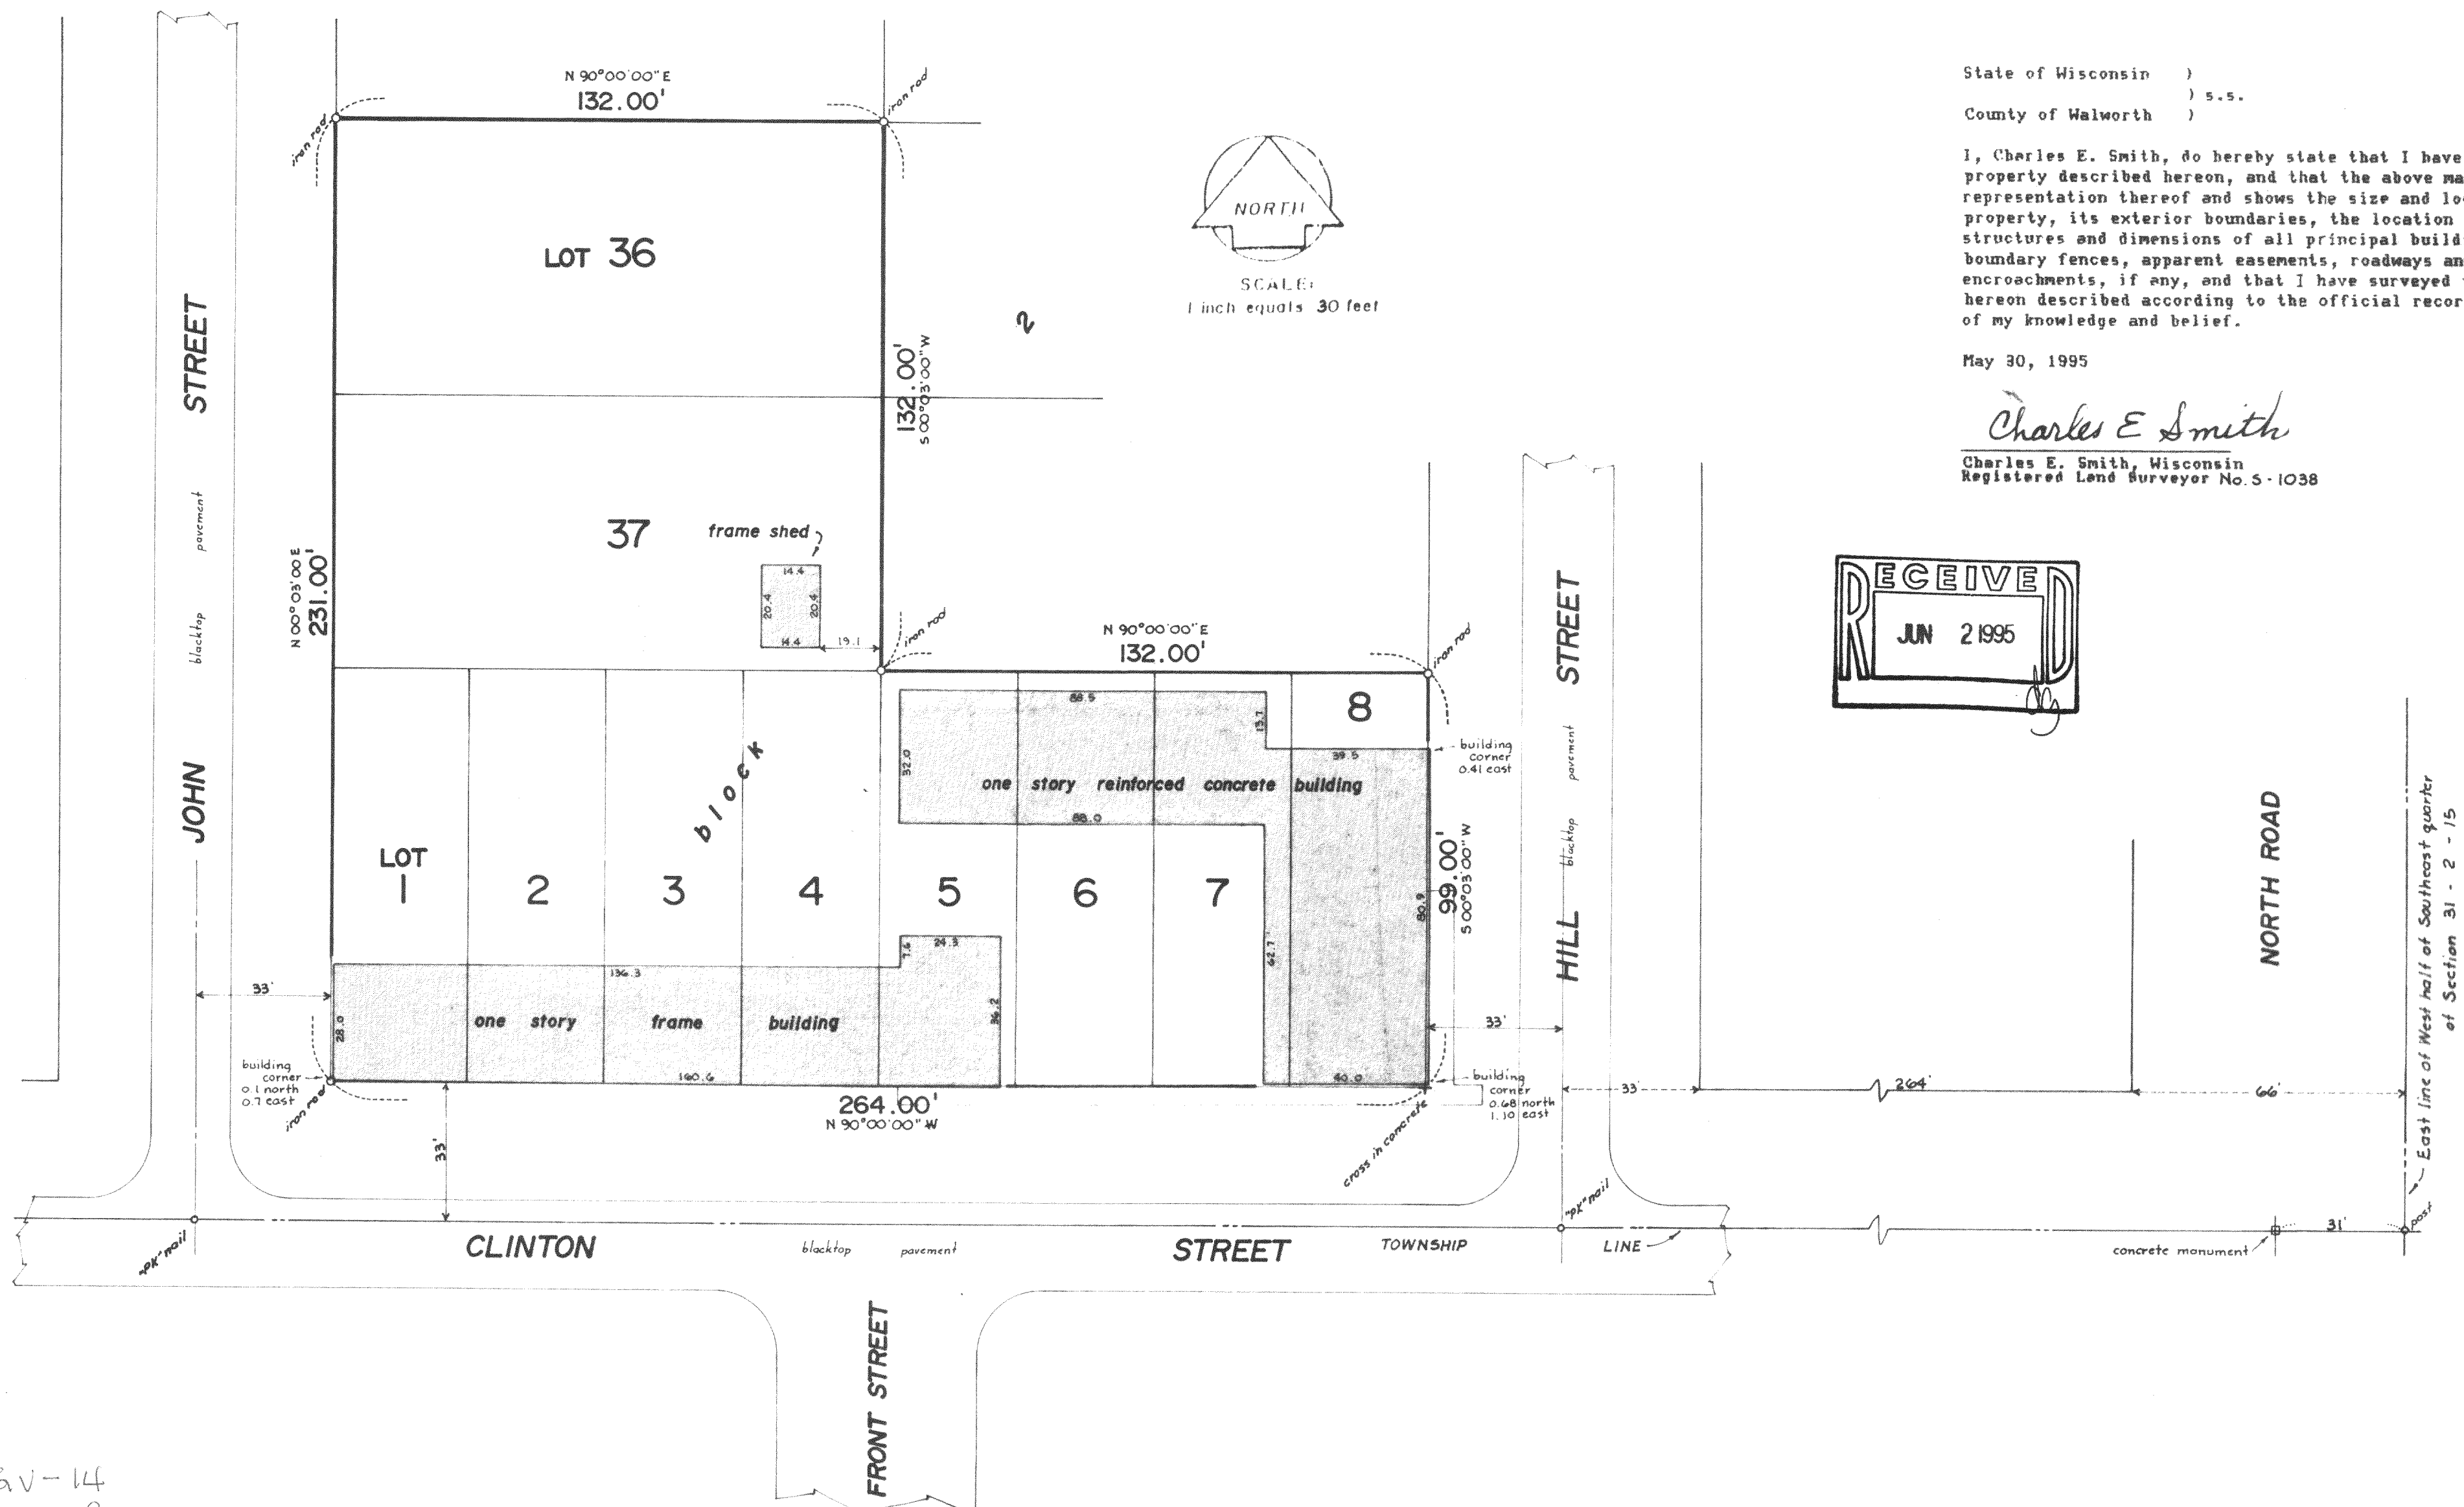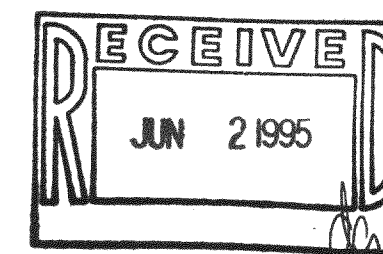

BAGV-14
BAGV-8
BAGV-9