
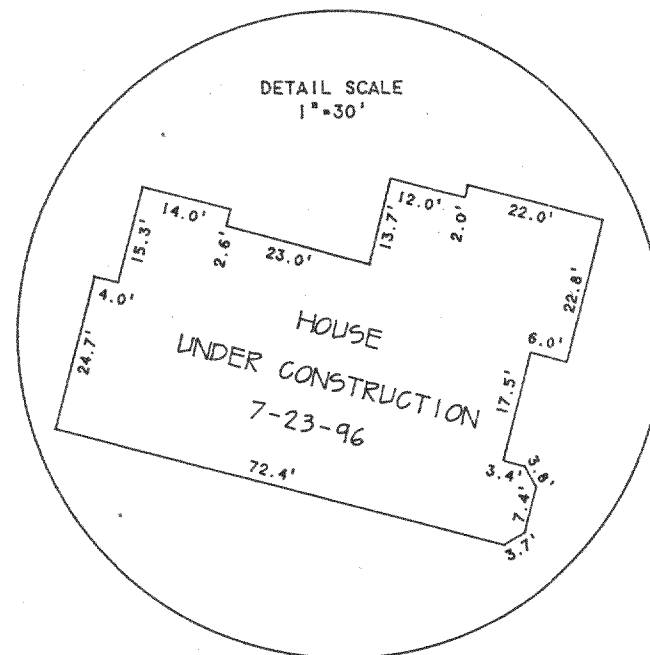


ABELL
SURVEYING & MAPPING
DELAVAN, WISCONSIN 53115
414-728-6737

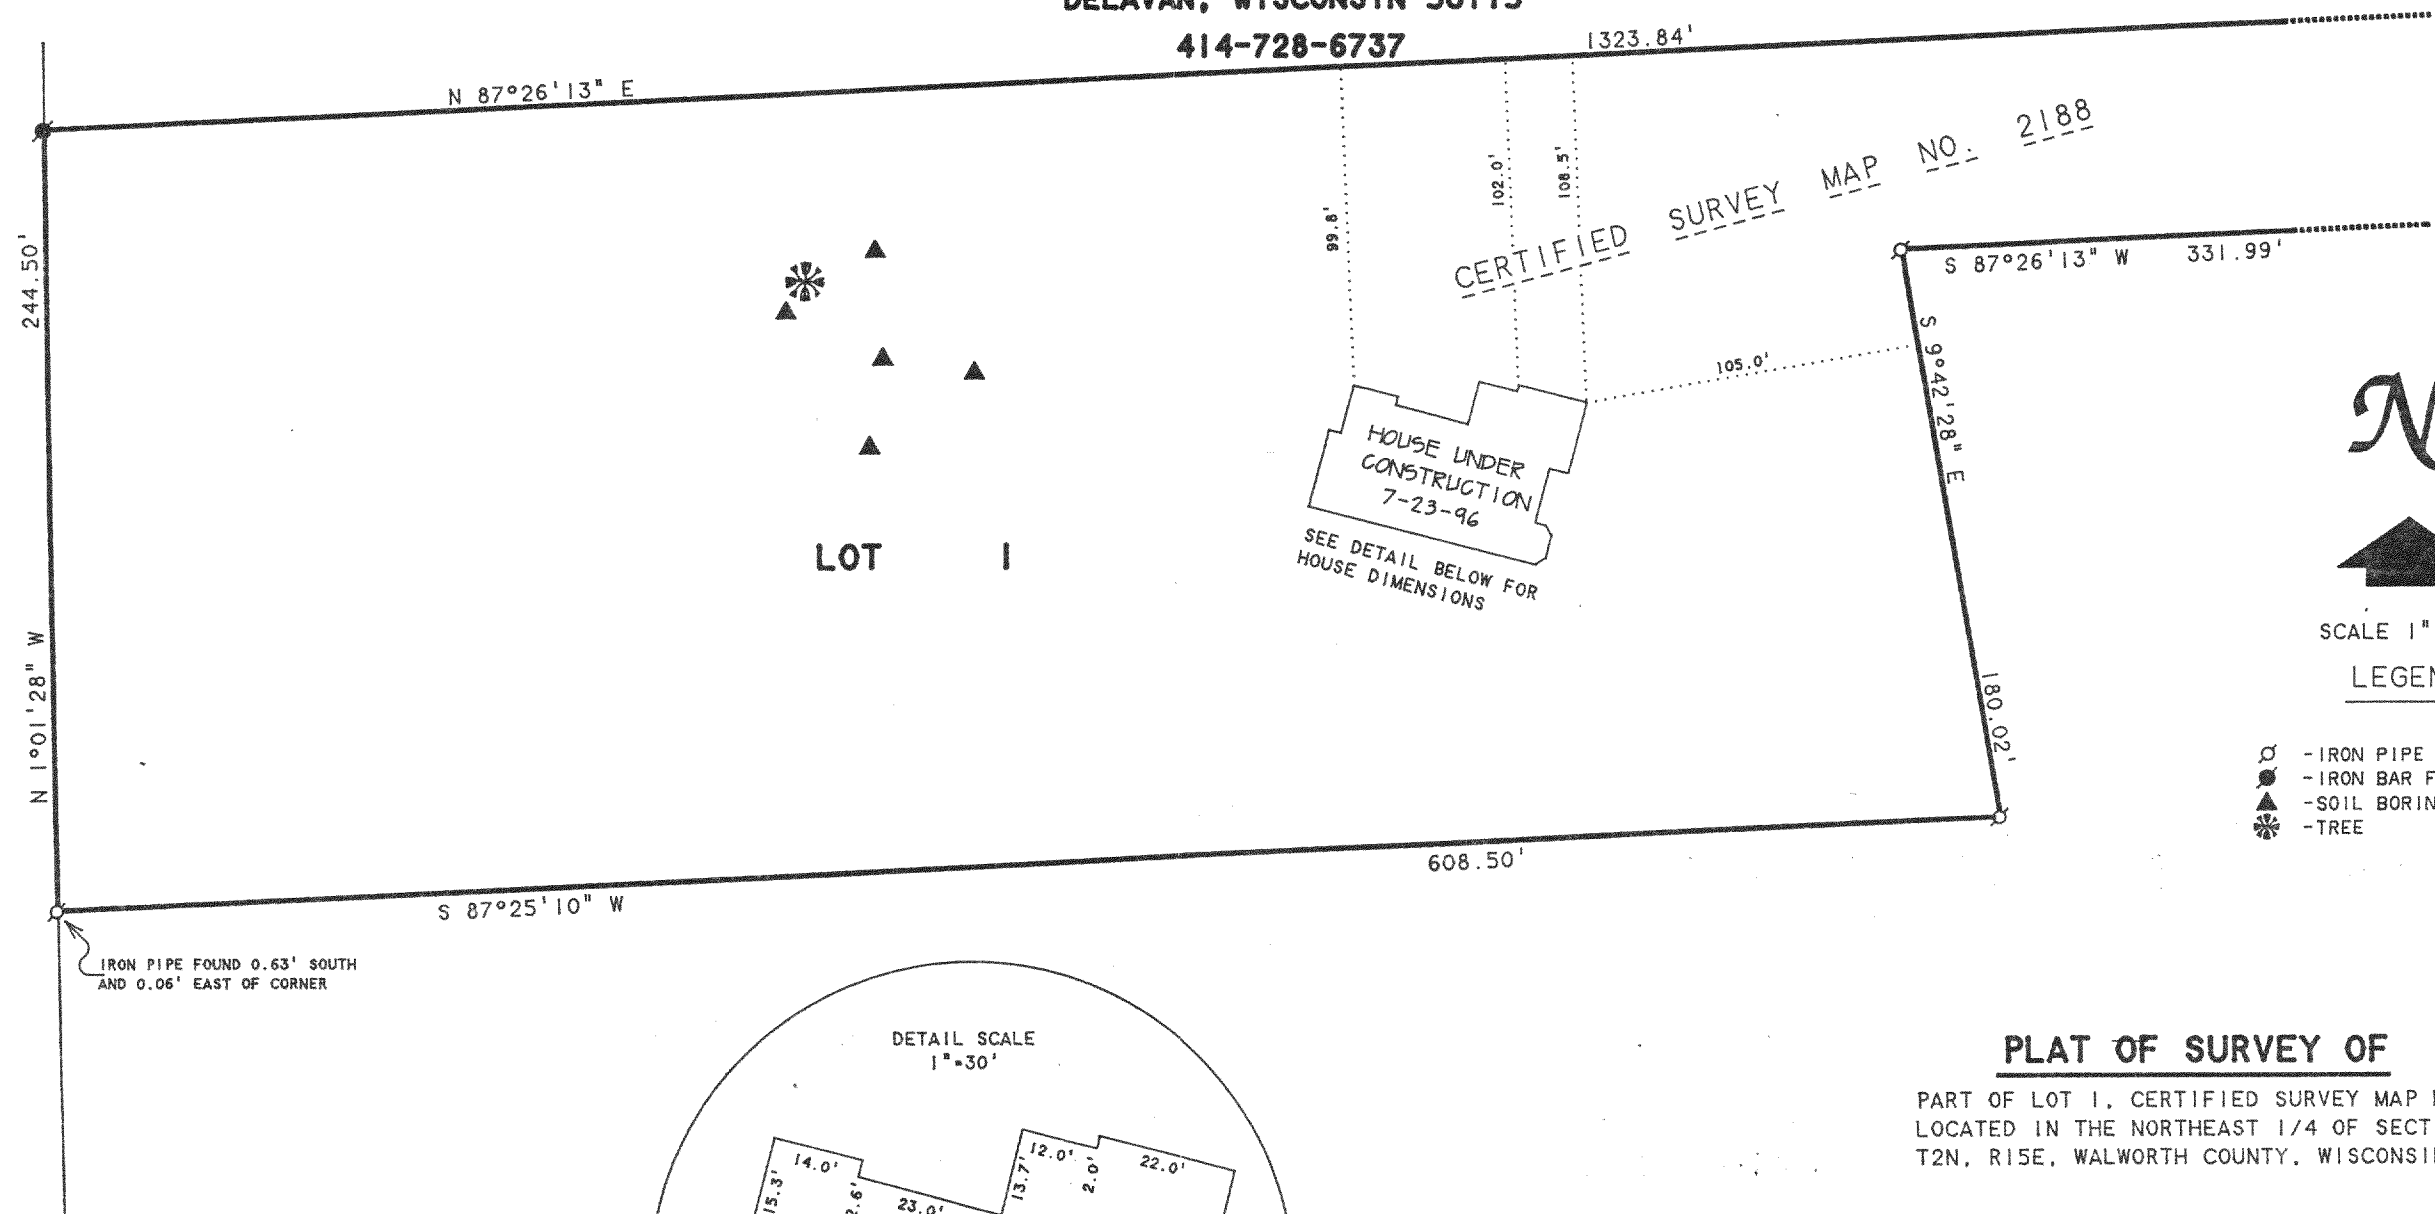

PLAT OF SURVEY OF

PART OF LOT 1, CERTIFIED SURVEY MAP NO. 2188,
LOCATED IN THE NORTHEAST 1/4 OF SECTION 22,
T2N, R15E, WALWORTH COUNTY, WISCONSIN.

I, DAVID F. ABELL, DO HEREBY CERTIFY THAT I HAVE SURVEYED THE PROPERTY HEREON DESCRIBED ACCORDING TO THE OFFICIAL RECORDS AND THAT THE PLAT HEREON IS A CORRECT REPRESENTATION OF THE PROPERTY LINES TO THE BEST OF MY KNOWLEDGE AND BELIEF.


David F. Abell

DAVID F. ABELL
WISCONSIN REGISTERED LAND SURVEYOR, S-1596

April 30, 1996

DATE: April 30, 1996 JOB NUMBER - 92153
NOTE: THIS IS NOT A CERTIFIED COPY UNLESS SEALED.

215-413

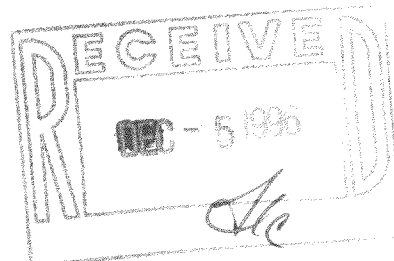

BA-2188-1