


1140 SEQUOIA STREET • DELAVAN, WISCONSIN 53115
414-728-6737

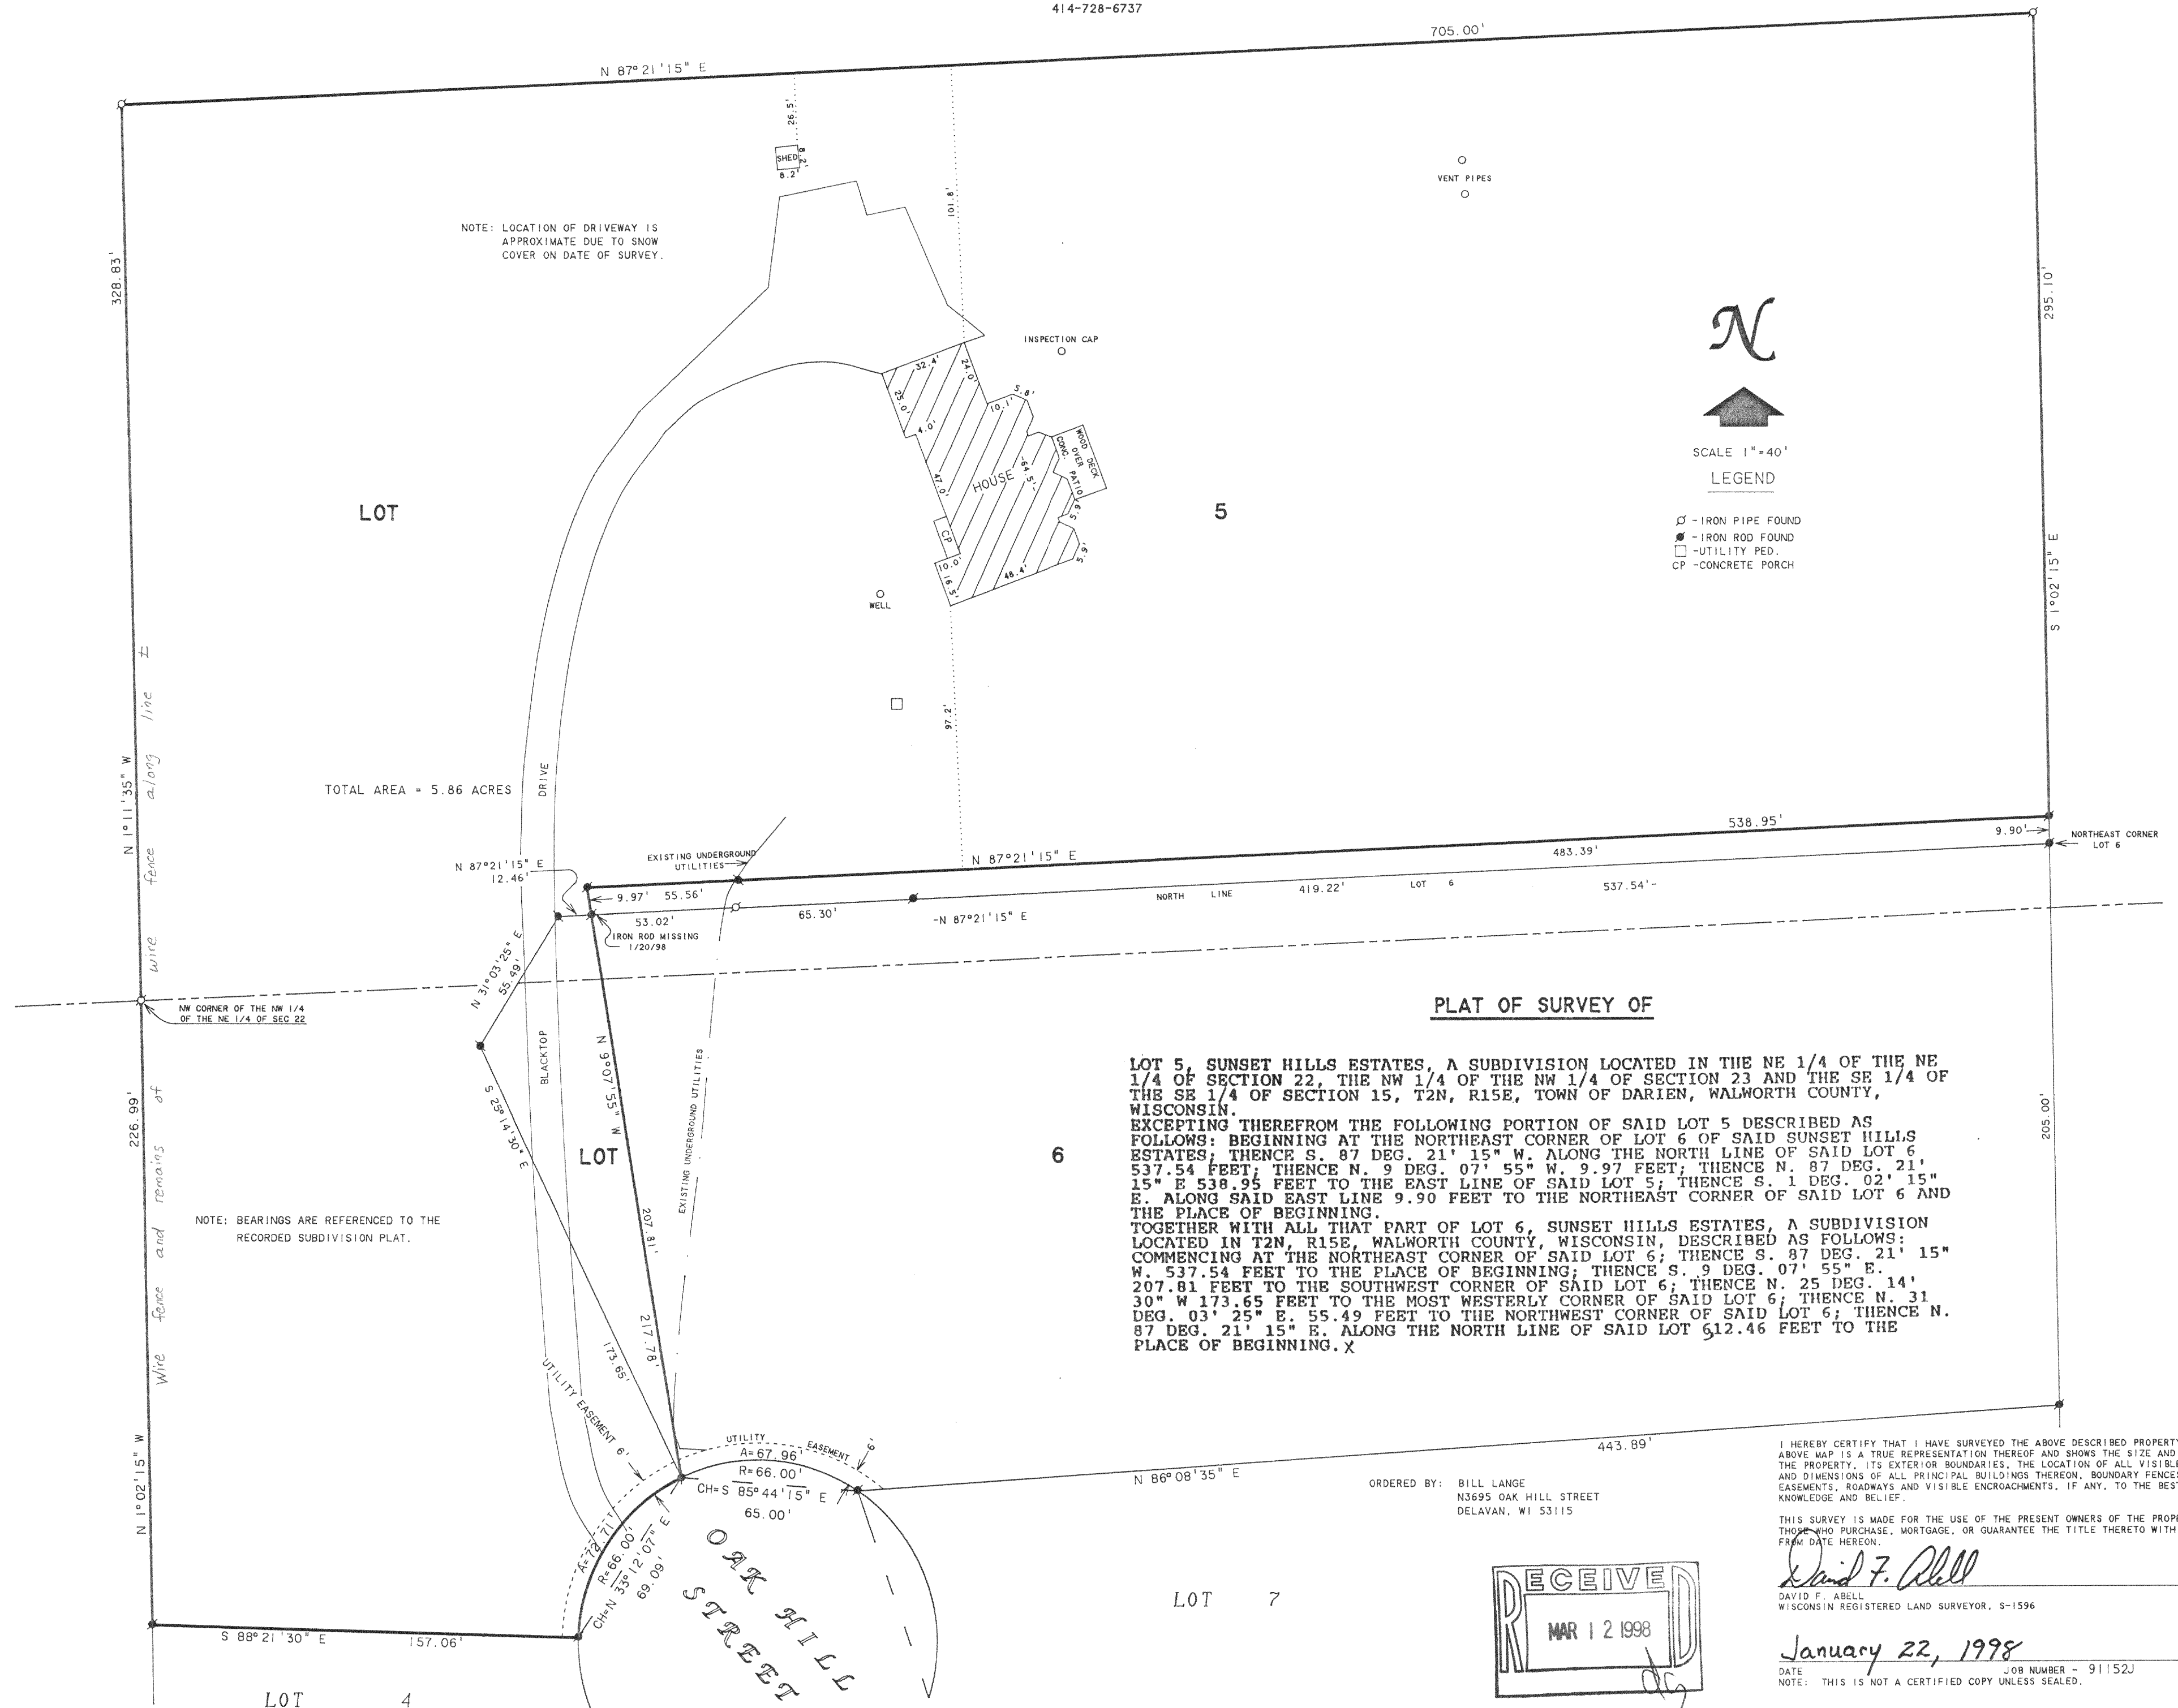

3SU-5
215-437