

ABERNATHY and ASSOCIATES

Kenneth B. Abernathy Jr.

Wisconsin Registered Land Surveyor S-1594



Rt. 3, Box 273
Elkhorn, Wisconsin 53121
Phone: (414) 723-4260 (office)
(414) 723-7209 (FAX)

PLAT OF SURVEY

LOT 1 OF CERTIFIED SURVEY
MAP NO. 1223 AS RECORDED IN
VOL. 5 P. 327 AS DOCUMENT
NO. 78861, LOCATED IN THE
WEST 1/2 OF THE NORTHEAST
1/4 OF SECTION 15, TOWN 2
NORTH, RANGE 15 EAST,
WALWORTH COUNTY, WISCONSIN.


OWNERS: WARREN AND KATHLEEN GILBERT
1009 S. MAIN ST.
FORT ATKINSON, WI. 53538

ORDERED BY: SKANDIA REALTY, INC.
822 E. GENEVA
DELAVER, WI. 53115

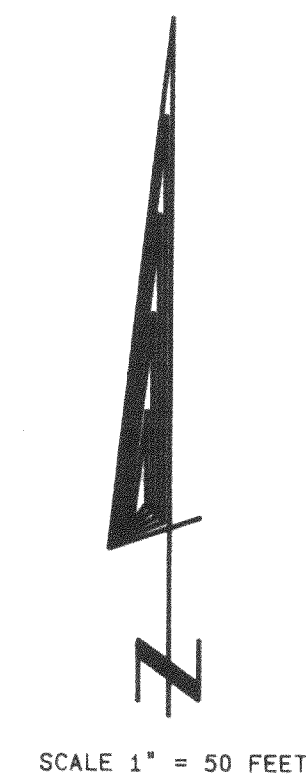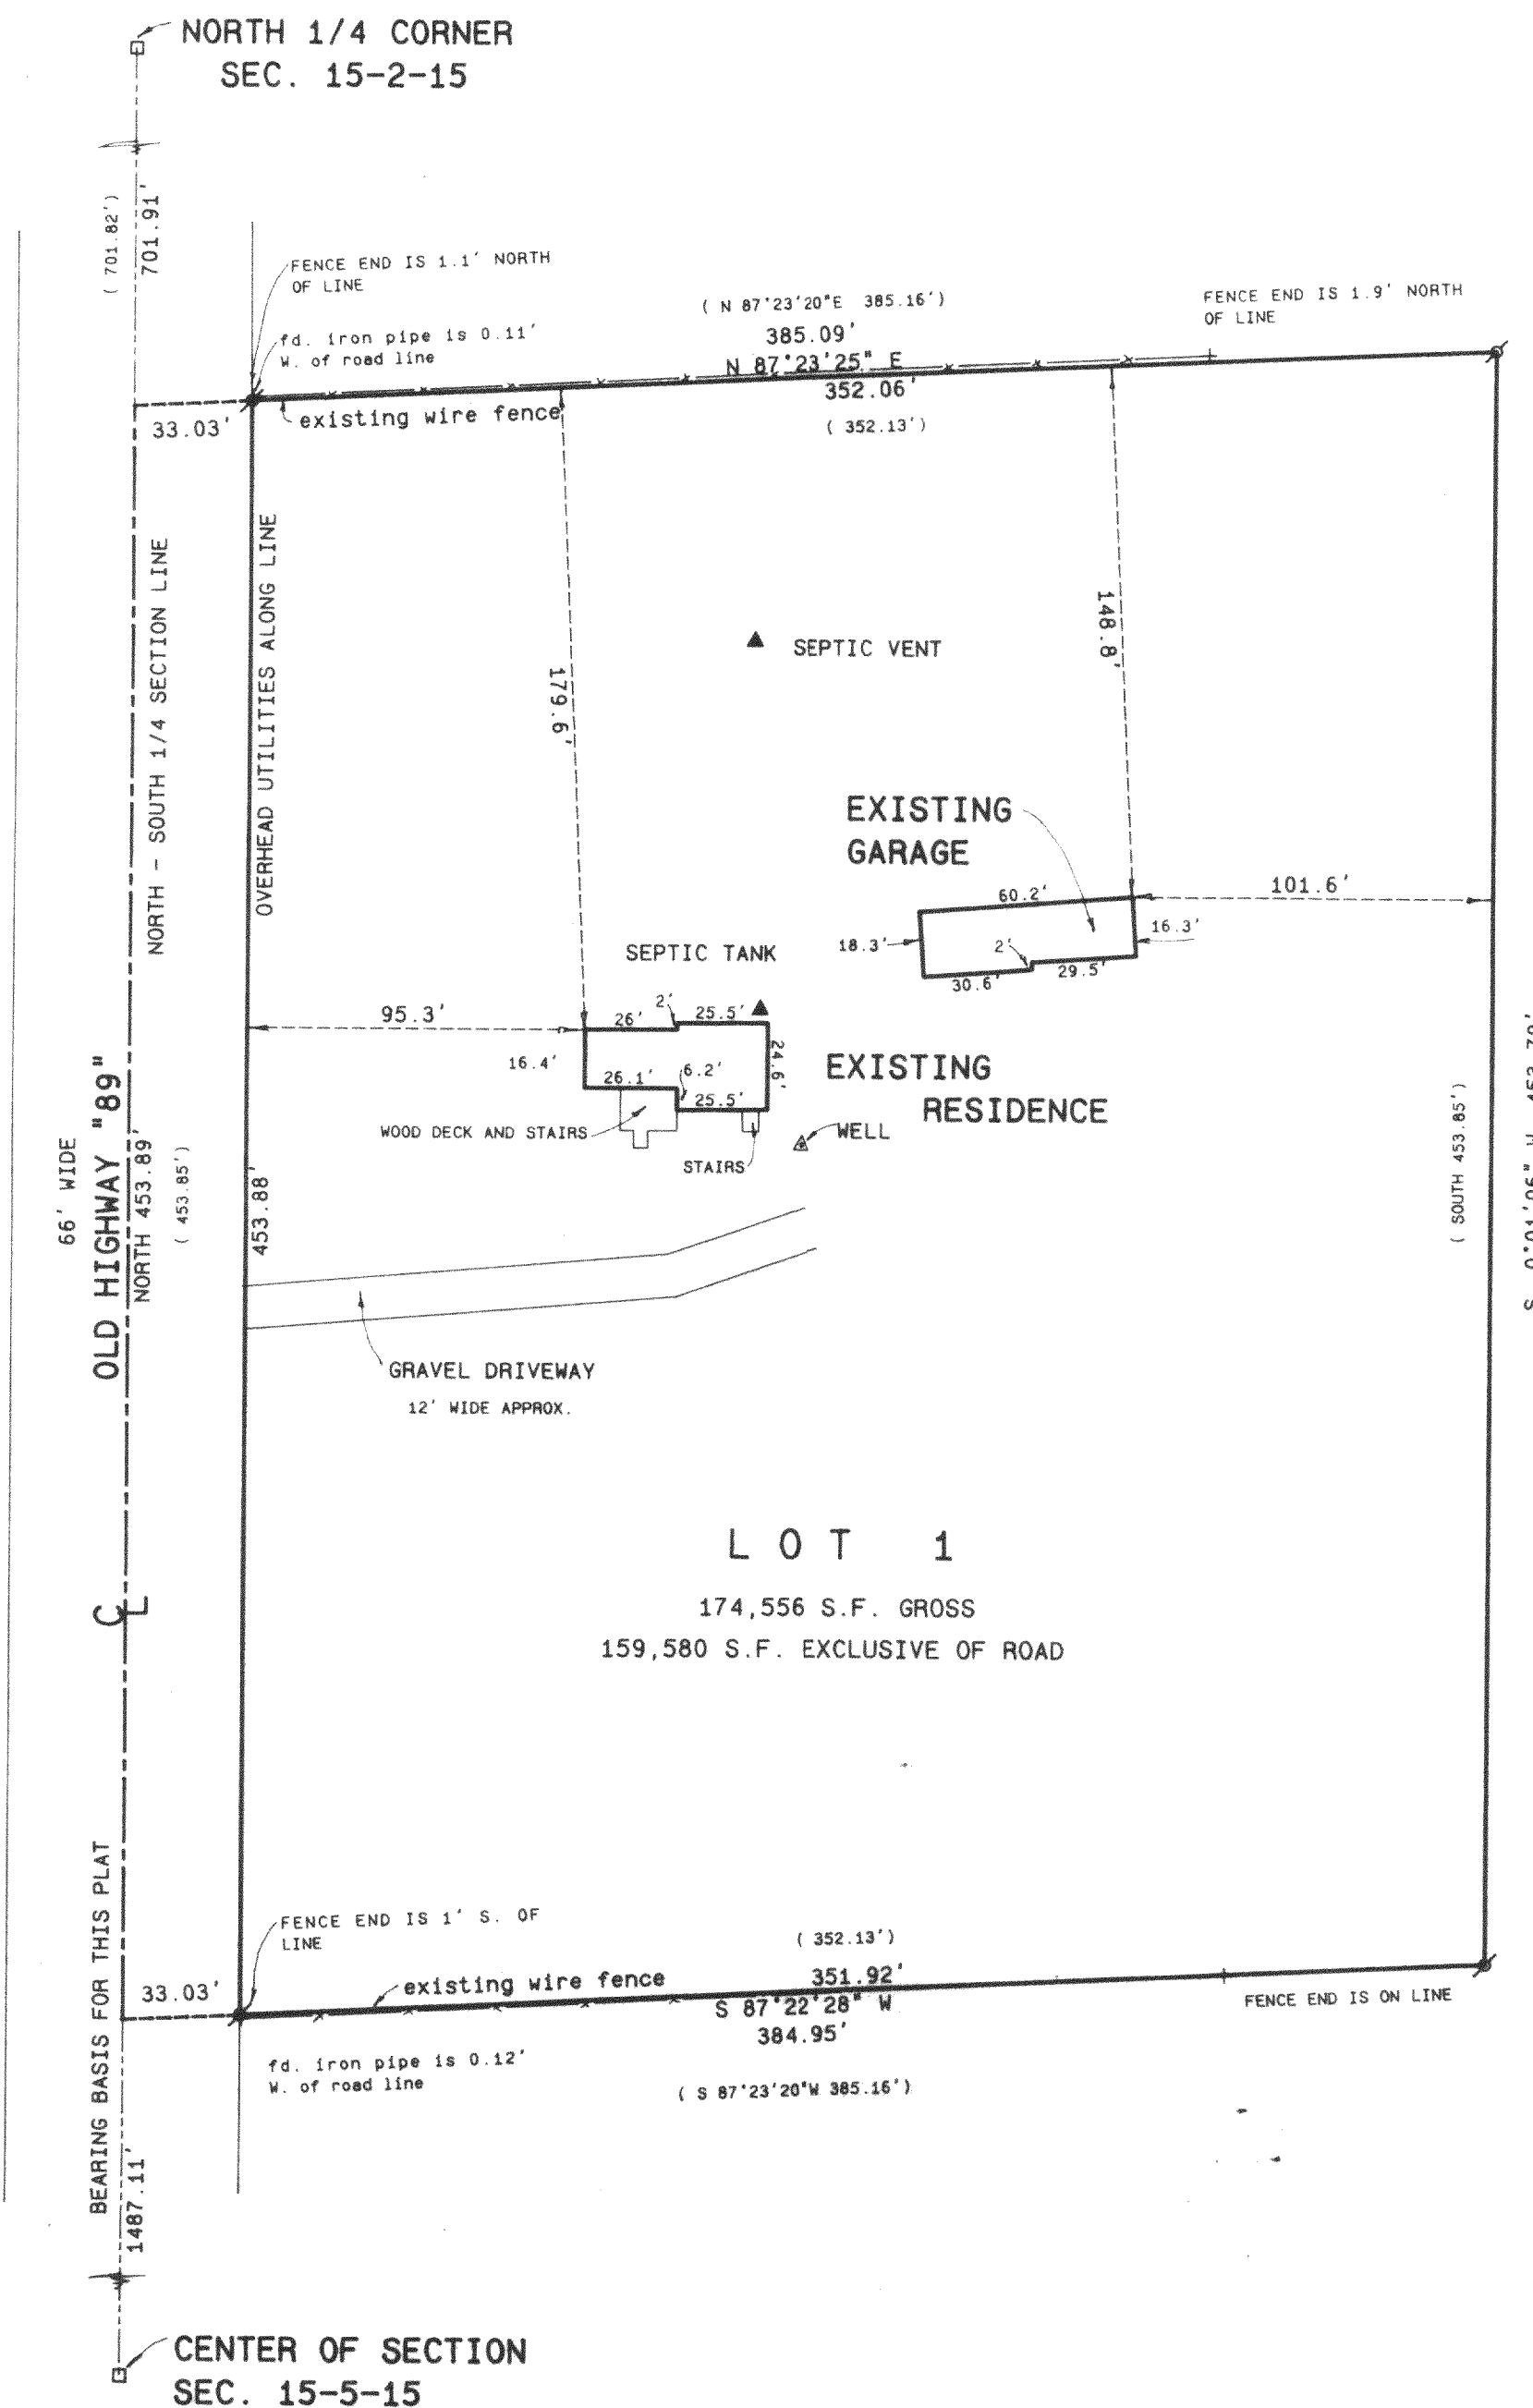


Legend

- FOUND IRON PIPE
- FOUND IRON ROD
- FOUND BRASS CAPPED MONUMENT
- FOUND CONCRETE MONUMENT
- CHISEL CUT IN CONCRETE
- SET IRON ROD, 24" LONG, WEIGHING 1.5 LBS./LINEAL FT., 3/8" DIA.
- SET IRON ROD, 30" LONG, WEIGHING 4.5 LBS./LINEAL FT., 1-11/16" DIA.
- (xx) RECORDED AS DIMENSION
- EXISTING FENCE

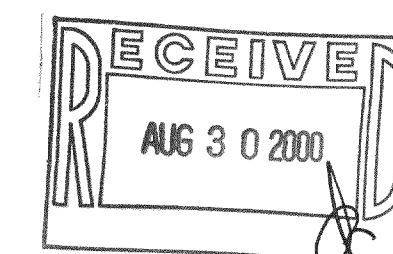

SCALE: 1" = 50 FEET

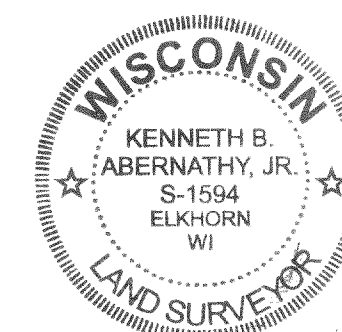

"I hereby certify that the above described property has been surveyed by me or under my direction and that the above map is a true representation thereof and shows the size and location of the property, its exterior boundaries, the location of all visible structures and dimensions of all principal buildings thereon, boundary fences, apparent easements, roadways and visible encroachments, if any."

"This survey is made for the use of the present owners of the property, and also those who purchase, mortgage, or guarantee the title thereto within one year from date hereof."

Kenneth B. Abernathy, Jr.
WISCONSIN REGISTERED LAND SURVEYOR,
S-1594

Date: MARCH 8, 2000 Job No. 00.209

BA-1223-1

215-481