


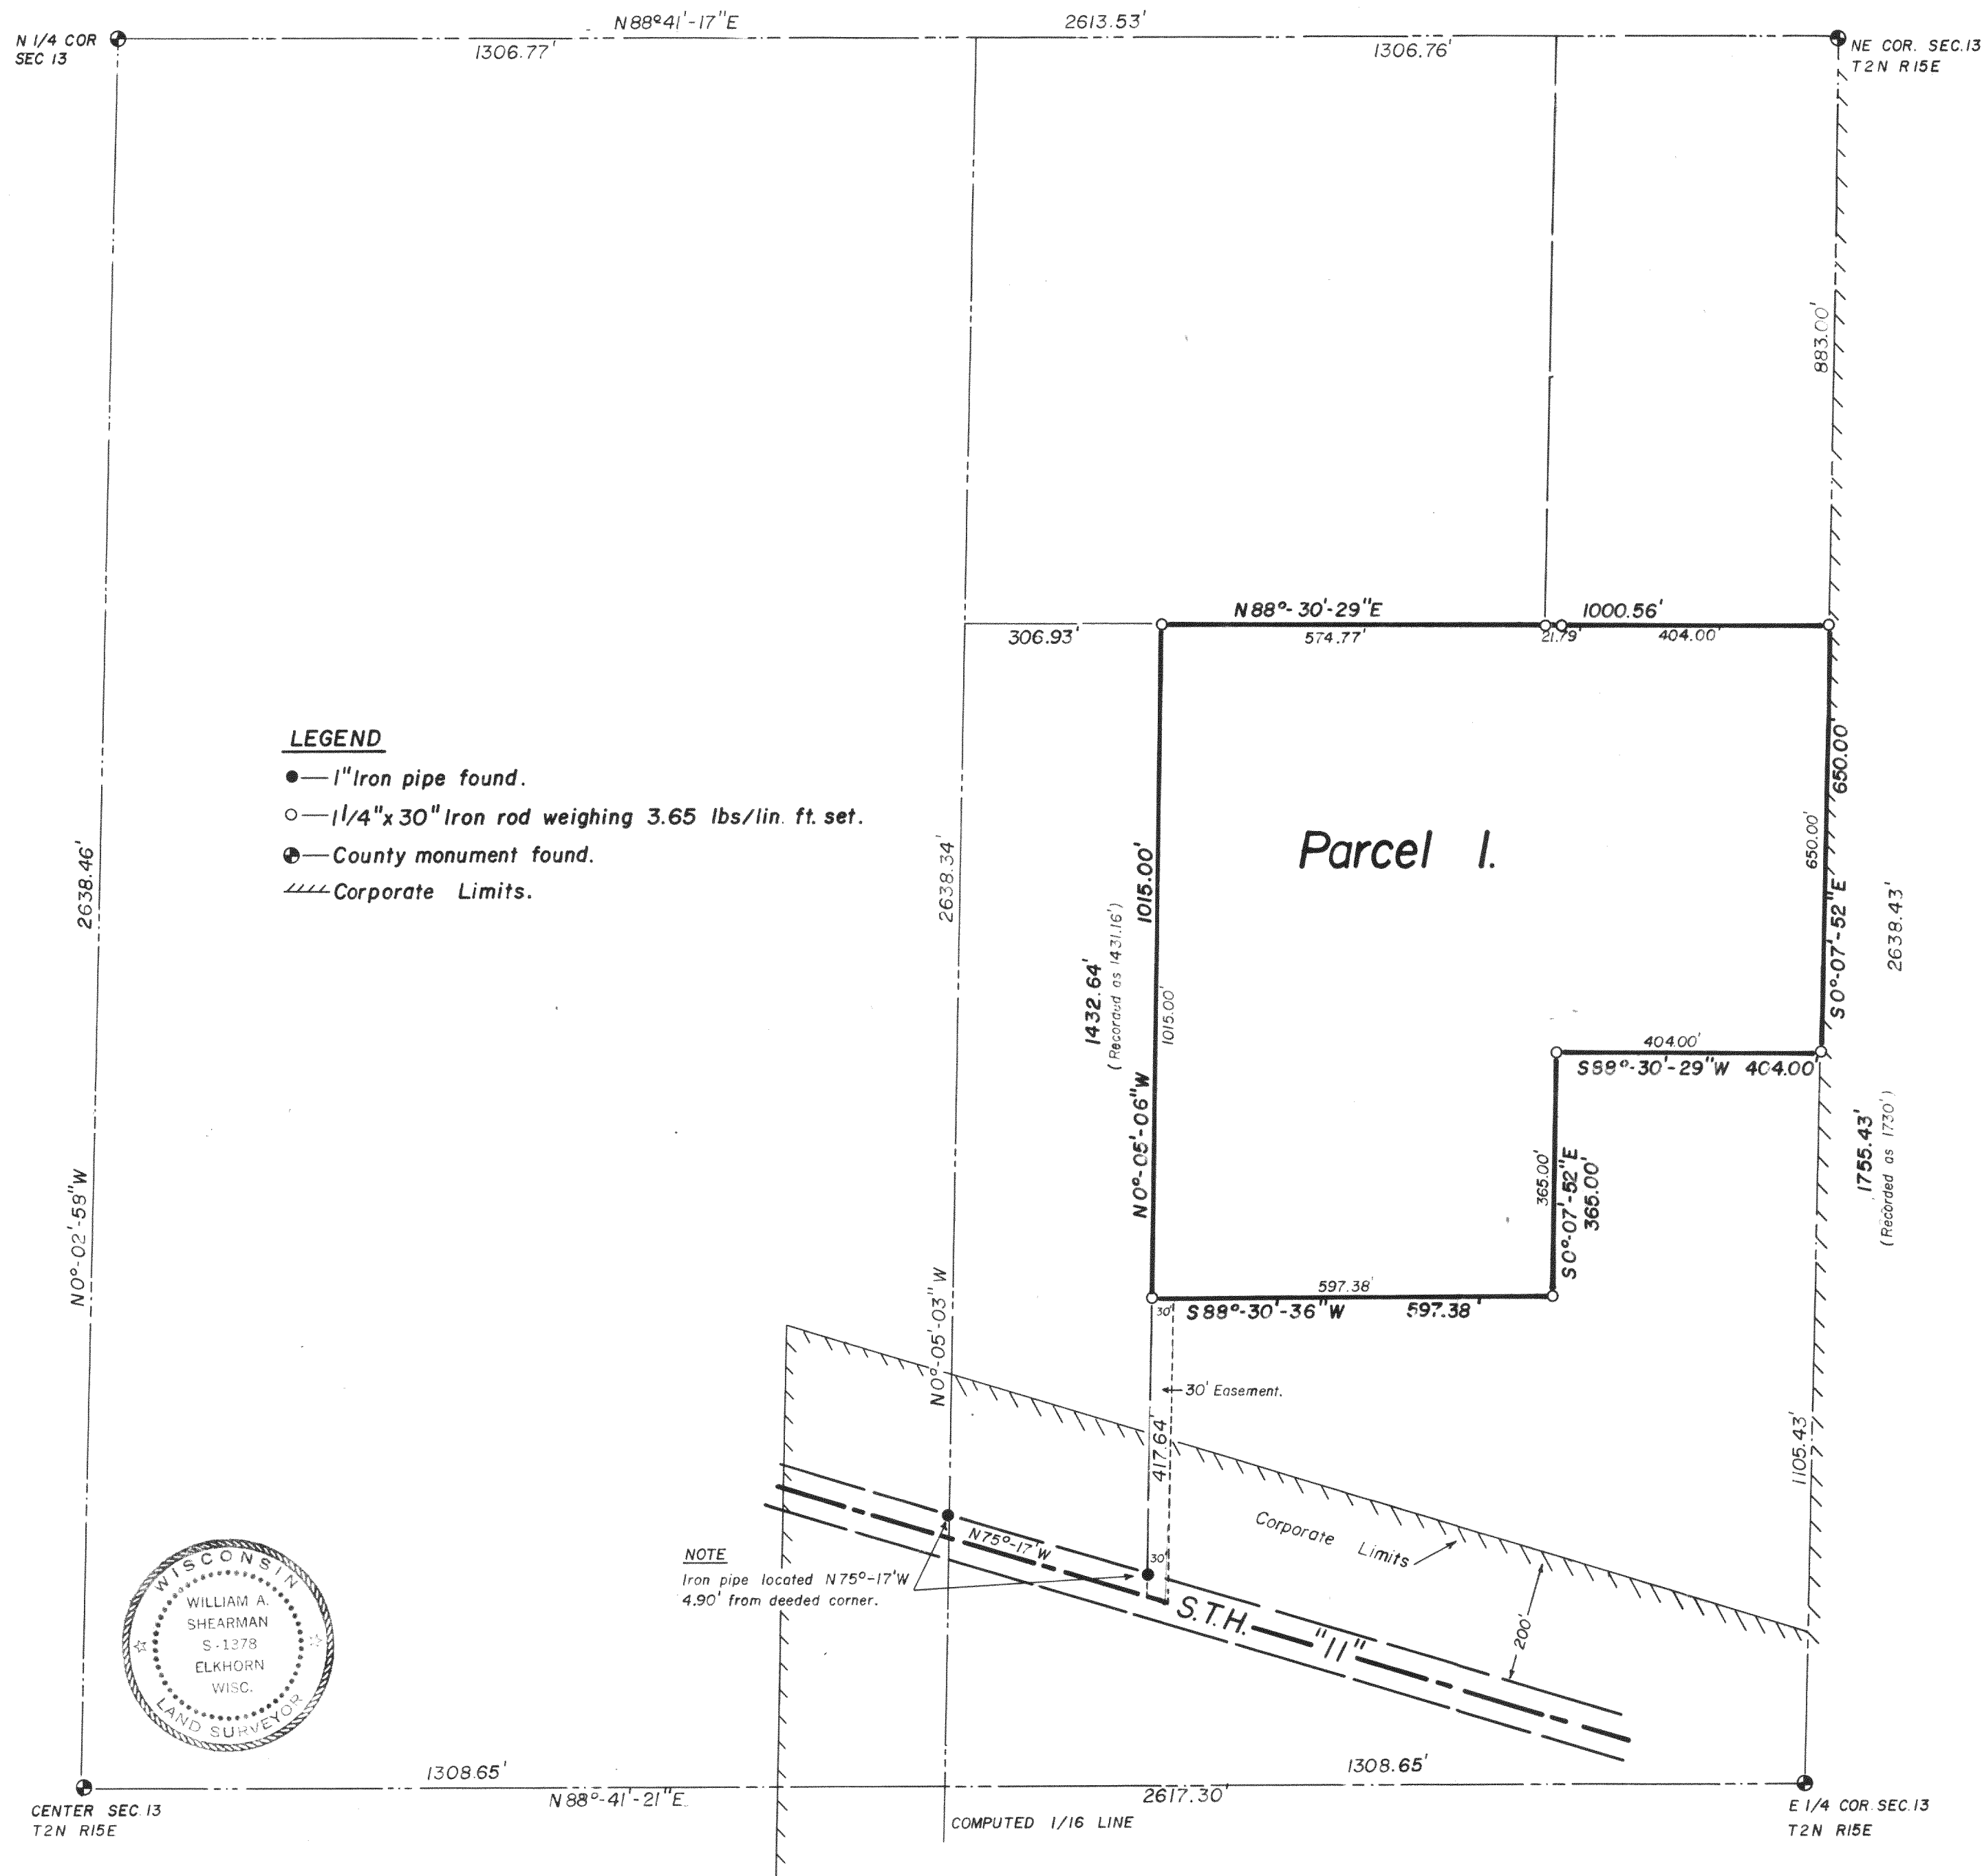

SCALE: 1" = 200'  
Bearings referenced to center  
line of S.T.H. "11" assumed  
N 75° - 17' W.

A parcel of land located in the NE 1/4 of Sec. 13, T2N, R15E, Town of Darien, Walworth County, WI, described as follows:

Commencing at the NE COR. of Sec. 13, T2N, R15E; thence N 88° 30' - 29" E, 1000.56' to the point of beginning; thence S 89° 30' - 36" W, 597.38'; thence S 89° 30' - 29" W, 404.00'; thence S 0° 07' - 52" E, 365.00'; thence S 0° 07' - 52" E, 365.00'; thence N 0° 05' - 06" W, 1015.00'; thence N 88° 41' - 17" E, 1306.77' to the point of beginning.

Parcel contains 19.23 Ac ±.

Also the following described easements for the installation and maintenance of utilities and ingress and egress:

A 20' wide easement easterly of the following described reference line: Commencing at the SW Corner of the above described parcel of land, also being the point of beginning; thence S 0° 07' - 52" E, 417.64' to the center line of S.T.H. "11".

# Surveyors Certificate

I, William A. Shearman, Registered Land Surveyor, do hereby certify that the plat shown herein is a true and accurate survey and a true representation thereof and the exterior boundary lines and all divisions of said property have been surveyed under my direction and to the best of my knowledge and belief.

Witness my hand and seal this 15th day of May, 1978.  
William A. Shearman S-1378  
Registered Land Surveyor

**JENSEN & JOHNSON**  
ENGINEERS AND SURVEYORS  
PO BOX 290, ELKHORN, WISCONSIN  
414-723-3204  
A Division of  
Donohue & Associates, Inc.

PLAT  
OF SURVEY

|                         |                          |
|-------------------------|--------------------------|
| Date<br>1/5/78          | Scale<br>1" = 200'       |
| Drawn By<br>D. CHROUSER | Surveyed For<br>WALCOMET |
| Checked By              | Project No.<br>2304.0    |

10-13-913

215-52