


NW CORNER OF THE
SOUTH 1/2 OF THE
SW 1/4 SEC. 2-15-3

PLAT OF SURVEY

LOT 9, SPRINGWOOD FARMS SUBDIVISION (UNRECORDED)
MORE PARTICULARLY DESCRIBED AS FOLLOWS: COMMENCING
AT THE NORTHWEST CORNER OF THE SOUTH 1/2 OF THE
SOUTHWEST 1/4 OF SECTION 3, TOWN 2 NORTH, RANGE
15 EAST, IN THE TOWN OF DARIEN, WALWORTH COUNTY,
WISCONSIN; THENCE EAST ALONG THE NORTH LINE OF
THE SOUTH 1/2 OF SAID 1/4 SECTION, 1021.74 FEET TO
THE POINT OF BEGINNING; CONTINUE THENCE EAST 424.84
FEET; THENCE SOUTH 678.99 FEET TO A POINT ON A CURVE
WHOSE CENTER LIES TO THE SOUTHWEST WITH A RADIUS
OF 453.00 FEET AND A CHORD BEARING NORTH 64°30'
WEST 390.04 FEET; THENCE NORTHWESTERLY ALONG THE
ARC OF SAID CURVE 403.22 FEET; THENCE WEST 72.80
FEET; THENCE NORTH 511.00 FEET TO THE POINT OF
BEGINNING

SURVEYED FOR: BIELINSKI BROS. BUILDERS/JAMES AND
SHARI LOBACK

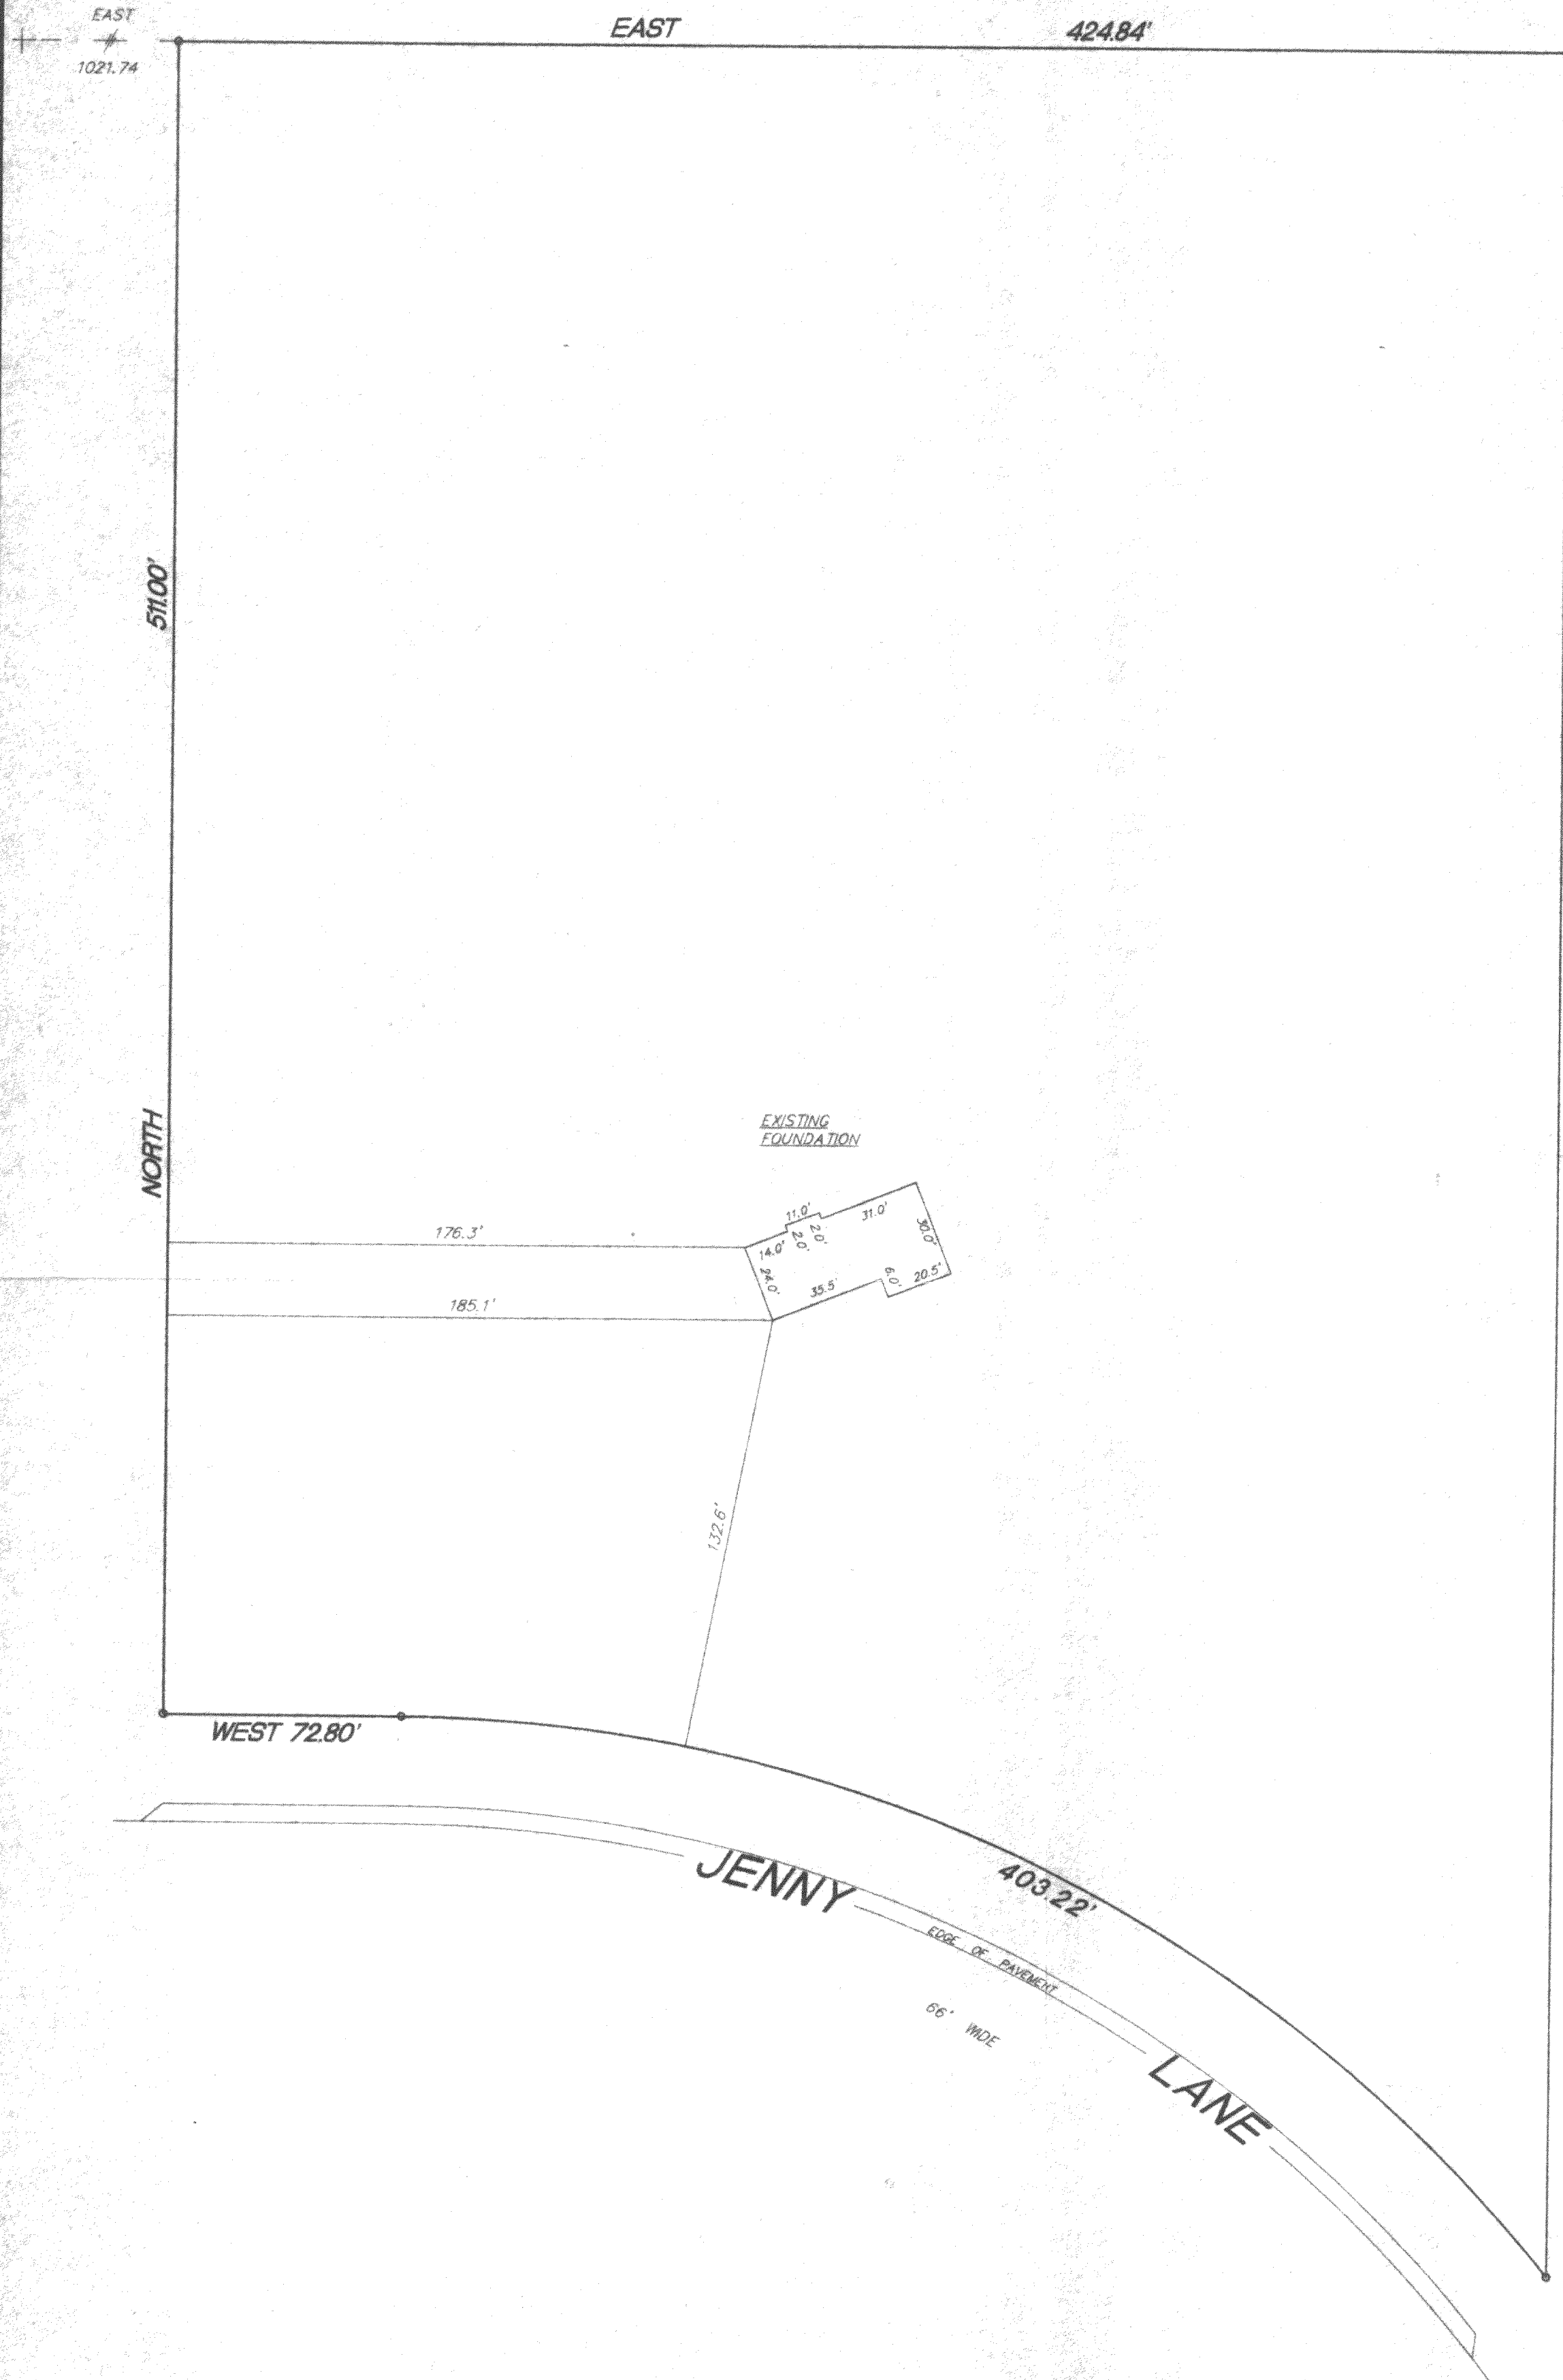

FOUND 1" IRON PIPE

SOUTH


SCALE 1"=40'

RADIUS	LENGTH	CHORD	BEARING	DELTA
453.00'	403.22'	390.04'	N64°30'00"W	50°59'58"

"I hereby certify that I have surveyed the above property
and that the above map is a true representation thereof
and shows the size and location of the property
existing boundaries, the location of all visible structures
and dimensions of all principal buildings thereon, boundary
fences, apparent easements, roadways and encroachments if
any."

"This survey is made for the use of the present owners of
the property and also those who purchase, mortgage or
guarantee the title thereto within one year from date hereof."

KETTLE MORANE SURVEYING INC.
P.O. Box 357
Eagle WI 53119
(262)594-3484

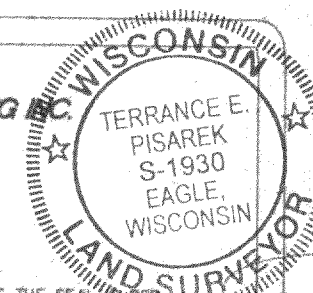

THIS IS NOT AN ORIGINAL SURVEY UNLESS THE SEAL IS PRESENT

REV. 1/8/03
DATE 10/28/02
TWP/DW FIELD WORK BY
TWP DRAWN BY
JOB NUMBER 02185