



Plat of Survey

of
A parcel of land described in a Warranty Deed recorded in Vol. 381 on Page 539 as Document No. 136131, as shown below:
All of the East 1/2 of the West 1/2 of the Southwest 1/4 of Section 33, T2N R15E, Walworth County, Wisconsin, lying north of the abandoned Chicago, Milwaukee, St. Paul & Pacific Railroad Company property and south of the centerline of County Trunk Highway "X" and all of the East 1/2 of the West 1/2 of the Northwest 1/4 of said Section 33, lying south of the centerline of County Trunk Highway "X", excepting therefrom land included in Certified Survey Map number 374 and in Certified Survey Map number 1528 as recorded in the Office of the Register of Deeds, Walworth County, Wisconsin.

Lot 1
C.S.M. 1994

Lot 1
C.S.M. 374

Lot 1
C.S.M. 1528

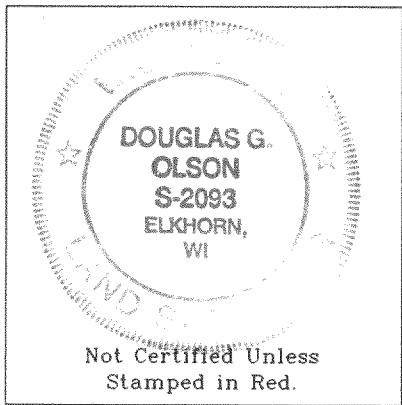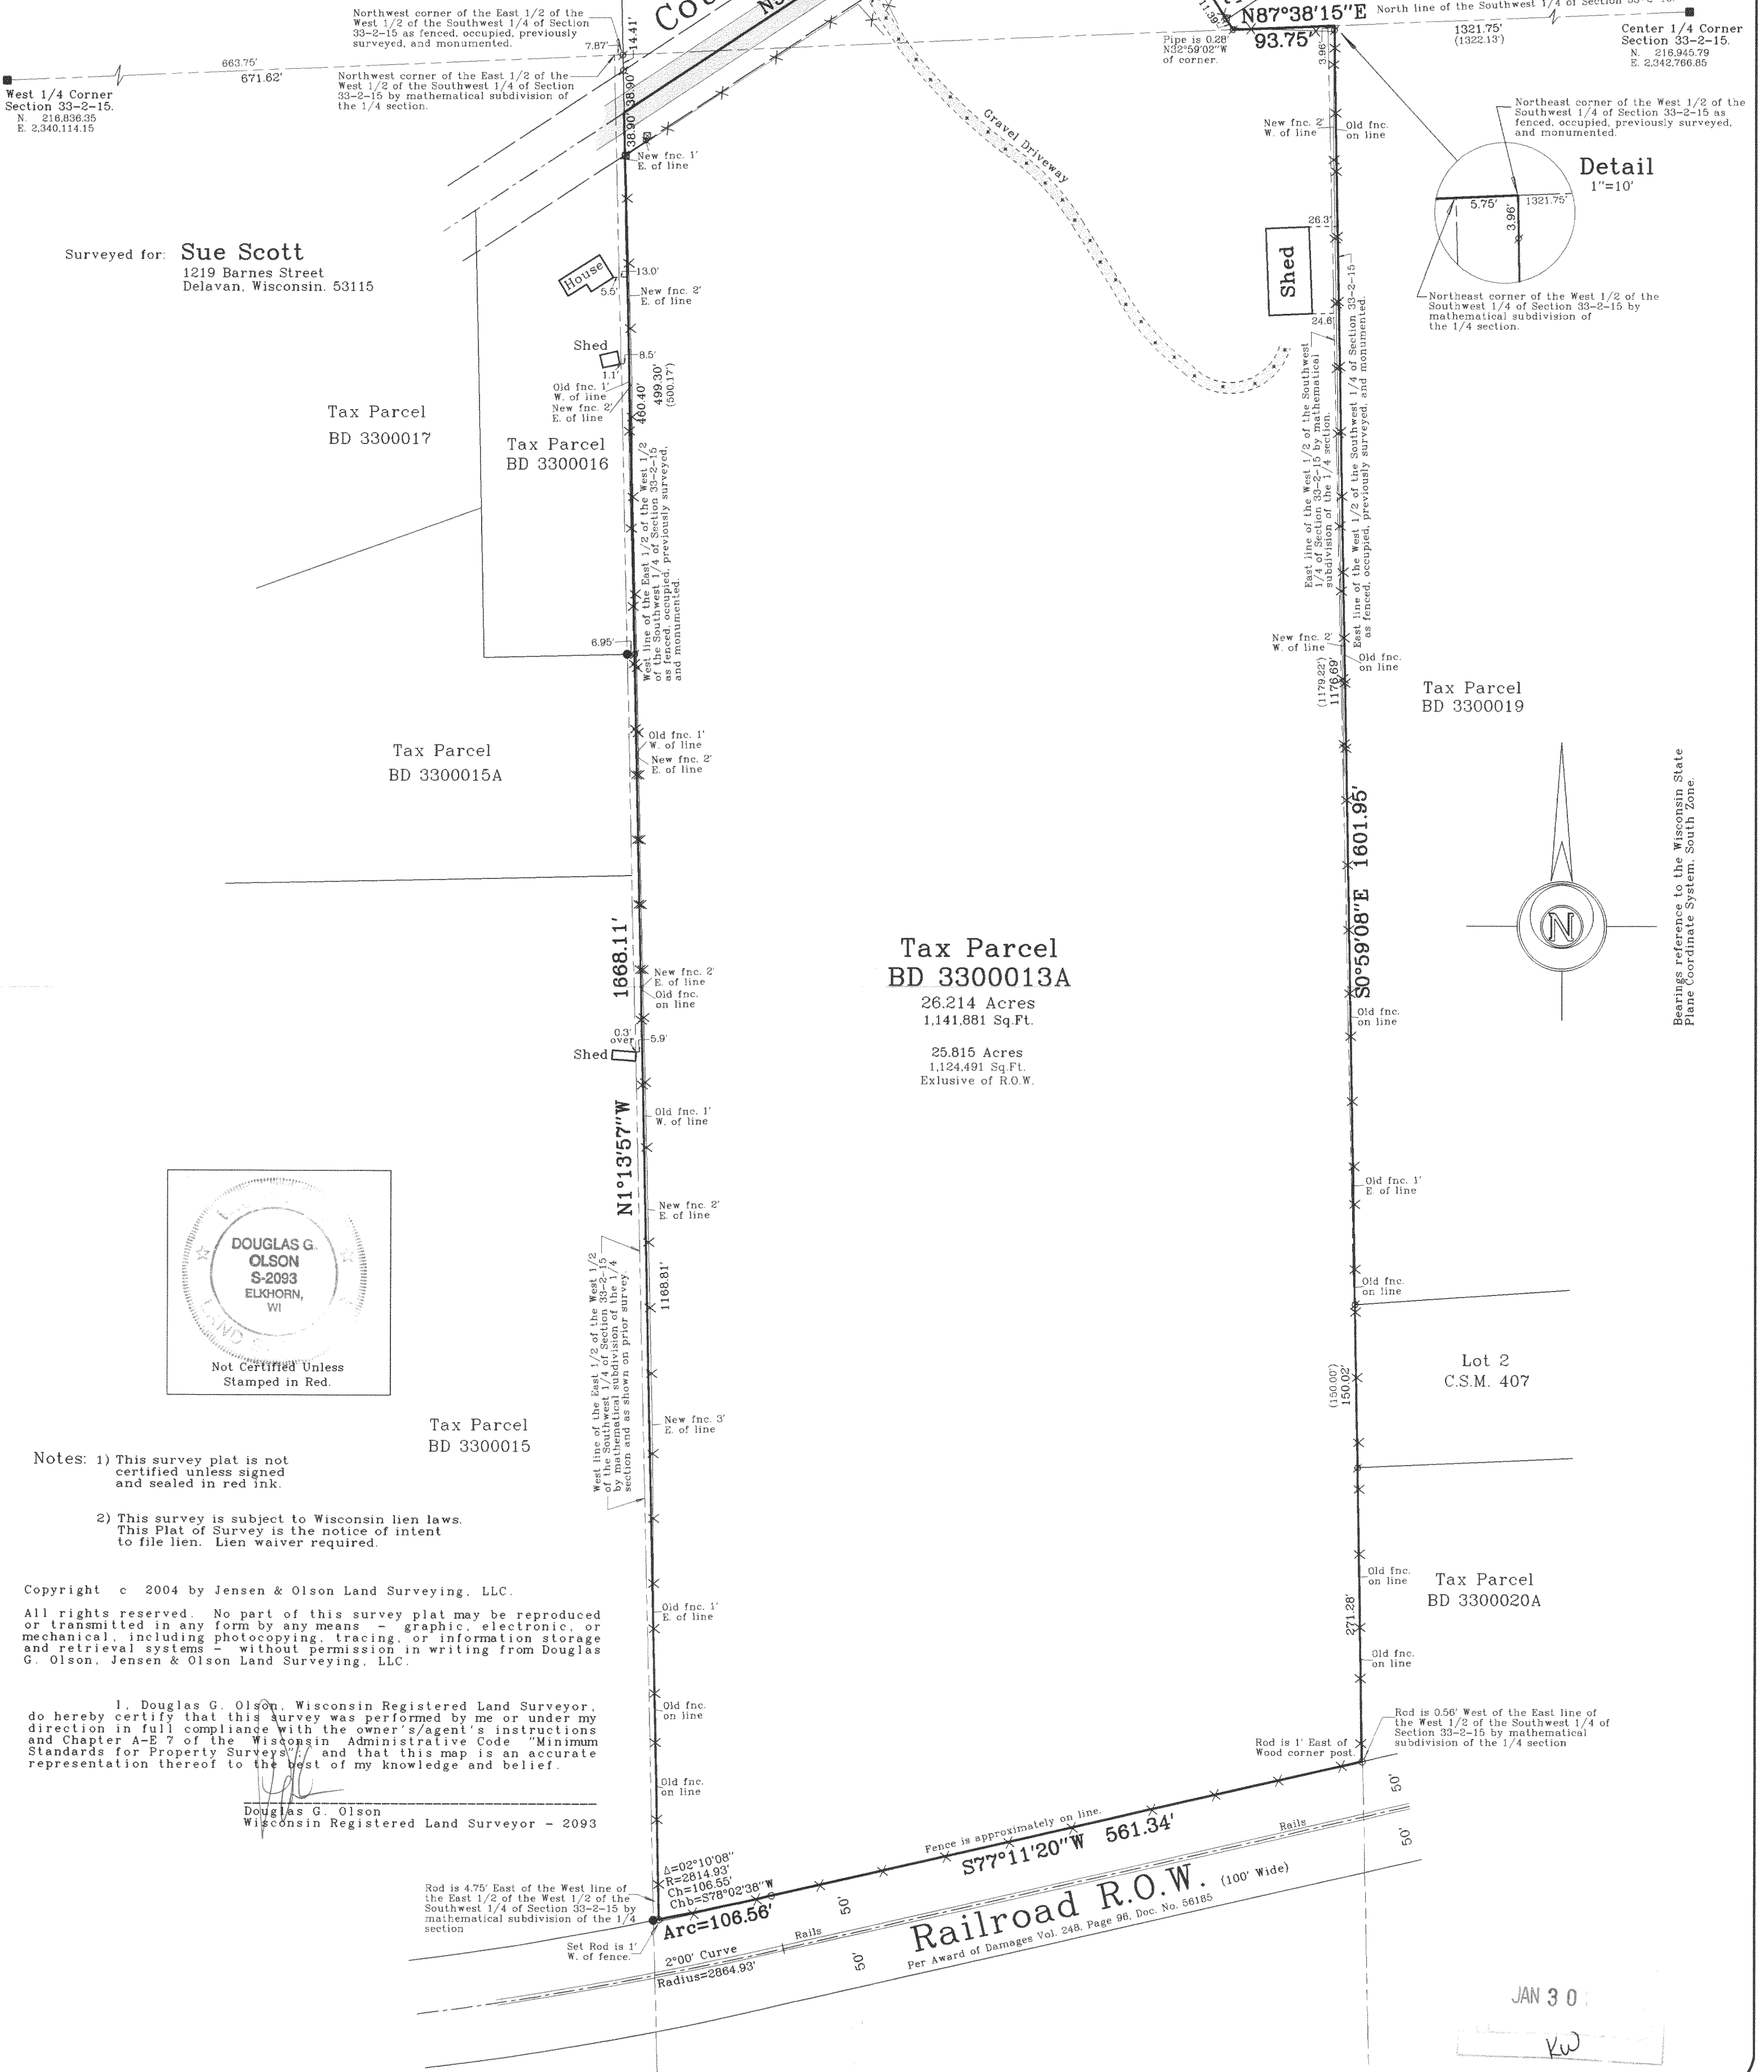

- Notes: 1) This survey plat is not certified unless signed and sealed in red ink.
- 2) This survey is subject to Wisconsin lien laws. This Plat of Survey is the notice of intent to file lien. Lien waiver required.

Copyright © 2004 by Jensen & Olson Land Surveying, LLC.

All rights reserved. No part of this survey plat may be reproduced or transmitted in any form by any means - graphic, electronic, or mechanical, including photocopying, tracing, or information storage and retrieval systems - without permission in writing from Douglas G. Olson, Jensen & Olson Land Surveying, LLC.

I, Douglas G. Olson, Wisconsin Registered Land Surveyor, do hereby certify that this survey was performed by me or under my direction in full compliance with the owner's/agent's instructions and Chapter A-E 7 of the Wisconsin Administrative Code "Minimum Standards for Property Surveys" and that this map is an accurate representation thereof to the best of my knowledge and belief.

Douglas G. Olson
Wisconsin Registered Land Surveyor - 2093

Rod is 4.75' East of the West line of the East 1/2 of the West 1/2 of the Southwest 1/4 of Section 33-2-15 by mathematical subdivision of the 1/4 section

Set Rod is 1' W. of fence.

A=02°10'08"
R=2814.93'
Ch=106.56'
Chb=579°02'38"W

2°00' Curve
Radius=2864.93'

Fence is approximately on line.

S77°11'20"W 561.34'

Rails

Railroad R.O.W. (100' Wide)

Per Award of Damages Vol. 248, Page 96, Doc. No. 56185

JAN 30

VW

2003.084
Sheet 1 of 1 Sheets
Job Reference Number
2003.084

- Legend
- Found County Section Corner
 - Found Iron Pipe
 - Found Iron Rod
 - Set Iron Rod, 3/4" dia.
 - Recorded Information
 - Utility Pole
 - Utility Pedestal
 - Asphalt Surface
 - Gravel

Jensen & Olson Land Surveying, LLC

45 South Wisconsin Street P.O. Box 322
Elkhorn, Wisconsin 53121
Telephone (262) 723-3434
Facsimile (262) 723-8044

Scale in Feet
1" = 100'

0' 50' 100' 200'

Survey Date: January 9, 2004.
Revisions:

BD33-13A

215-563