


RIDGE PRAIRIE SCHOOL ROAD

ABELL
SURVEYING & MAPPING
1140 SEQUOIA STREET • DELAVAN, WISCONSIN 53115
262-728-6737

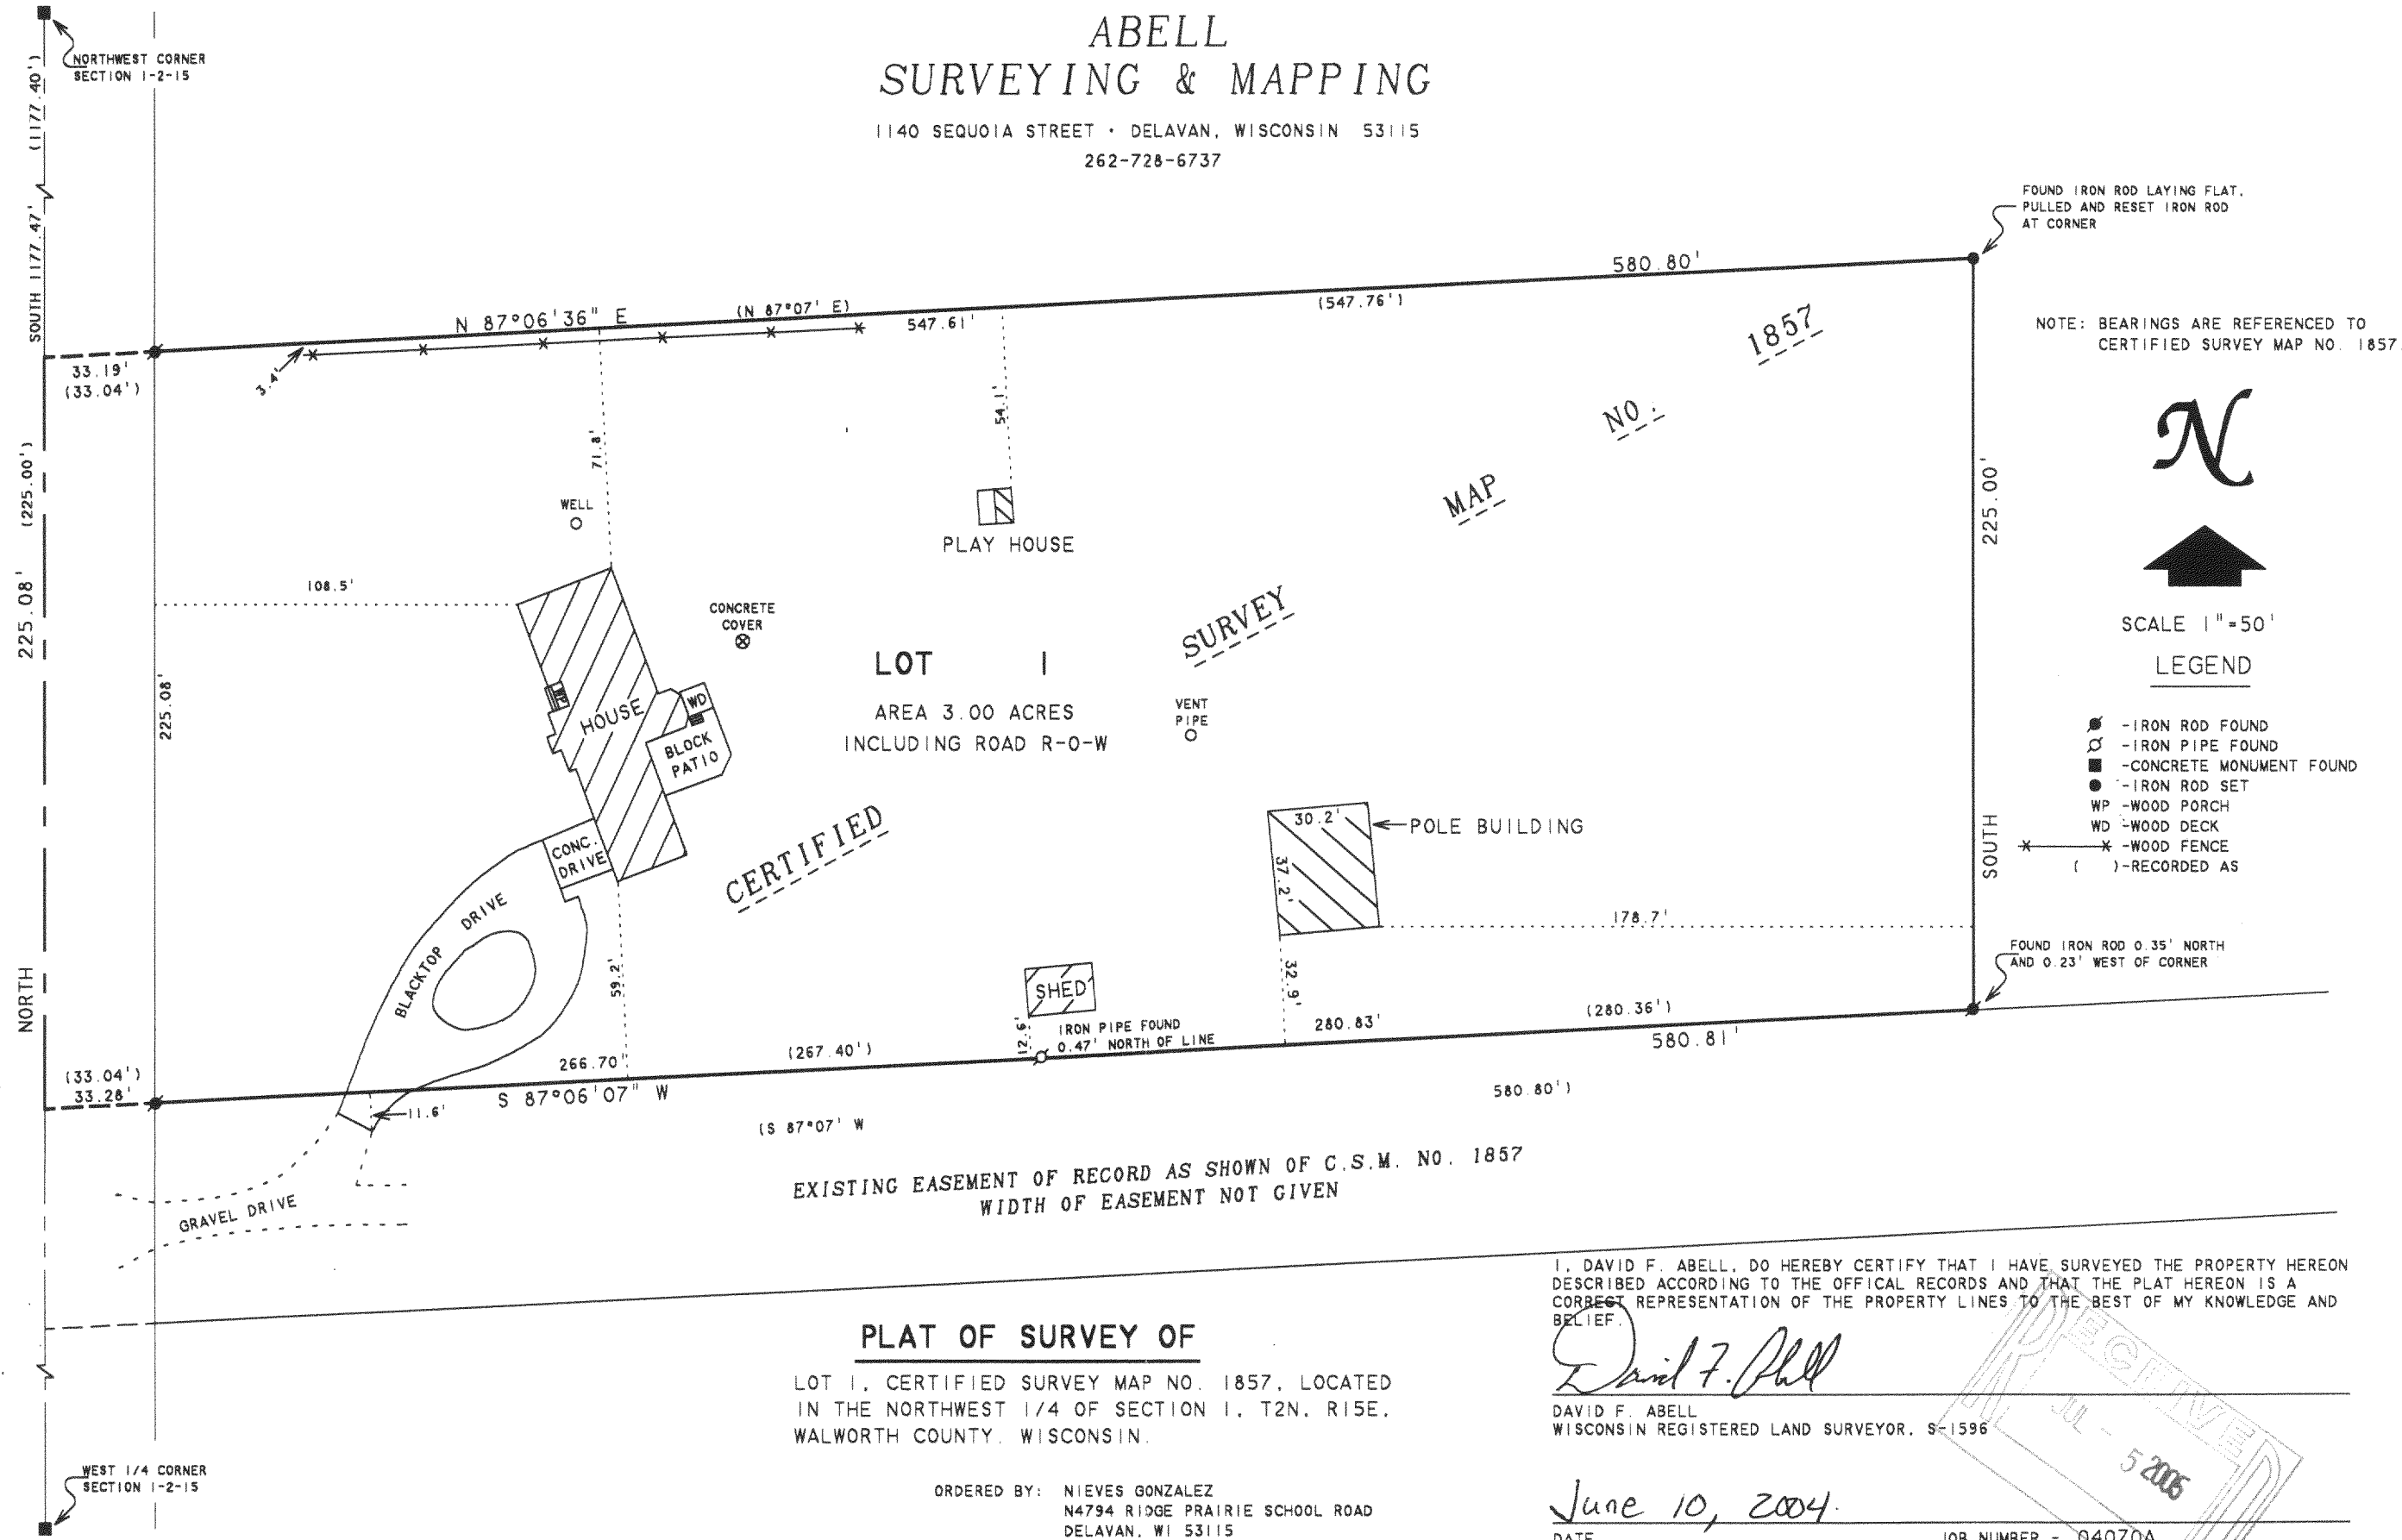

PLAT OF SURVEY OF
LOT 1, CERTIFIED SURVEY MAP NO. 1857, LOCATED
IN THE NORTHWEST 1/4 OF SECTION 1, T2N. R15E,
WALWORTH COUNTY, WISCONSIN.

ORDERED BY: NIEVES GONZALEZ
N4794 RIDGE PRAIRIE SCHOOL ROAD
DELAVAN, WI 53115

REVISED: MAY 18, 2005 TO SHOW THE POLE BUILDING


I, DAVID F. ABELL, DO HEREBY CERTIFY THAT I HAVE SURVEYED THE PROPERTY HEREON DESCRIBED ACCORDING TO THE OFFICIAL RECORDS AND THAT THE PLAT HEREON IS A CORRECT REPRESENTATION OF THE PROPERTY LINES TO THE BEST OF MY KNOWLEDGE AND BELIEF.

David F. Abell

DAVID F. ABELL
WISCONSIN REGISTERED LAND SURVEYOR, S-1596

June 10, 2004

DATE: June 10, 2004
JOB NUMBER - 04070A
NOTE: THIS IS NOT A CERTIFIED COPY UNLESS SEALED.

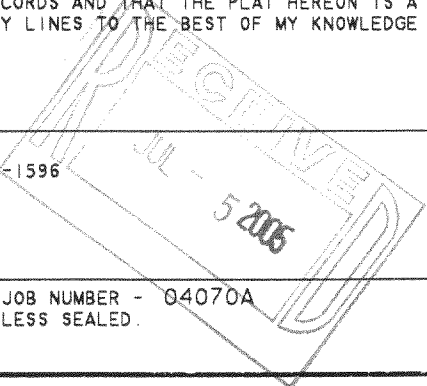

215-595

BA1857-1