

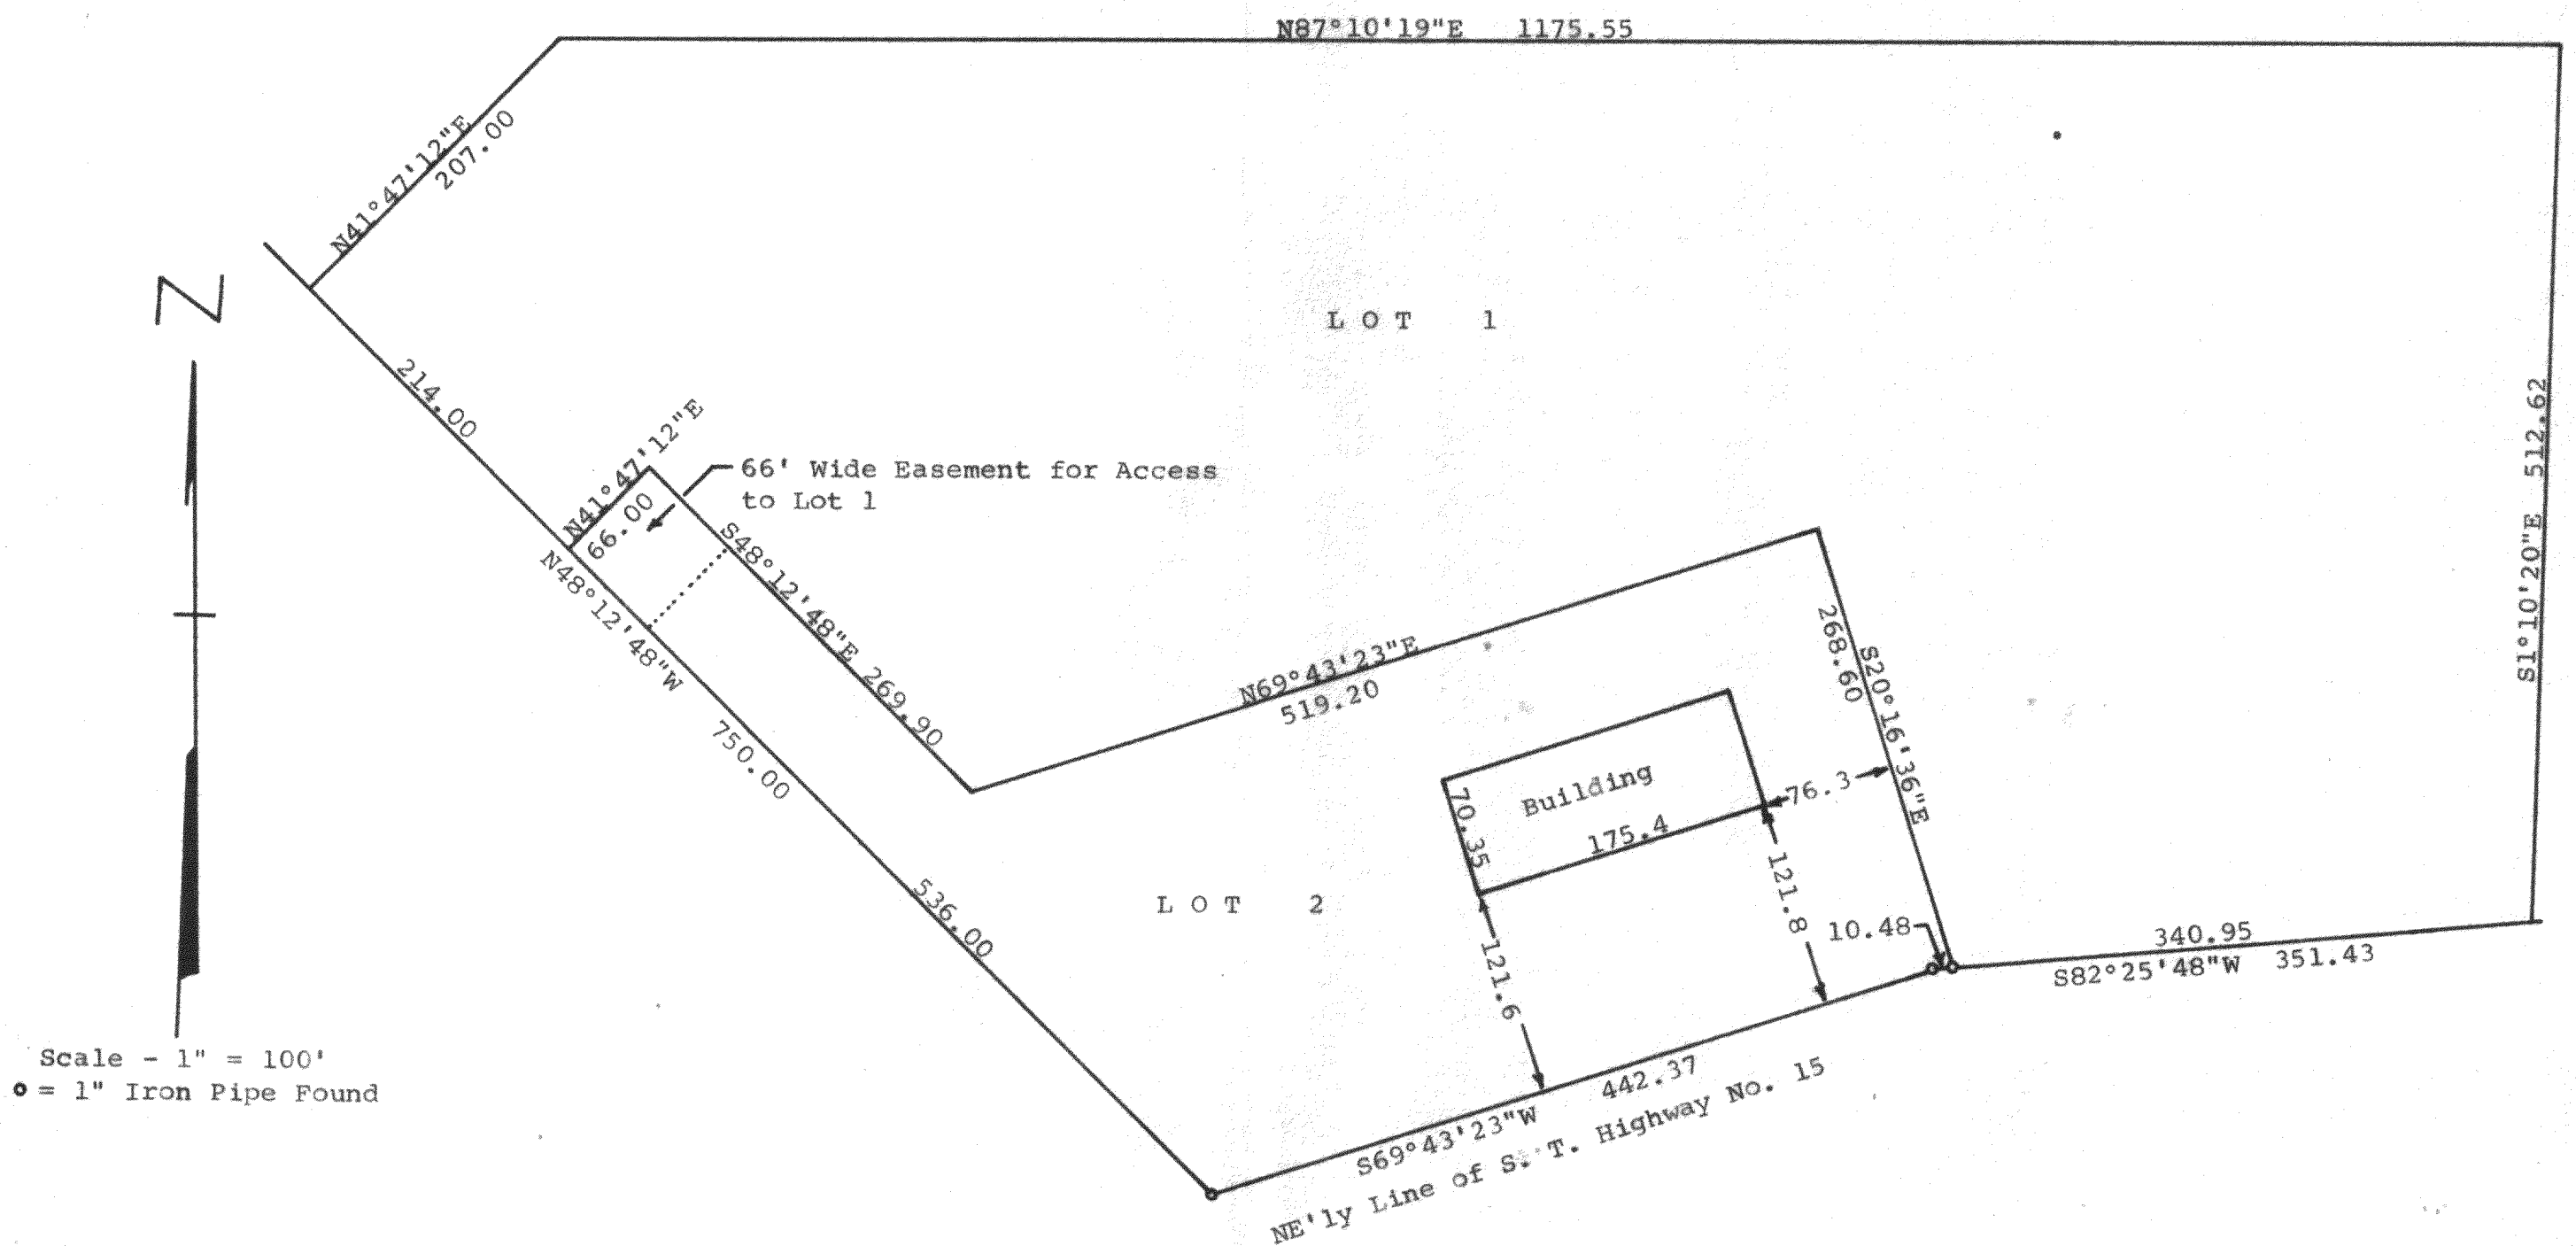


DUNHAM SURVEYING, S. C.
SURVEYING & SUBDIVIDING
DELAVER, WISCONSIN 53115

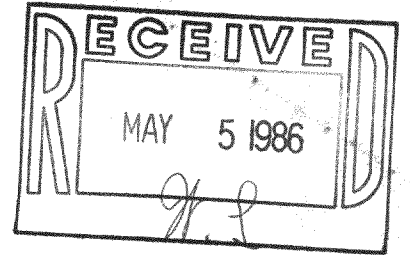

Plat showing the building location on Lots 1 and 2 of
Certified Survey No. 1077 located in the Southwest ¼
of the Southeast ¼ of Section 21, T 2 N, R 15 E,
Walworth County, Wisconsin.
January 15, 1986

George T. Dunham
George T. Dunham, Surveyor

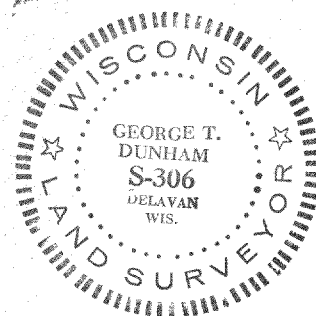

215-217
599