
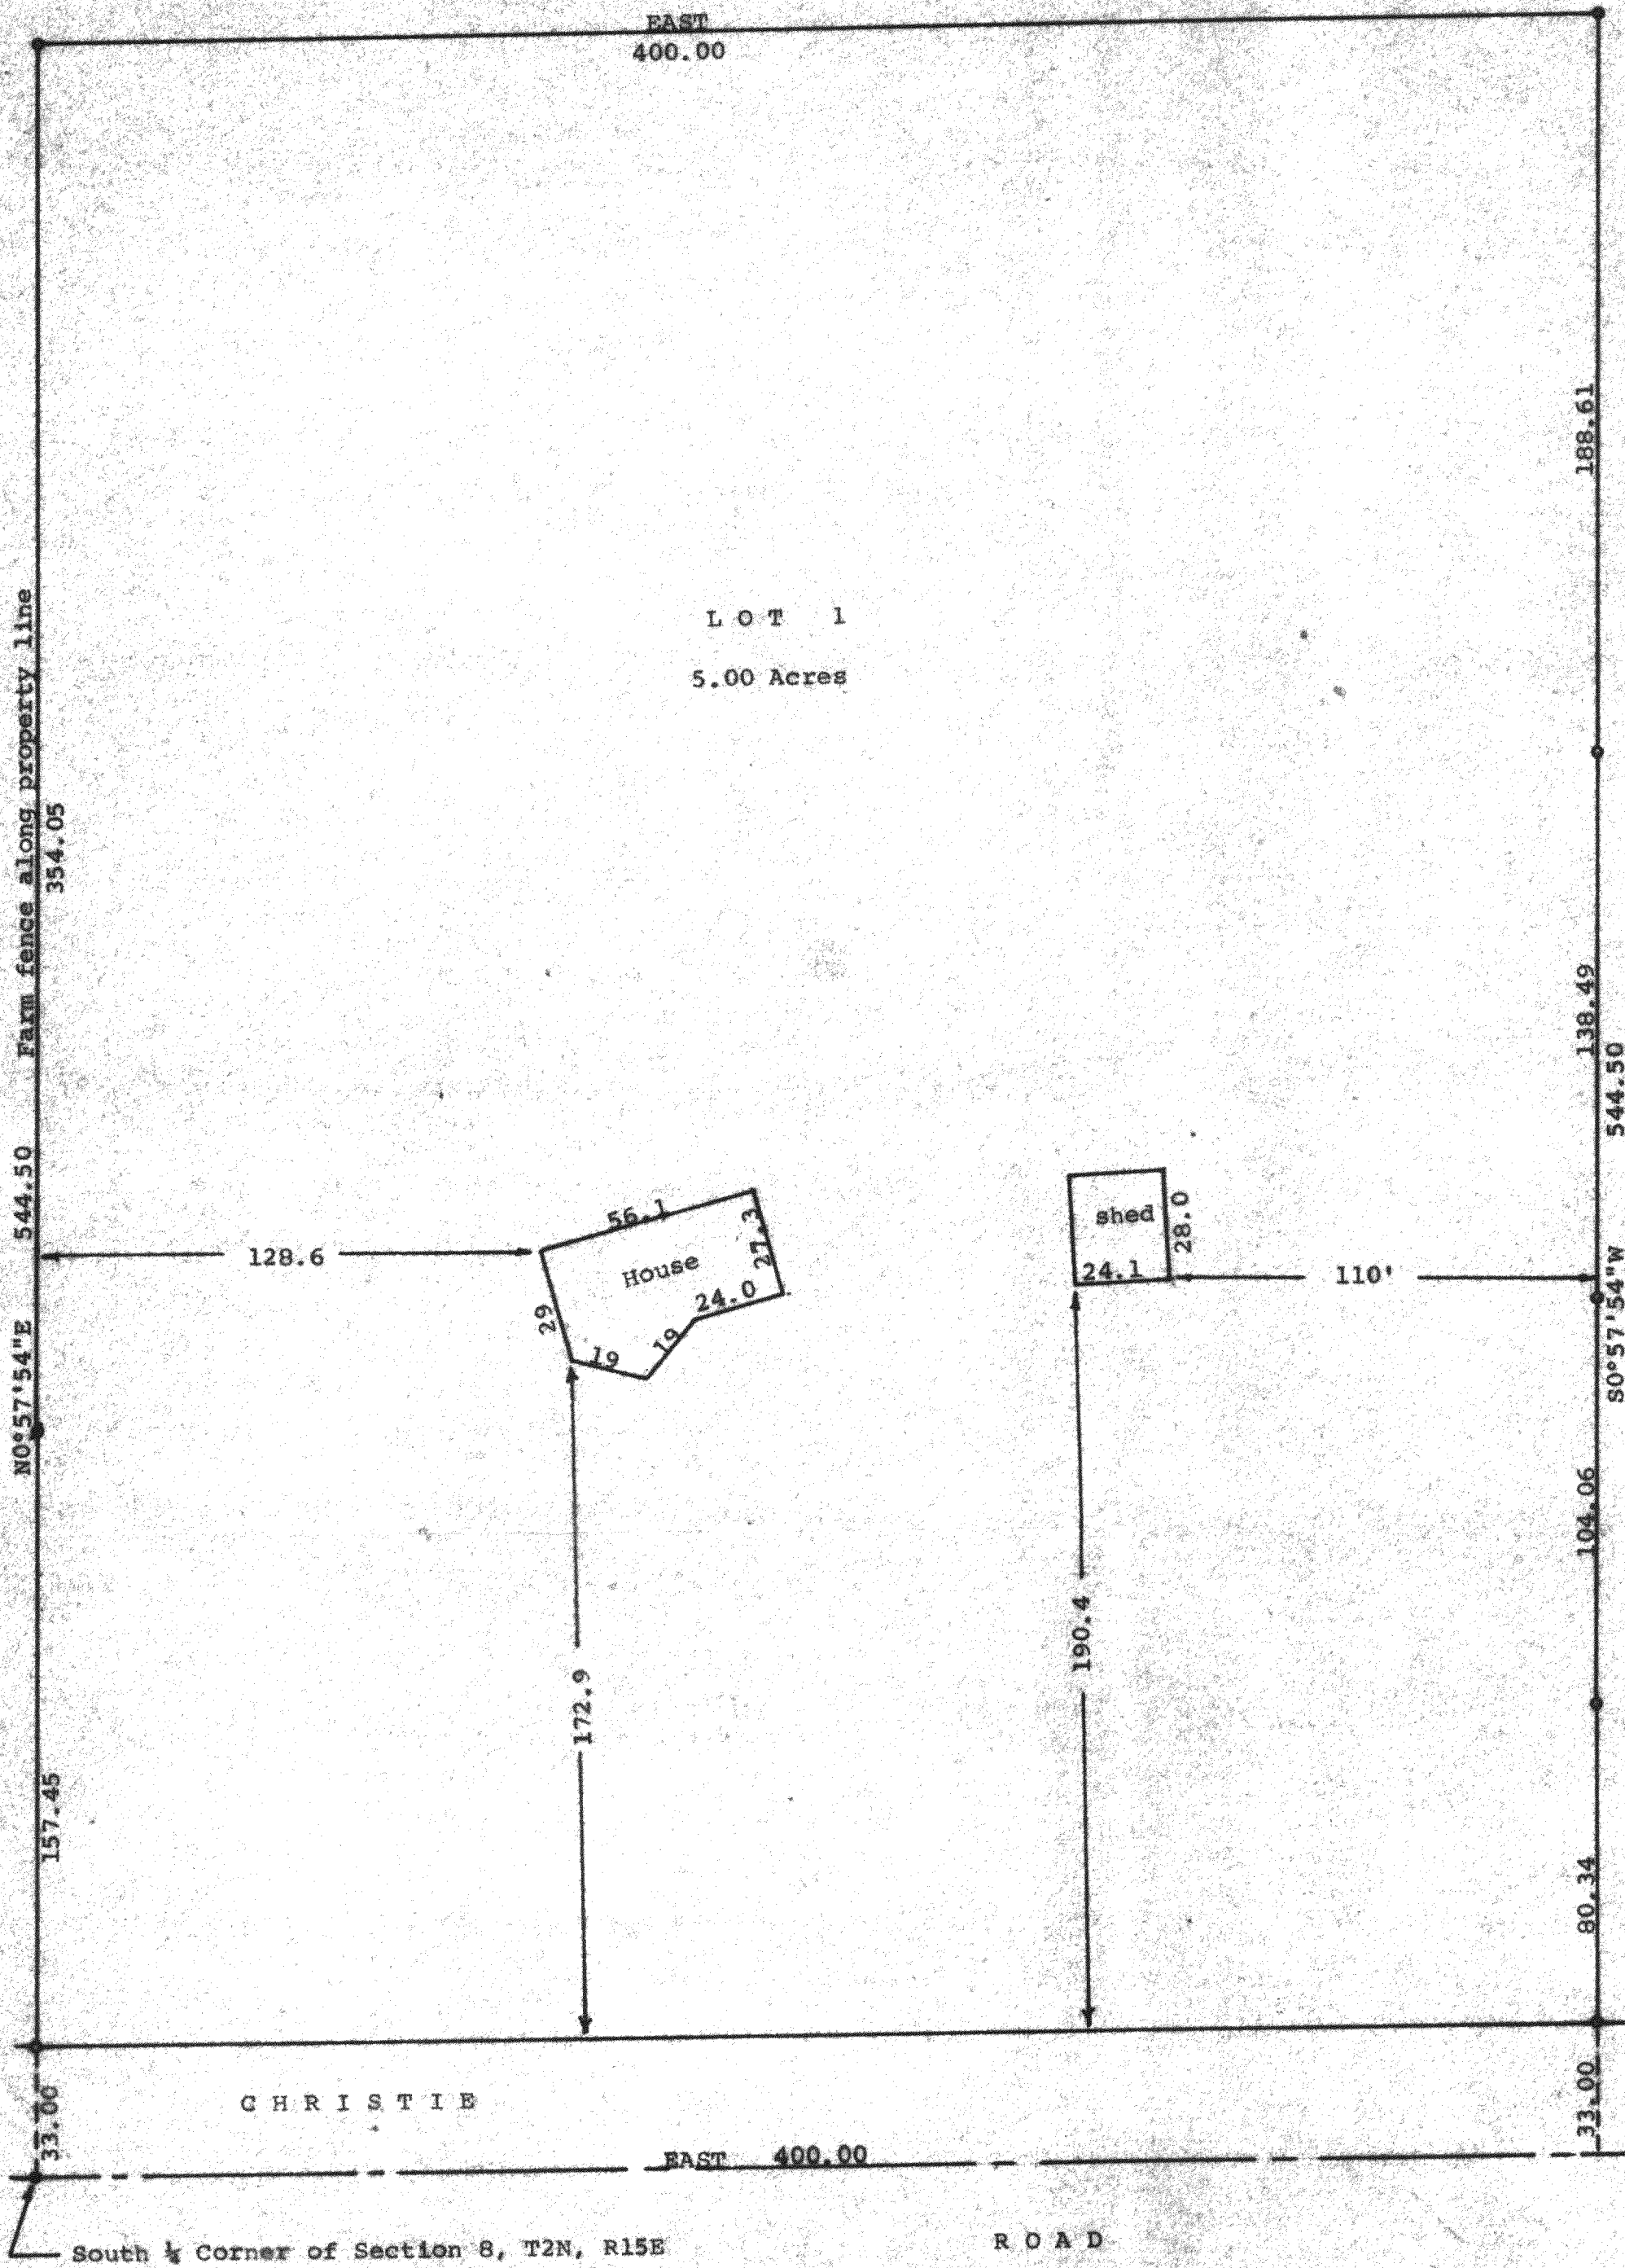


DUNHAM SURVEYING, S. C.
SURVEYING & SUBDIVIDING
DELAVAN, WISCONSIN 53115

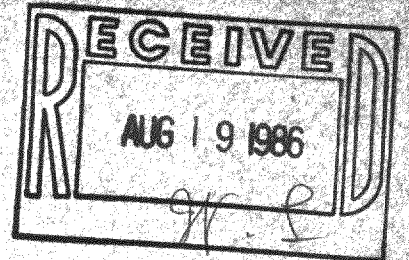


STATE OF WISCONSIN) ss
COUNTY OF WALWORTH)

I, George T. Dunham, Surveyor, certify that I have surveyed the property described as follows:

Lot 1 of Certified Survey No. 1367, recorded in Volume 6 of Certified Surveys on Page 211, in the Office of the Register of Deeds in Elkhorn, Wisconsin being a parcel of land located in the Southeast 1/4 of Section 8, T 2 N, R 15 E, Walworth County, Wisconsin,

and that the map shown above is a true representation thereof and shows the size and location of the property, its exterior boundaries, the location of all visible structures and dimensions of all principal buildings thereon, boundary fences, apparent easements, roadways and visible encroachments, if any, and that I have surveyed the property hereon described according to the official records, to the best of my knowledge and belief.
August 24, 1984

George T. Dunham
George T. Dunham, Surveyor

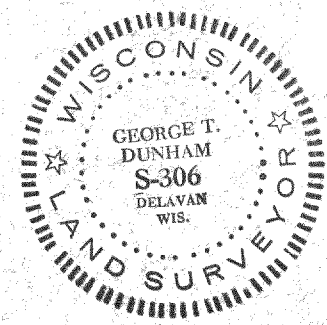

600
215-223