


○

Surveyed for: **Mary Brusa**
N2626 Elm Ridge Road
Delavan, Wisconsin. 53115

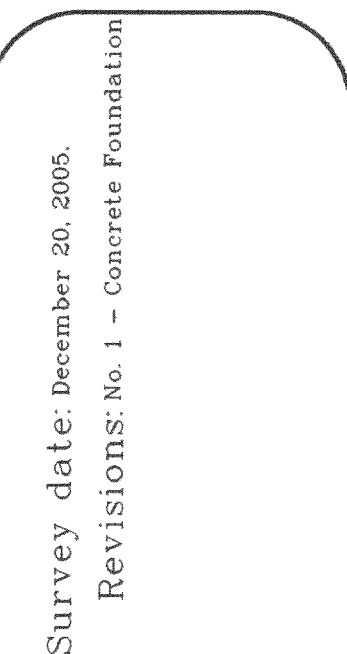

45 South Wisconsin Street P.O. Box 322
Elkhorn, Wisconsin. 53121
Telephone: (262) 723-3434
Facsimile: (262) 723-8044

Sheet 1 of 1 Sheets.

Job Reference Number
2005.173

2005.173