
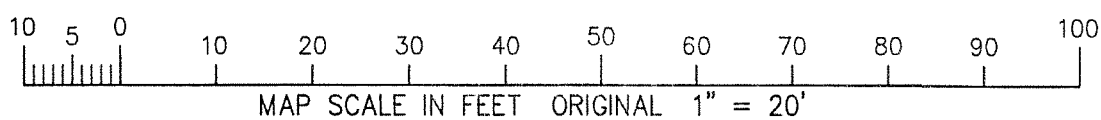
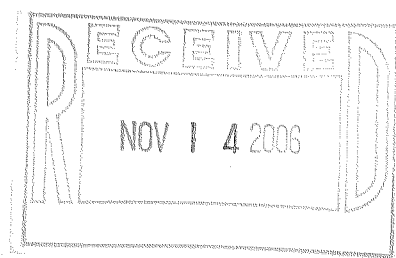
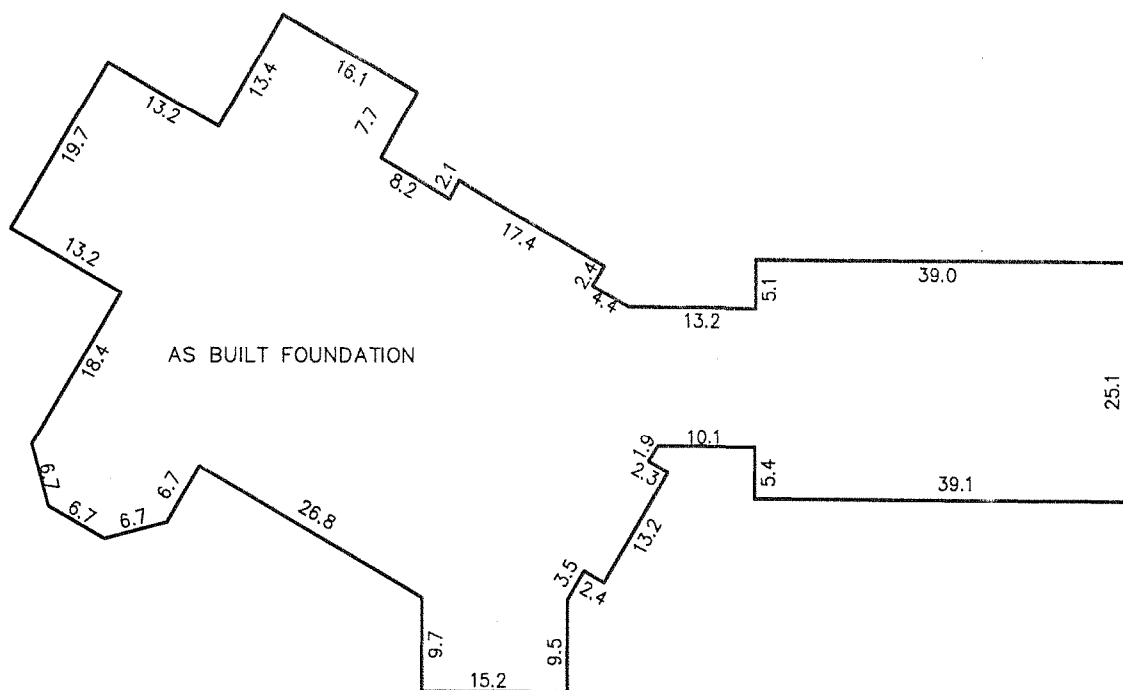
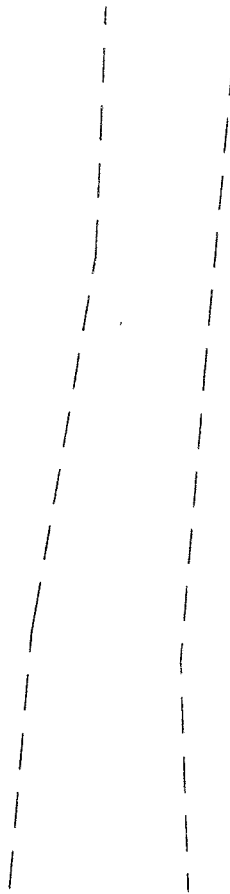


FARRIS, HANSEN & ASSOCIATES, INC.






ENGINEERING — ARCHITECTURE — SURVEYING
7 RIDGWAY COURT — P.O. BOX 437 — ELKHORN, WISCONSIN 53121
PHONE: (262) 723-2098 FAX: (262) 723-5886

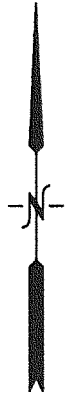

PROJECT: 6453.5
DATE: 07-10-2006
SHEET 2 OF 2

FARRIS, HANSEN & ASSOCIATES, INC.

ENGINEERING — ARCHITECTURE — SURVEYING
7 RIDGWAY COURT — P.O. BOX 437 — ELKHORN, WISCONSIN 53121
PHONE: (262) 723-2098 FAX: (262) 723-5886

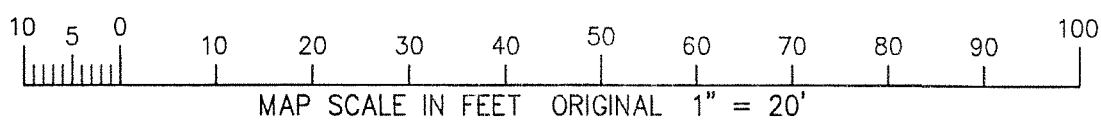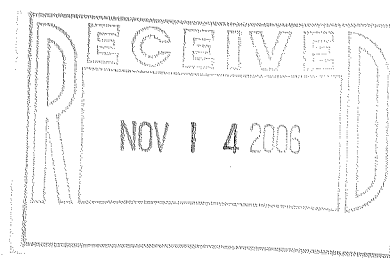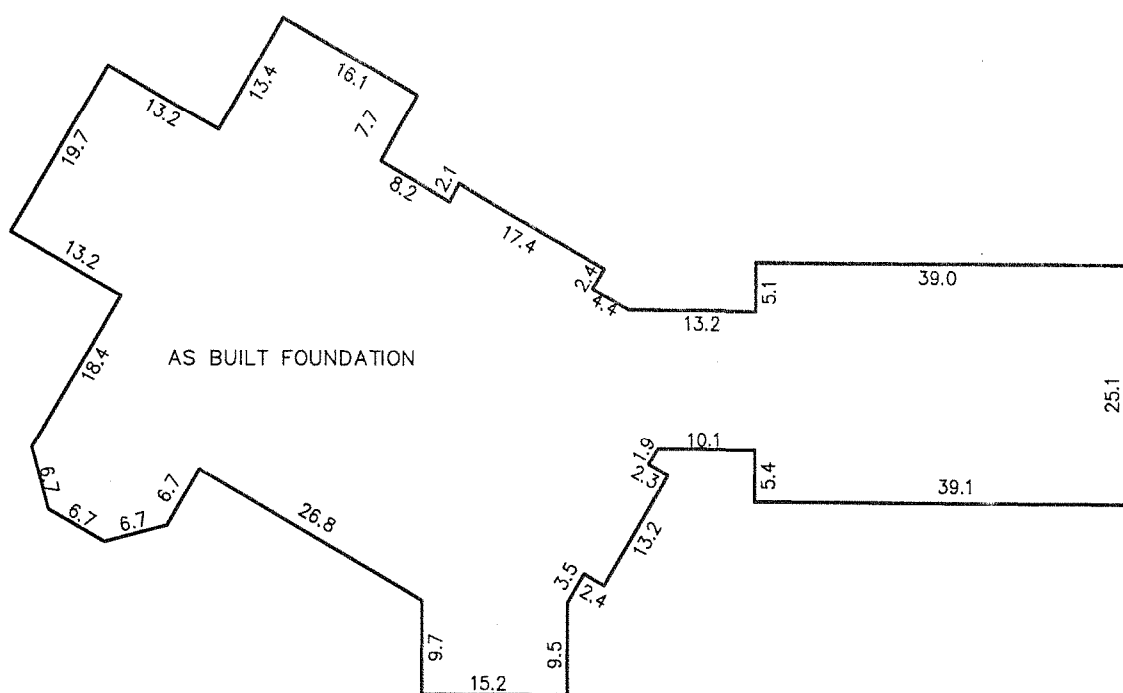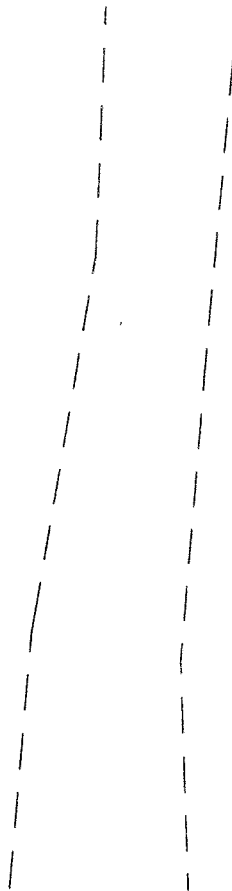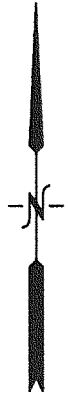

PROJECT: 6453.5
DATE: 07-10-2006
SHEET 2 OF 2