


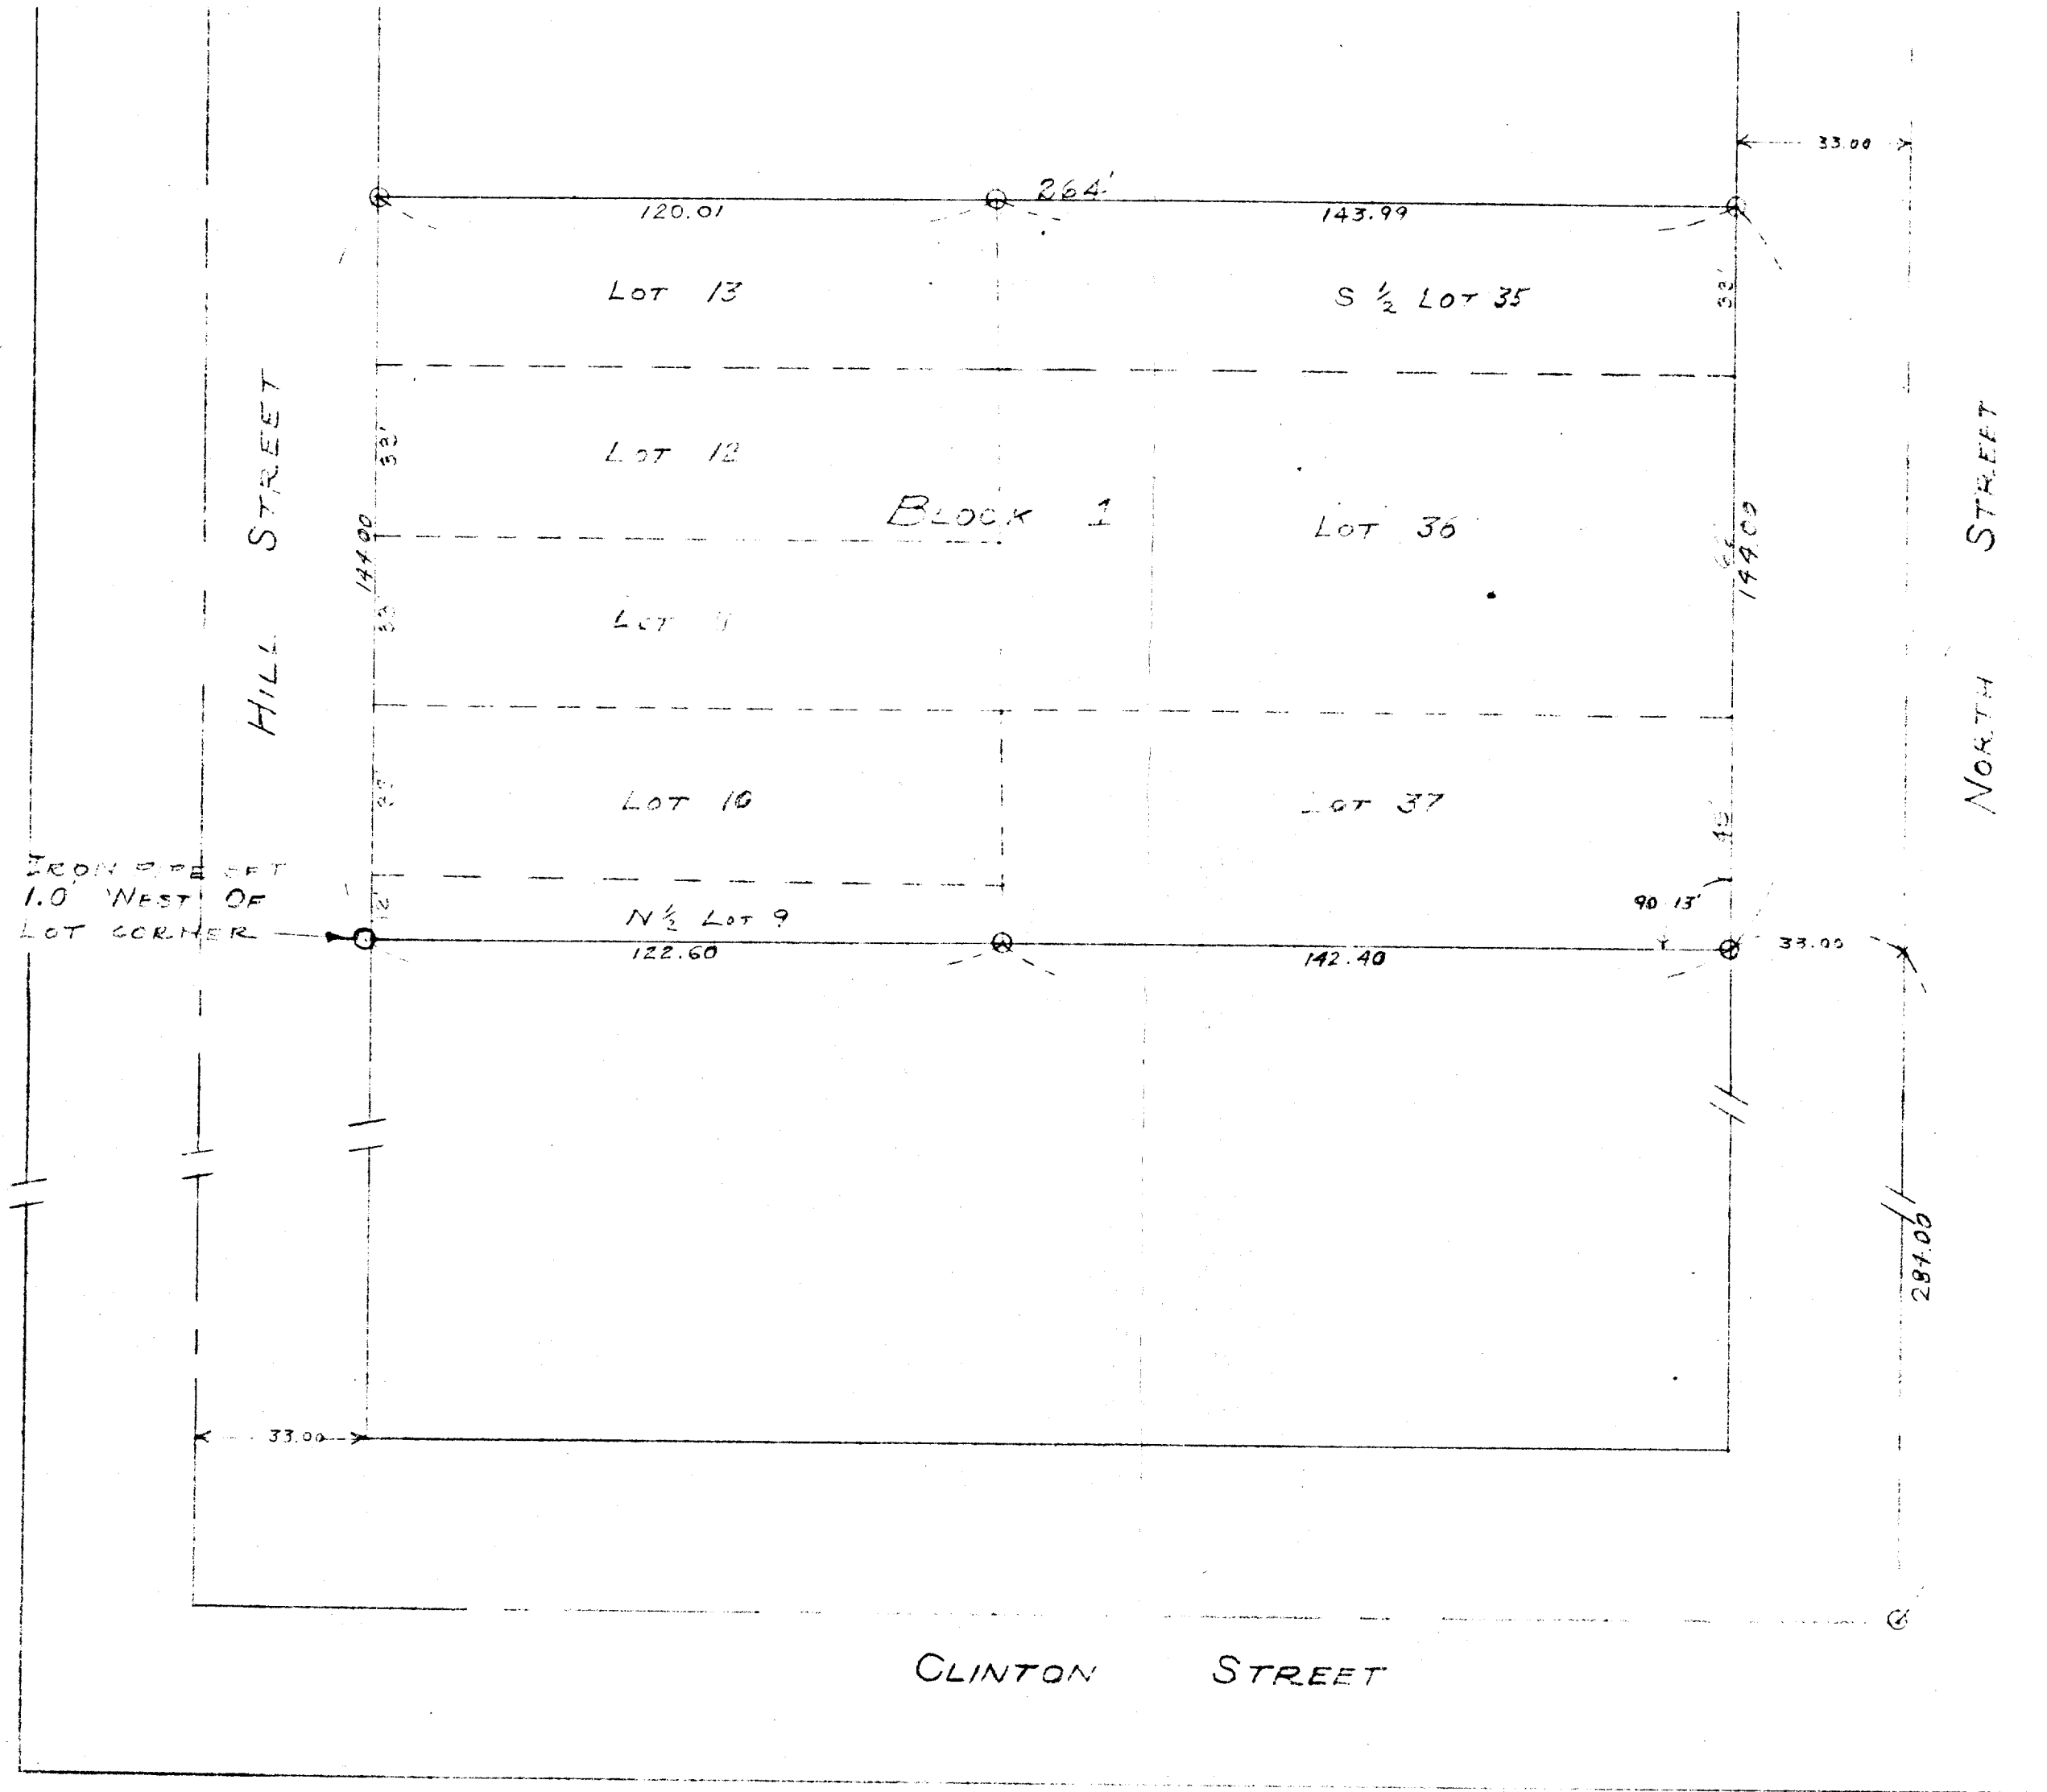

AGV-4

PLAT OF SURVEY OF LAND OWNED
BY WILLIAM J. BRACKER IN
SIDNEY ALLEN'S ADDITION TO THE
VILLAGE OF ALLEN GROVE
JUNE 13, 1951

WALWORTH COUNTY SURVEYOR

215-7.1