

PLAT OF SURVEY

- OF -

LOT 1,2,14 AND 15, BLOCK 4, SIDNEY ALLEN'S ADDITION TO
ALLENS GROVE , LOCATED IN SECTION 31, TOWN 2 NORTH,
RANGE 15 EAST, TOWN OF DARIEN, COUNTY OF WALWORTH
AND STATE OF WISCONSIN.

PATHFINDER SURVEYING INC.

(formerly)


J.K. SURVEYING INC.

P.O BOX 322

LAKE GENEVA, WI. 53147

WWW.PATHFINDERSURVEYING.NET

262-248-8303

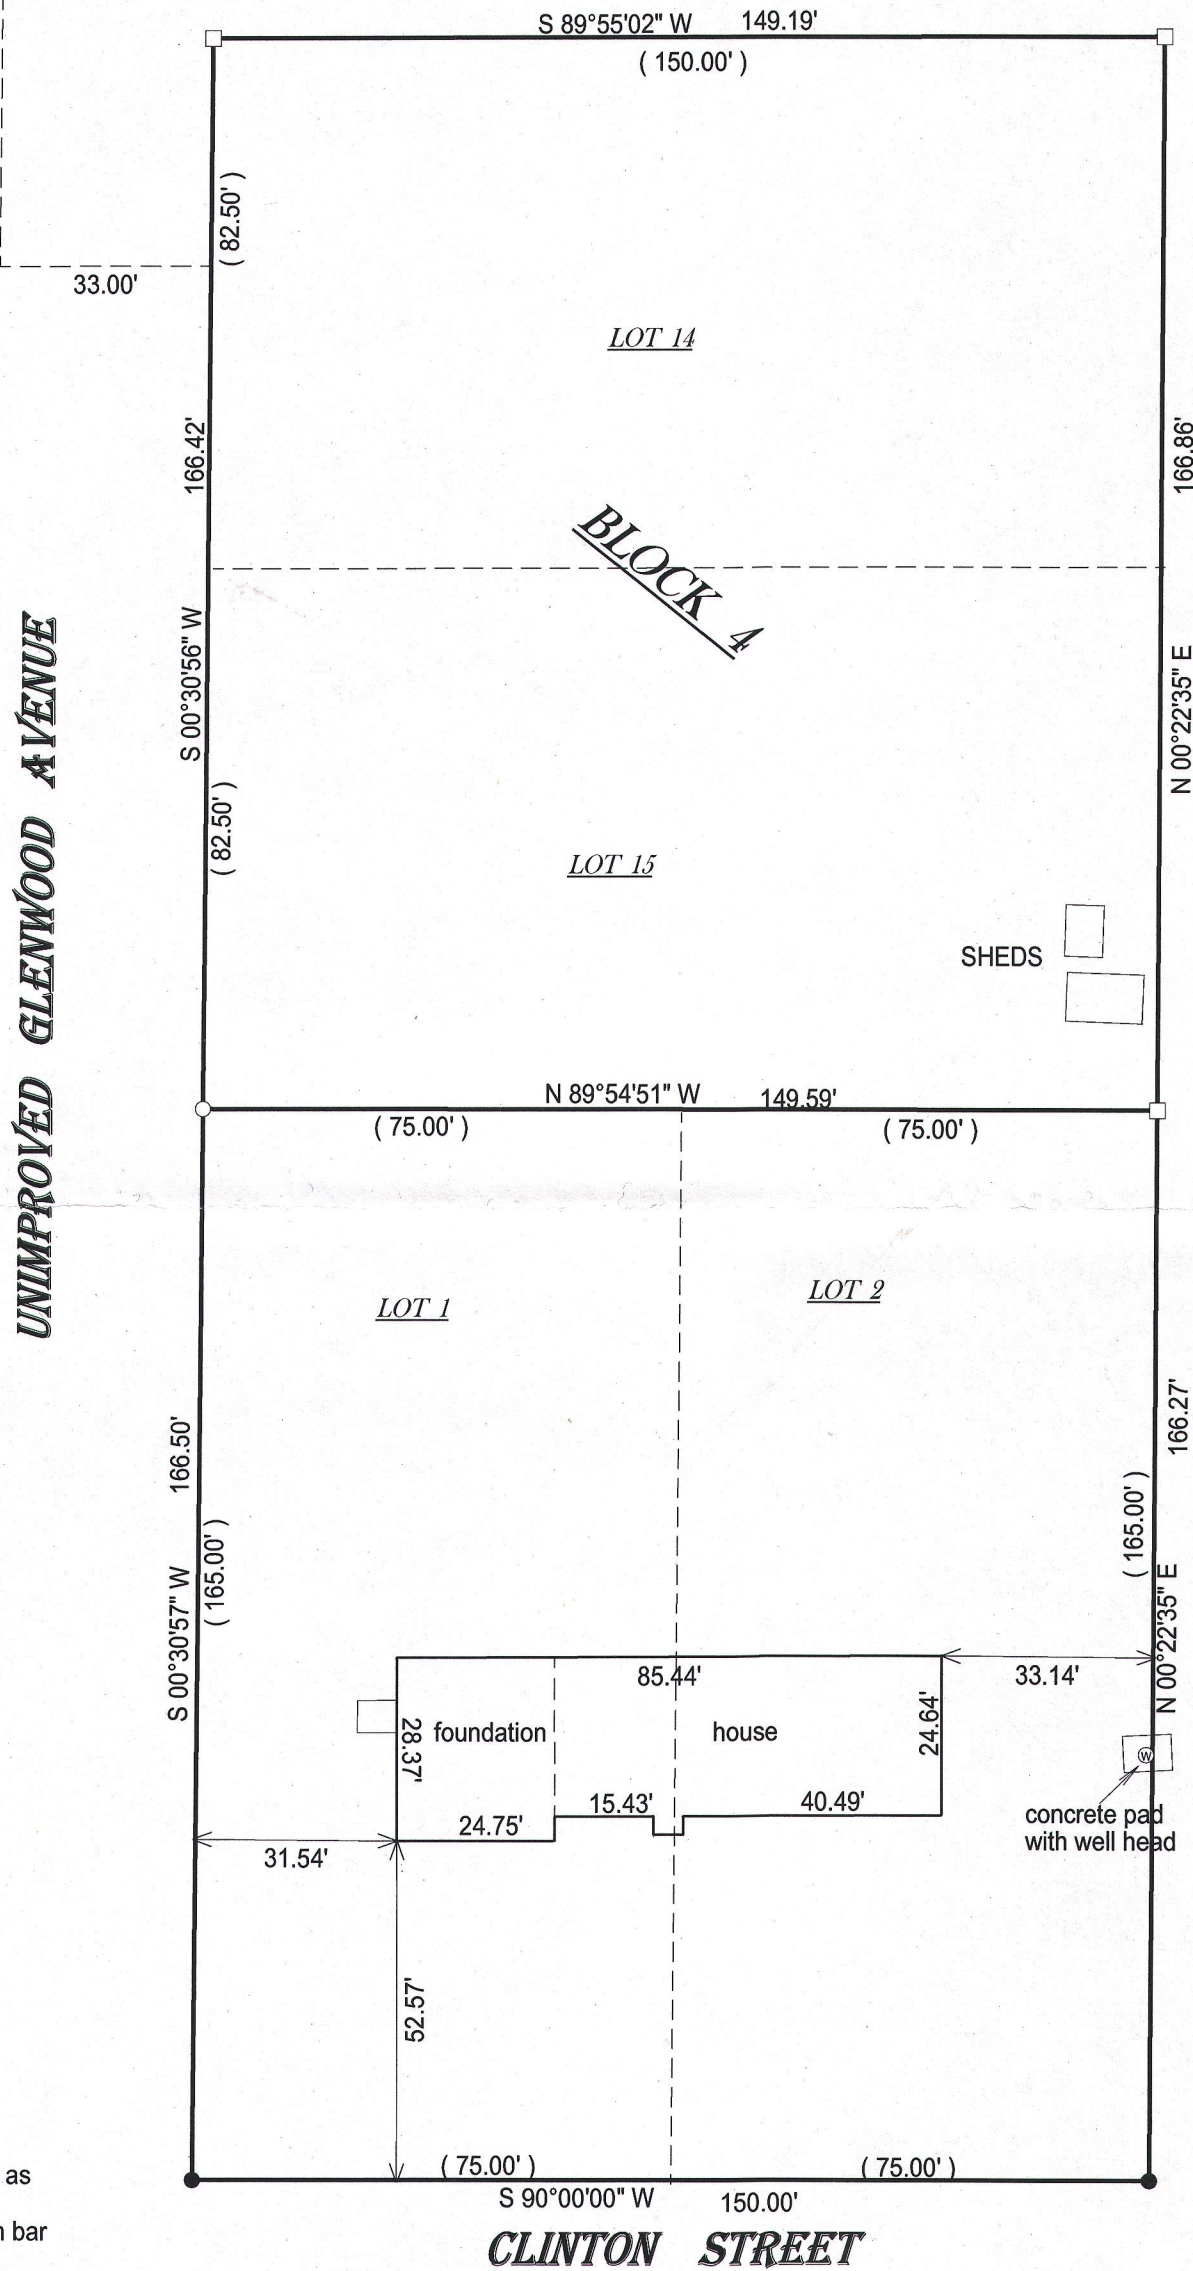

() = recorded as

☐ = found iron bar

○ = found iron pipe

● = set iron pipe

■ = set iron bar

SCALE 1" = 30'

JOB # 15-384

TAX ID #




BAGV 00013B / 00013B1

BASIS OF BEARING OF THIS PLAT: CLINTON ST. WAS ASSUMED
TO BEAR EAST / WEST.

I hereby certify that I have surveyed the above- described property and the above map is a true representation thereof and shows the size and location of the property, its exterior boundaries, the location and dimensions of all structures thereon, fences, apparrant easements and roadways and visible encroachments if any.

This survey is made for the present owners of the property, and those who purchase, mortgage, or guarantee the title thereto, within one year from the date hereof. DATED THIS 20TH DAY OF DECEMBER, 2015

DATED THIS 20TH DAY OF DECEMBER, 2015.

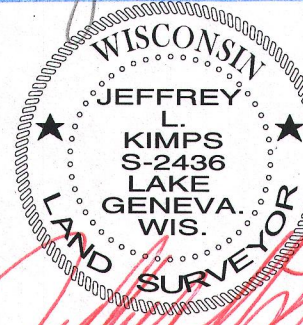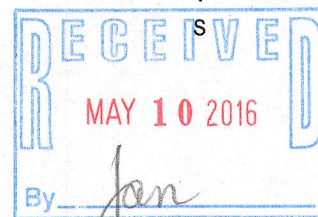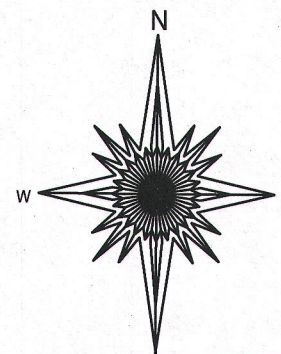

JEFFREY L KIMPS S - 2436
Wisconsin Professional Land Surveyor
(original if signed in red)