




Scale - 1" = 200'  
○ = Iron Pipe  
● = Concrete Monument

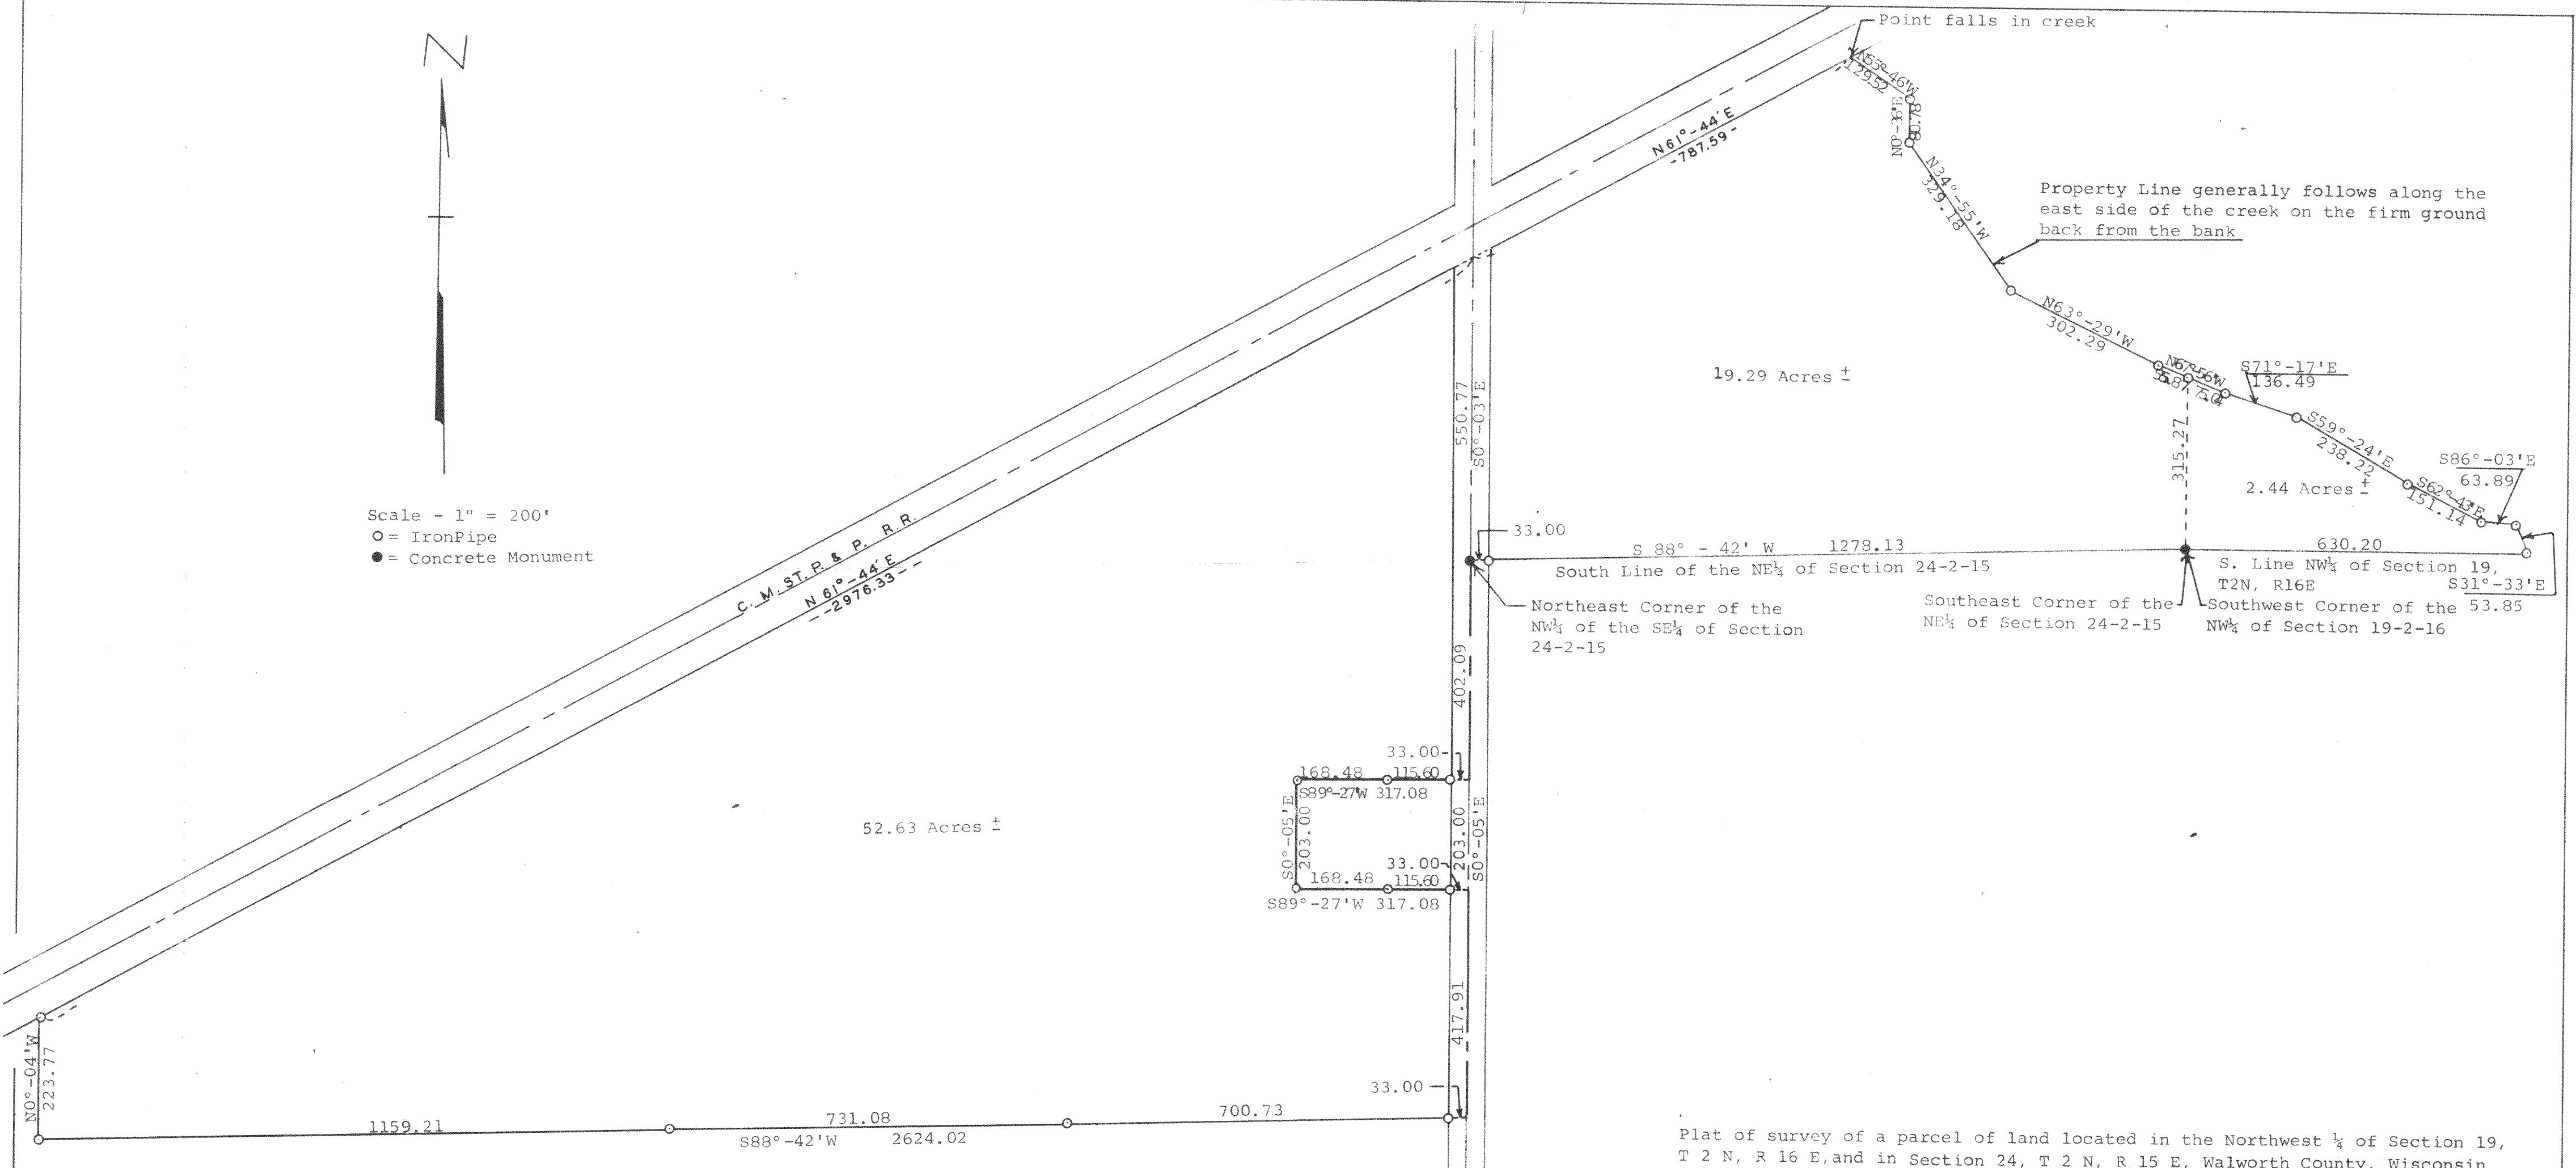

Plat of survey of a parcel of land located in the Northwest 1/4 of Section 19, T 2 N, R 16 E, and in Section 24, T 2 N, R 15 E, Walworth County, Wisconsin.

June 14, 1969

*George T. Dunham*  
George T. Dunham, Surveyor

10-24-21  
10-24-21  
10-24-21  
XWUP-127 City of Delavan