

Plat of Survey


of

Lots 6 and 7 of the Annex to Inlet Oaks,

a subdivision located in the Northeast 1/4 of the Northeast 1/4 of Section 22,
Town 2 North, Range 16 East, Town of Delavan, Walworth County, Wisconsin.

Surveyed for: **Keefe Real Estate, Inc.**

416 Bauer Parkway
Delavan, Wisconsin. 53115

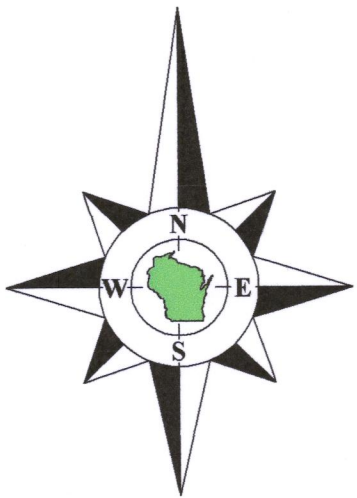


Bearings referenced to the South line of the North
1/2 of Lot 3 of the Annex to Inlet Oaks, recorded
as N89°28'30"W on prior surveys of record. A
rotation of 4°09'29" from the Wisconsin State
Plane Coordinate System, South Zone, (NAD-27).

Coordinates are referenced to the Wisconsin State
Plane Coordinate System, South Zone, (NAD-27).

Survey Date: April 23, 2019.

Revisions:

Scale in Feet
1" = 20'

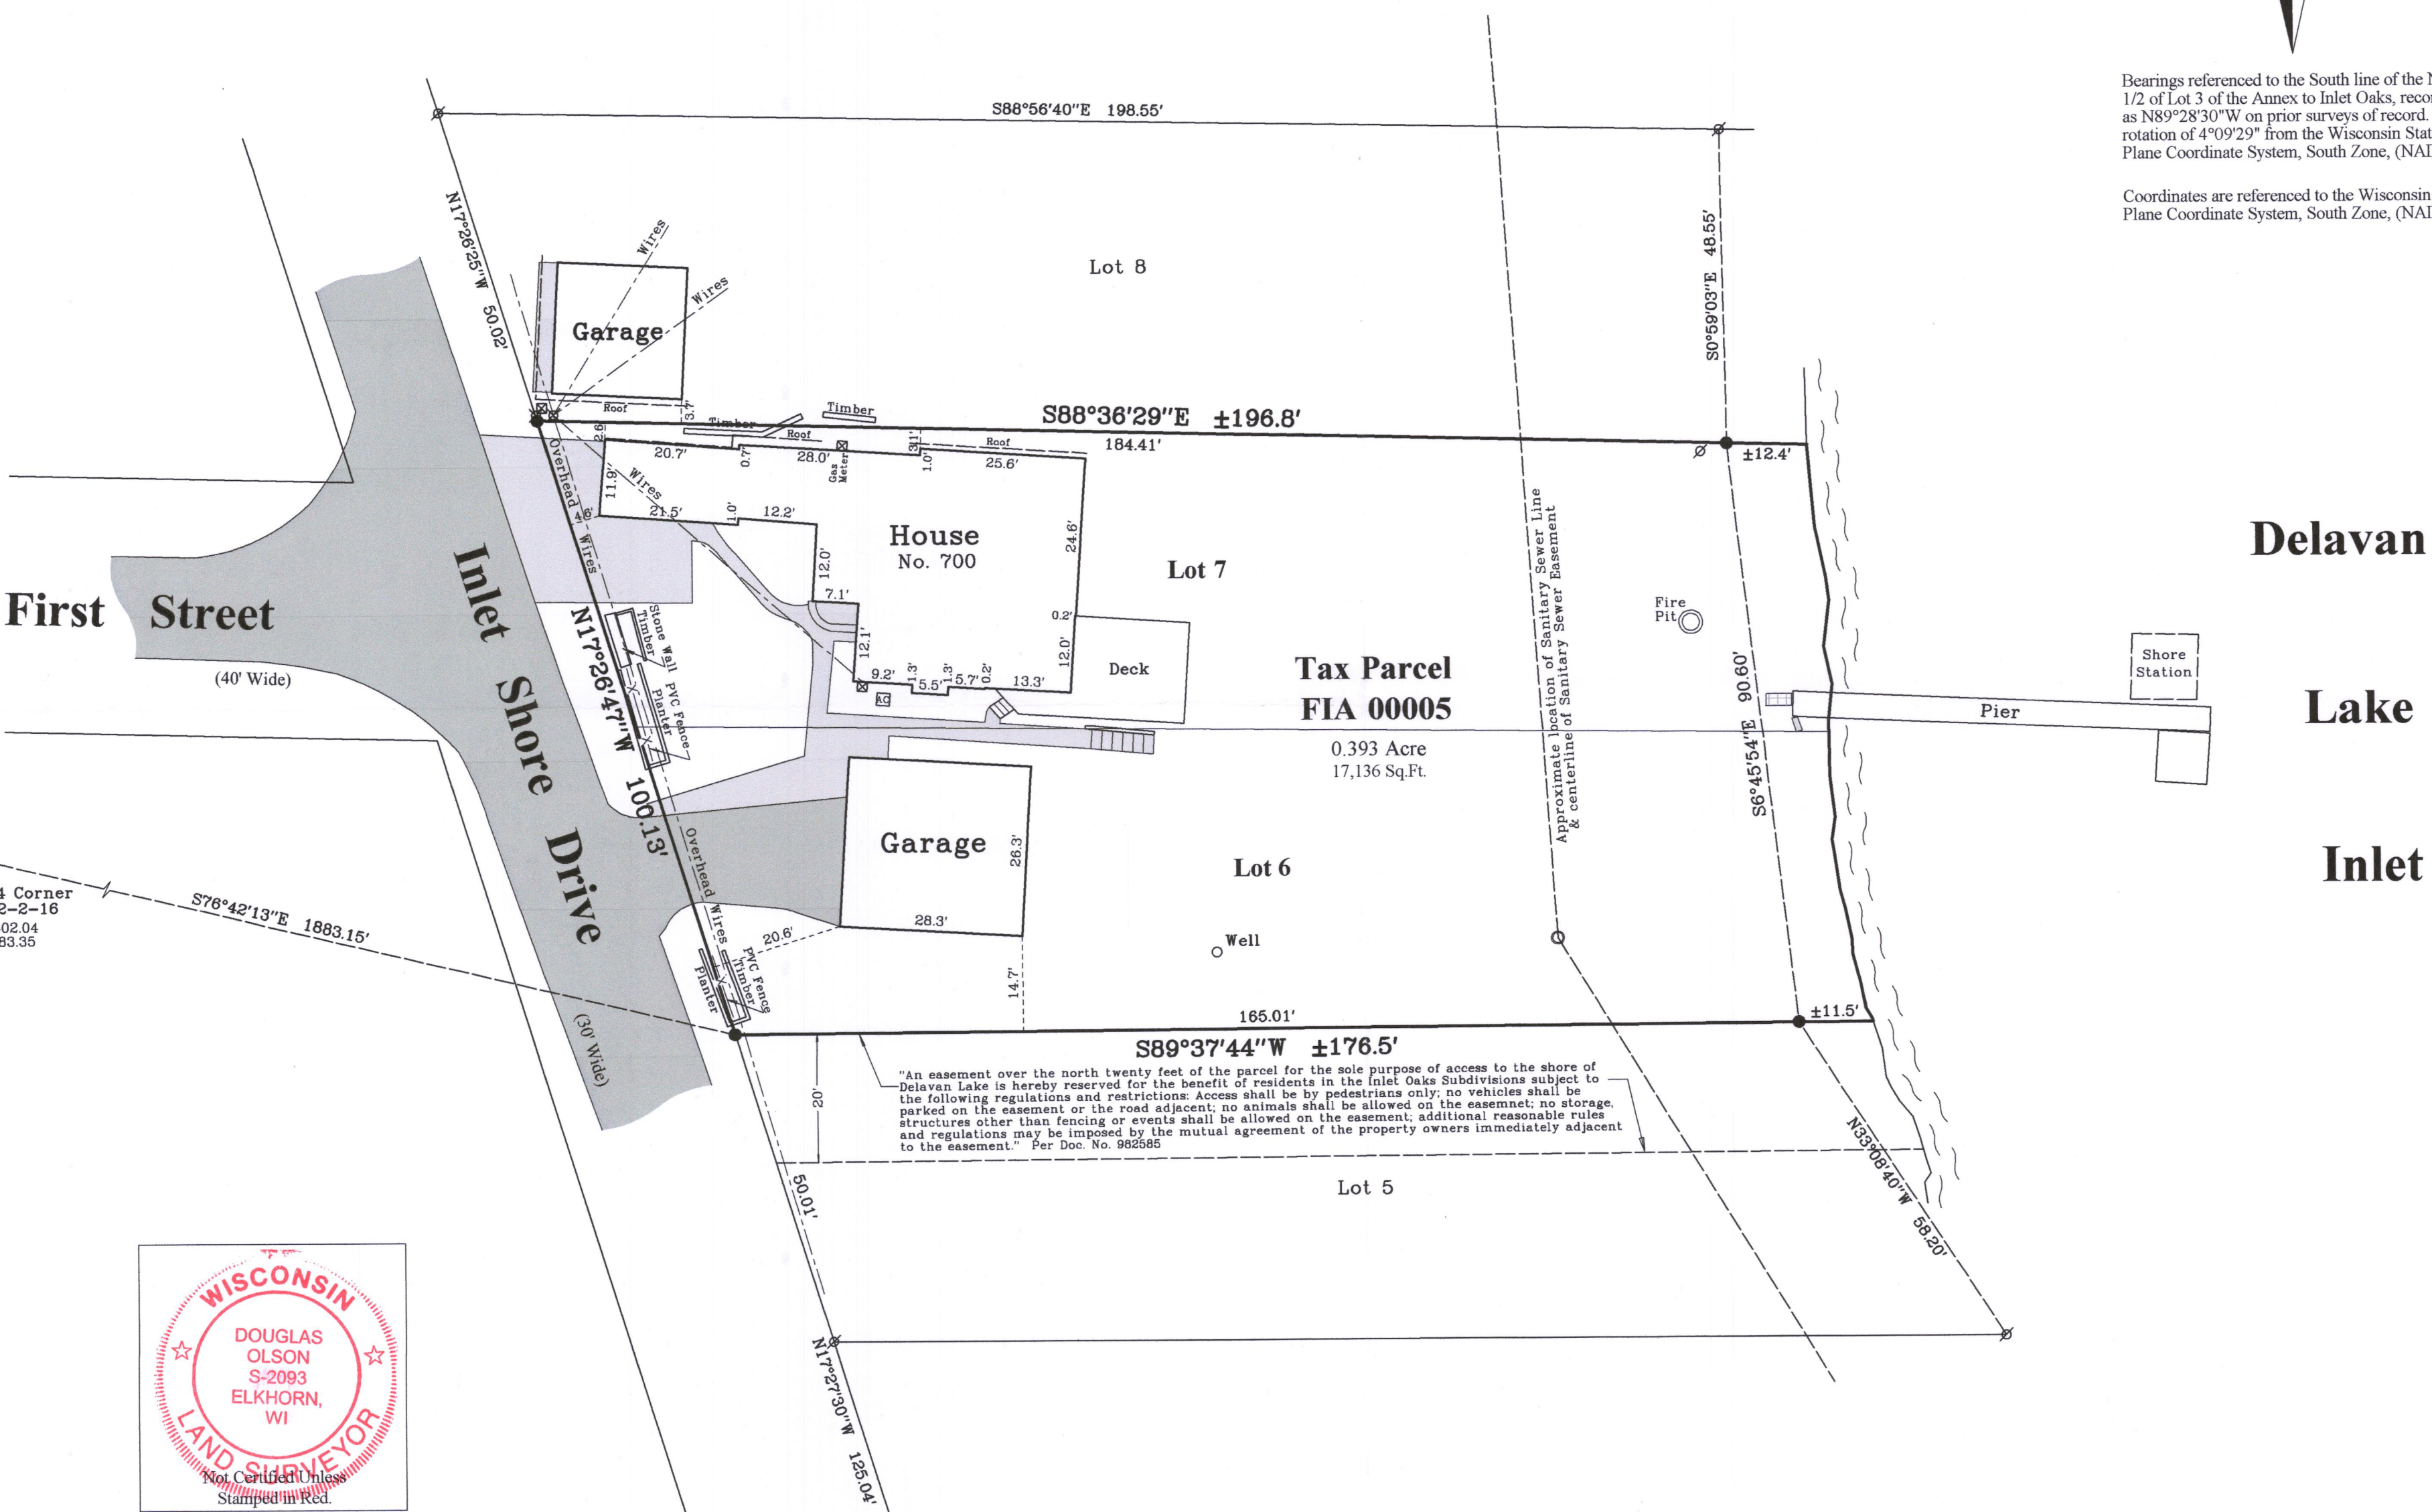

North 1/4 Corner
Section 22-2-16
N. 231,402.04
E. 2,379,483.35



Notes:

- 1) This Plat of Survey is not certified unless signed and sealed in red ink.
- 2) This survey is subject to Wisconsin lien laws. This Plat of Survey is the notice of intent to file lien. Lien waiver required.
- 3) The Survey Date shown on this Plat of Survey is the completion date of the field work.



Copyright ©2017 by Olson Land Surveying, LLC.

All rights reserved. No part of this survey plat may be reproduced or transmitted in any form by any means - graphic, electronic, or mechanical, including photocopying, tracing, or information storage and retrieval systems - without permission in writing from Douglas G. Olson, Olson Land Surveying, LLC.

I hereby certify that I have surveyed the above described property in compliance with Chapter A-E 7 of the Wisconsin Administrative Code and that the map hereon is correct to the best of my professional knowledge and belief and shows the size and location of the property, its exterior boundaries, the location and dimensions of all visible structures thereon, boundary fences, apparent easements and roadways and visible encroachments, if any.

This survey is made for the exclusive use of the present owners of the property, and also those who purchase, mortgage or guarantee title thereto, within one year from the date hereof.

Douglas G. Olson
Wisconsin Professional Land Surveyor - 2093

45 South Wisconsin Street | P.O. Box 322
Elkhorn, Wisconsin. 53121
Telephone: (262) 723-3434
Facsimile: (262) 723-8044
Email: doug@olsonsurveying.com
Website: www.olsonsurveying.com

OLSON
LAND SURVEYING, LLC
Rural | Residential | Commercial

Legend of Symbols & Abbreviations	
N	North
S	South
E	East
W	West
in	Inches
ft	Feet
mi	Miles
deg	Degrees
min	Minutes
sec	Seconds
Found	Found
County	County
Section	Section
Corner	Corner
Found	Found
Iron	Iron
Pipe	Pipe
Found	Found
Iron	Iron
Post	Post
Found	Found
Iron	Iron
Pole	Pole
Found	Found
Utility	Utility
Pole	Pole
Found	Found
Manhole	Manhole
Found	Found
Asphalt	Asphalt
Surface	Surface

Sheet 1 of 1 Sheets
Drawing Name:
Job Reference Number
2019.043

2019.043

FIA-5

215-817