


of

recorded in Vol. 32 of Certified Survey Maps of Walworth County on Page 136 and located in the Northwest 1/4 of the Northwest 1/4 of Section 13, Town 2 North, Range 15 East, Town of Darien, Walworth County, Wisconsin.

W7664 Highway 11
Delavan, Wisconsin. 53115

Northwest Corner
Section 13-2-15
N. 235,959.01
E. 2,355,596.17

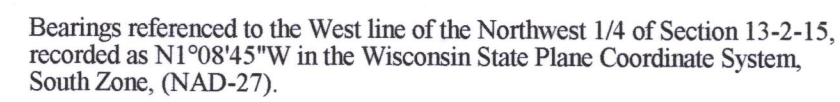


Coordinates are referenced to the Wisconsin State Plane Coordinate System, South Zone, (NAD-27).

Lot 1
C.S.M. 1969

West line of the Northwest 1/4 of Section 13-2-15.
S1°08'45"E 2639.56'
recorded as(S1°08'45"E 2639.31')State Plane
recorded as(S°08'30"E 2639.67')ROW Plat
1118.98'
(1118.98')ROW Plat

1520.58'
(1520.69') ROW Plat

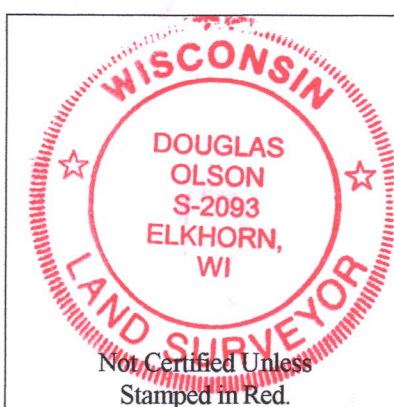

Notes:

- 1) This Plat of Survey is not certified unless signed and sealed in red ink.
- 2) This survey is subject to Wisconsin lien laws. This Plat of Survey is the notice of intent to file lien. Lien waiver required.
- 3) The Survey Date shown on this Plat of Survey is the completion date of the field work.

I hereby certify that I have surveyed the above described property in compliance with Chapter A-E 7 of the Wisconsin Administrative Code and that the map hereon is correct to the best of my professional knowledge and belief and shows the size and location of the property, its exterior boundaries, the location and dimensions of all visible structures thereon, boundary fences, apparent easements and roadways and visible encroachments, if any.

This survey is made for the exclusive use of the present owners of the property, and also those who purchase, mortgage or guarantee title thereto, within one year from the date hereof.

Douglas G. Olson
Wisconsin Professional Land Surveyor - 2093

(N0°35'E)
100 50' 100 50'

Tax Parcel
BD 1300006

Copyright ©2018 by Olson Land Surveying, LLC.

All rights reserved. No part of this survey plat may be reproduced or transmitted in any form by any means - graphic, electronic, or mechanical, including photocopying, tracing, or information storage and retrieval systems - without permission in writing from Douglas G. Olson, Olson Land Surveying, LLC.

Lot 1
C.S.M. 1969

(S89°25'E)
N88°48'13"E 315.00'

Tax Parcel
BD 1300006

S1°10'00"E 277.16'

Tax Parcel
BD 1300006

45 South Wisconsin Street | P.O. Box 322
Elkhorn, Wisconsin. 53121
Telephone: (262) 723-3434
Facsimile: (262) 723-8044
Email: doug@olsonsurveying.com
Website: www.olsonsurveying.com

OLSON
LAND SURVEYING, LLC
Rural | Residential | Commercial

Legend of Symbols & Abbreviations	
Found County Section Corner	N North
Found Iron Pipe	E East
Set Iron Pipe, 1" dia.	W West
Set Iron Pipe, 2" dia.	In Bearings
Unneeded Information	" " Bearings
Utility Pedestal	" " Meters
Utility	" " Distances
Concrete Cover	In Distances
Asphalt Surface	" Feet
Concrete Surface	" Feet
Gravel Surface	" Feet

Sheet 1 of 1 Sheets

Drawing Name:

Job Reference Number
2017.149

2017.149

Survey Date: February 26, 2018.

Revisions: No. 1 - Larger parcel to include septic field.
No. 2 - Approx. location of septic system scaled from permit.
No. 3 - Larger parcel to include septic field.
No. 4 - Recorded C.S.M.

Scale in Feet
1" = 20'

0' 10' 20' 40' 60'

45 South Wisconsin Street | P.O. Box 322
Elkhorn, Wisconsin. 53121
Telephone: (262) 723-3434
Facsimile: (262) 723-8044
Email: doug@olsonsurveying.com
Website: www.olsonsurveying.com