

Plat of Survey

of


Lot 2 of Lawson Creek Woods, A Subdivision,

located in the Southwest 1/4 of the Southeast 1/4 of Section 14, Town 2 North,
Range 15 East, Town of Darien, Walworth County, Wisconsin.

Surveyed for: **Tim & Maria DeJong**
N3754 Kendall Court
Delavan, Wisconsin. 53115



Bearings referenced to the North line of Lot 2,
recorded as N86°41'45"E on the plat of Lawson
Creek Woods, A Subdivision.

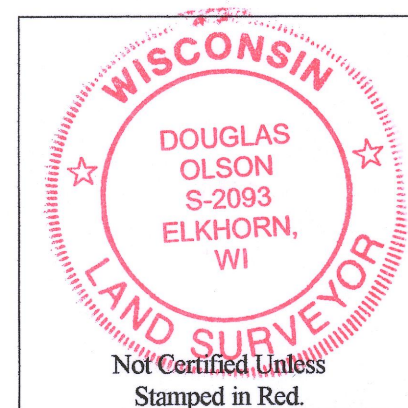

Notes:

- 1) This Plat of Survey is not certified unless signed and sealed in red ink.
- 2) This survey is subject to Wisconsin lien laws. This Plat of Survey is the notice of intent to file lien. Lien waiver required.
- 3) The Survey Date shown on this Plat of Survey is the completion date of the field work.


Copyright © 2020 by Olson Land Surveying, LLC.

All rights reserved. No part of this survey plat may be reproduced or transmitted in any form by any means - graphic, electronic, or mechanical, including photocopying, tracing, or information storage and retrieval systems - without permission in writing from Douglas G. Olson, Olson Land Surveying, LLC.

I hereby certify that I have surveyed the above described property in compliance with Chapter A-E 7 of the Wisconsin Administrative Code and that the map hereon is correct to the best of my professional knowledge and belief and shows the size and location of the property, its exterior boundaries, the location and dimensions of all visible structures thereon, boundary fences, apparent easements and roadways and visible encroachments, if any.

This survey is made for the exclusive use of the present owners of the property, and also those who purchase, mortgage or guarantee title thereto, within one year from the date hereof.

Douglas G. Olson
Wisconsin Professional Land Surveyor - 2093

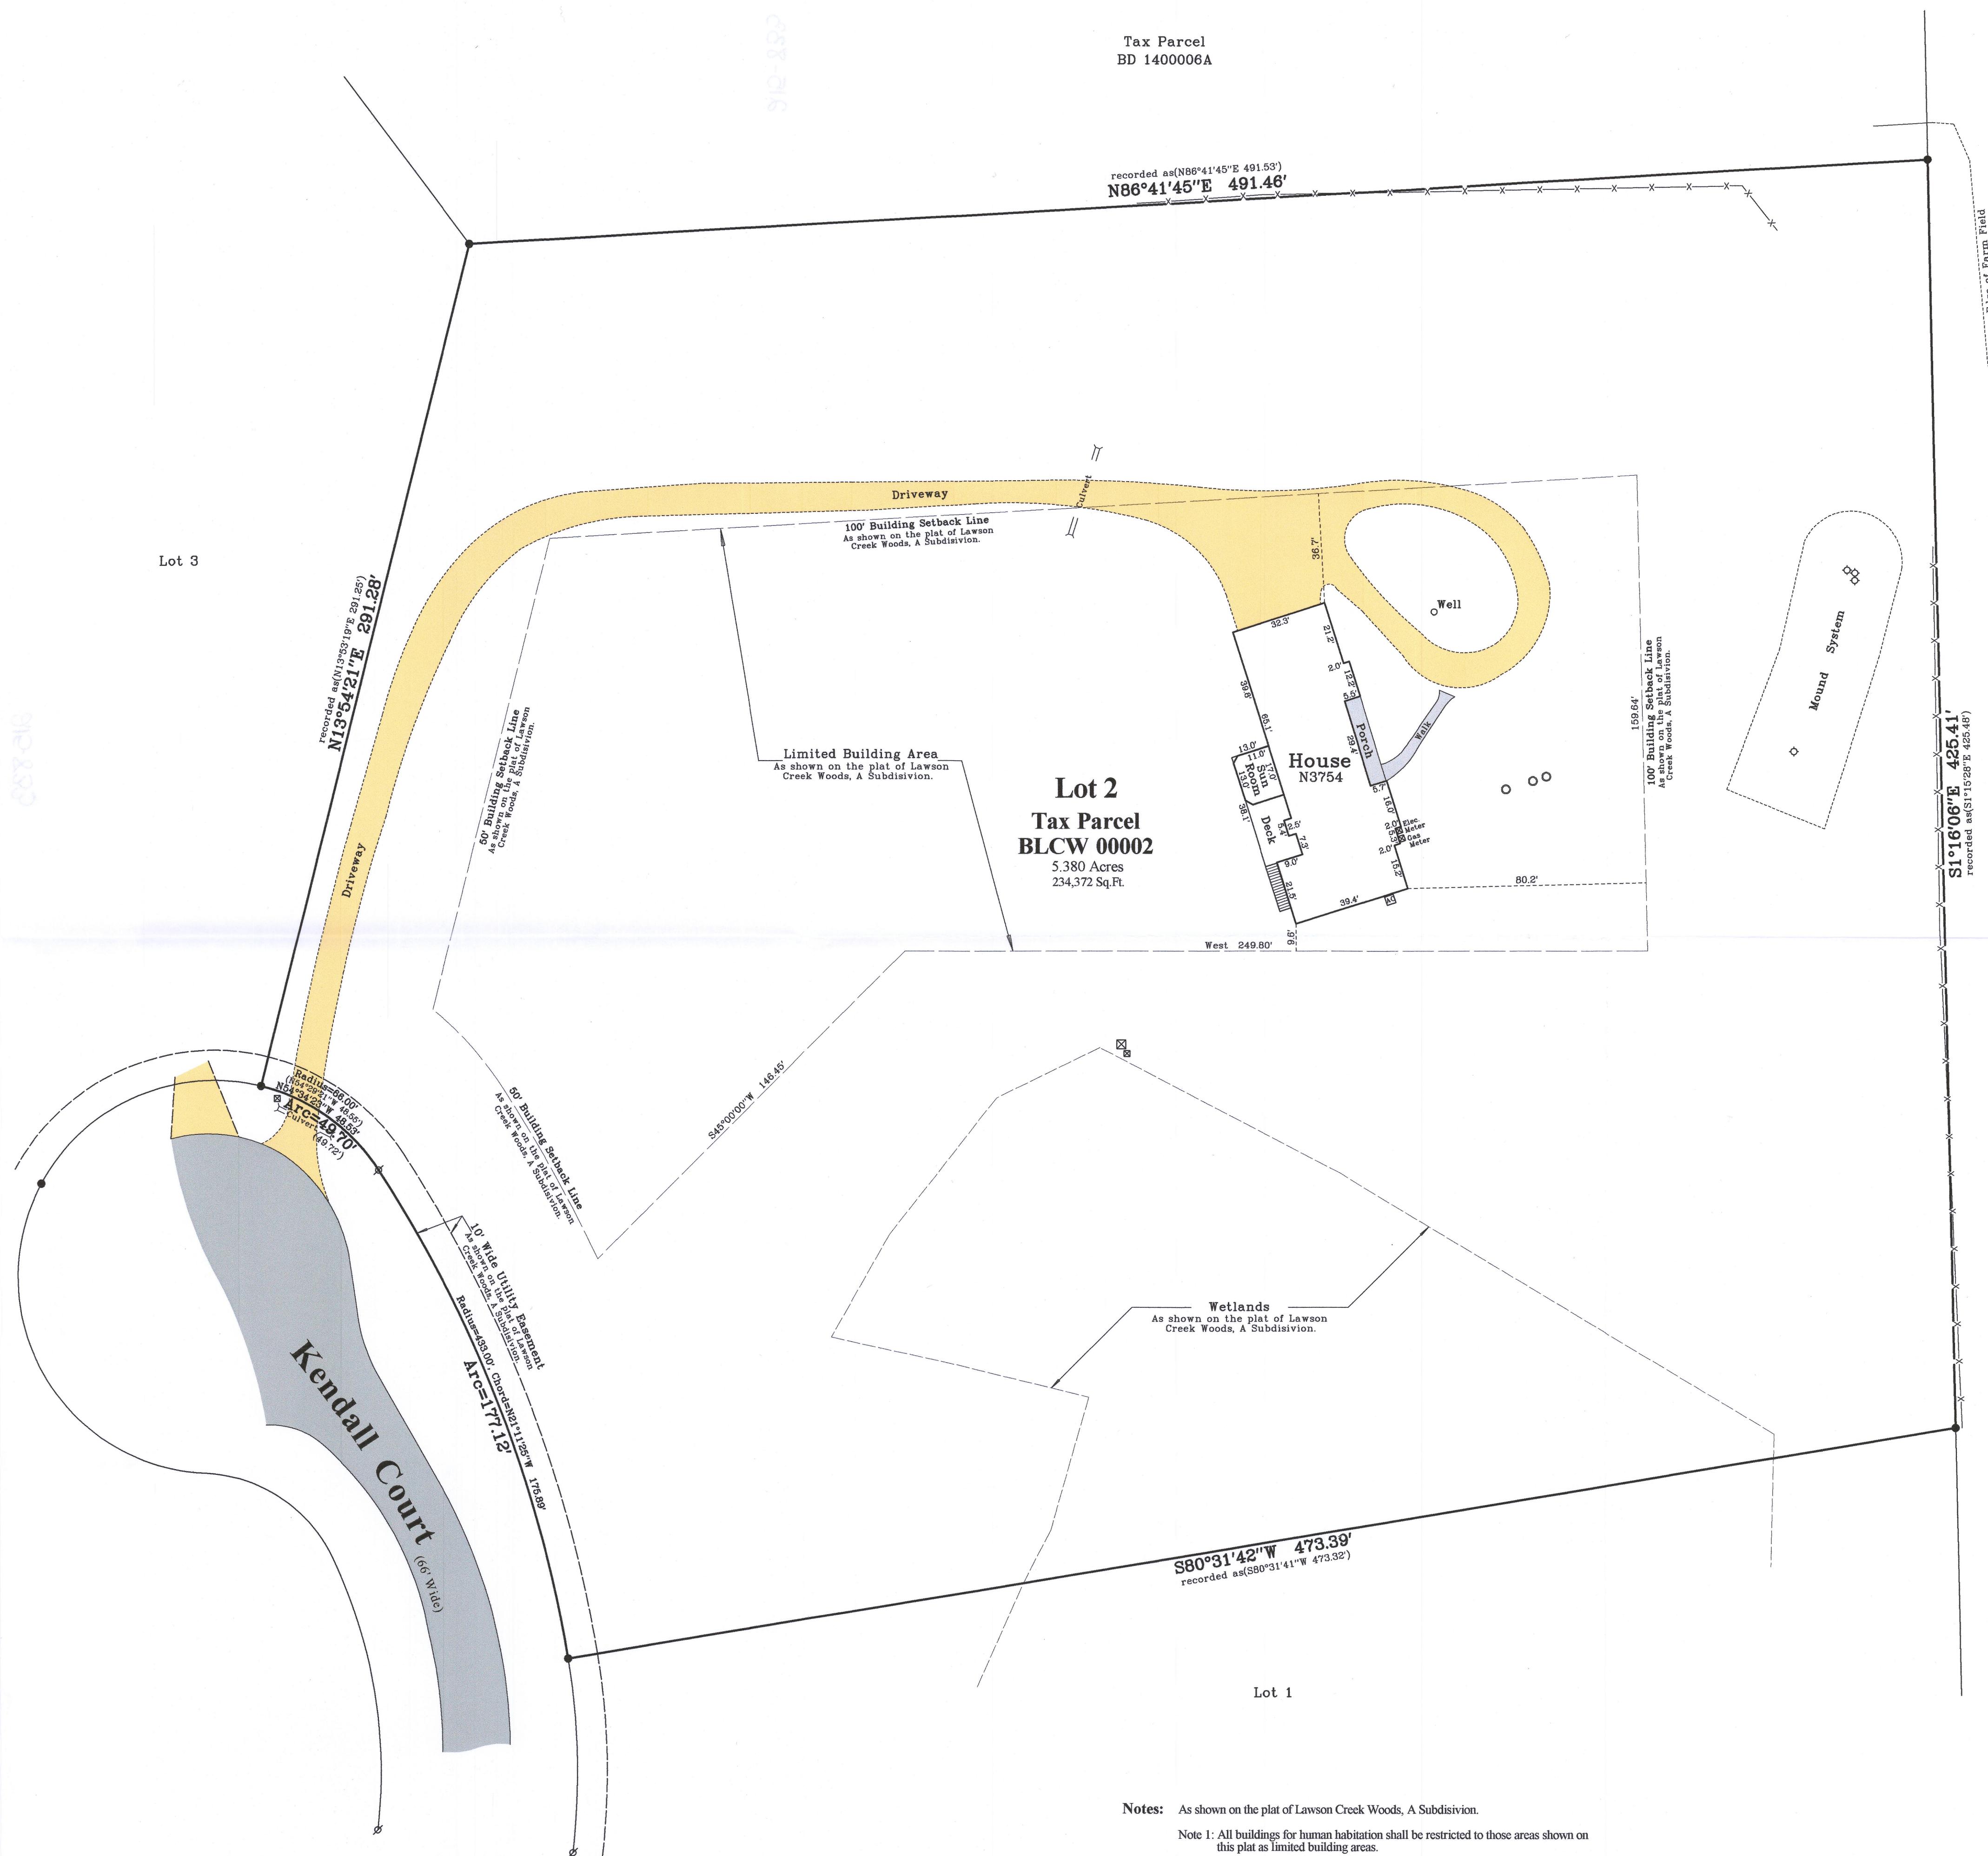

Tax Parcel
BD 1400006A

recorded as(N86°41'45"E 491.53')
N86°41'45"E 491.46'

recorded as(N13°54'21"E 291.28')
N13°54'21"E 291.28'

As shown on the plat of Lawson
Creek Woods, A Subdivision.

Limited Building Area
As shown on the plat of Lawson
Creek Woods, A Subdivision.

Lot 2
Tax Parcel
BLCW 00002
5.380 Acres
234,372 Sq.Ft.

House
N3764

Well

Mound System

recorded as(S1°16'08"E 425.41')
S1°16'08"E 425.41'

Tax Parcel
BD 1400006B

recorded as(S80°31'41"W 473.32')
S80°31'42"W 473.39'


Notes: As shown on the plat of Lawson Creek Woods, A Subdivision.

Note 1: All buildings for human habitation shall be restricted to those areas shown on this plat as limited building areas.

Note 2: Now structures for human habitation shall be erected until such time as the requirements of ILHR 85 and the Walworth County Sanitation Ordinance have been met.

Note 3: No filling or development allowed in the wetland areas.

Survey date: December 6, 2004.
REVISIONS:
No. 1 - House staked
No. 2 - New House location
No. 3 - As-Built locations

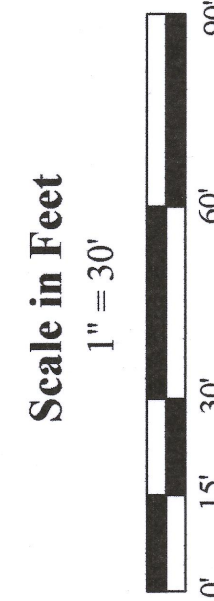

45 South Wisconsin Street | P.O. Box 322
Elkhorn, Wisconsin. 53121
Telephone: (262) 723-3434
Fax: (262) 723-8044
Email: doug@olsonsurveying.com
Website: www.olsonsurveying.com

OLSON
LAND SURVEYING, LLC
Rural | Residential | Commercial

North
Iron Rod
1 1/2" dia.
Recorded Information
Found Iron Rod 1 1/2" dia.
Recorded Information
Utility Pole
Concrete Pedestal
Concrete Pole
Septic Vent
Asphalt Surface
Gravel Surface

Legend of Symbols & Abbreviations

Sheet 1 of 1 Sheets

Job Reference Number

2020.118

2020.118