

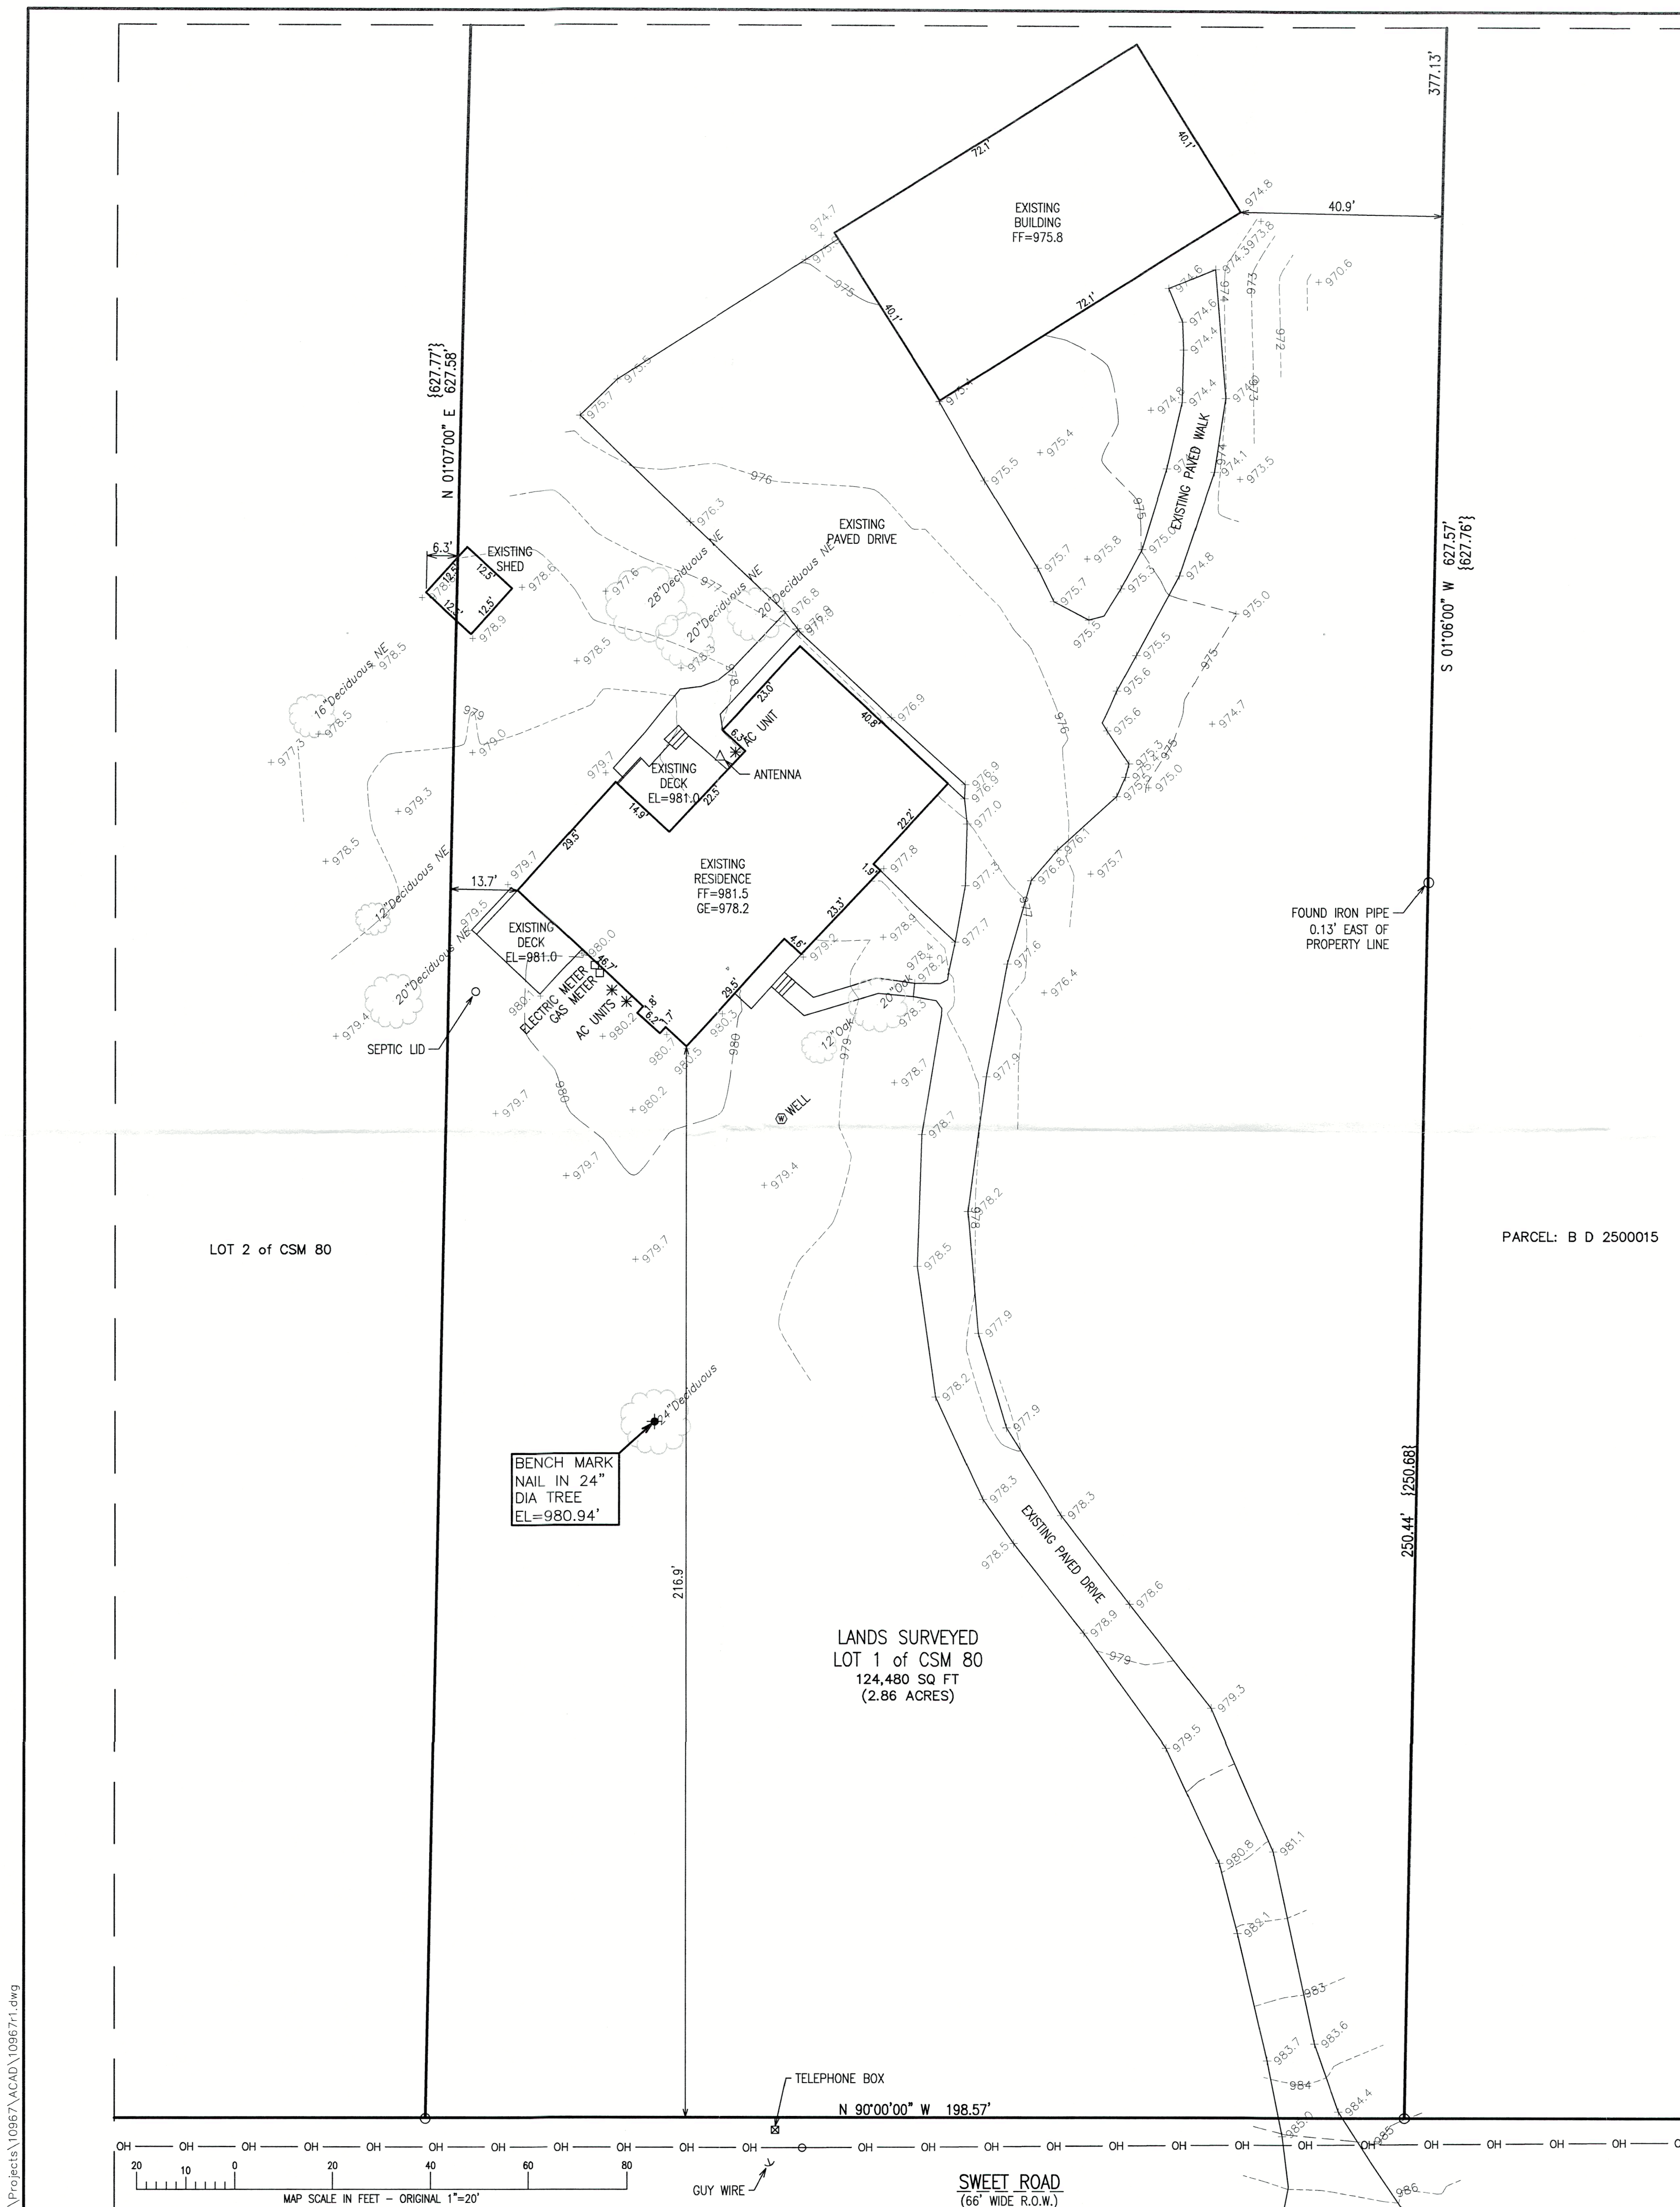


X:\Projects\10867\ACAD\10867.dwg

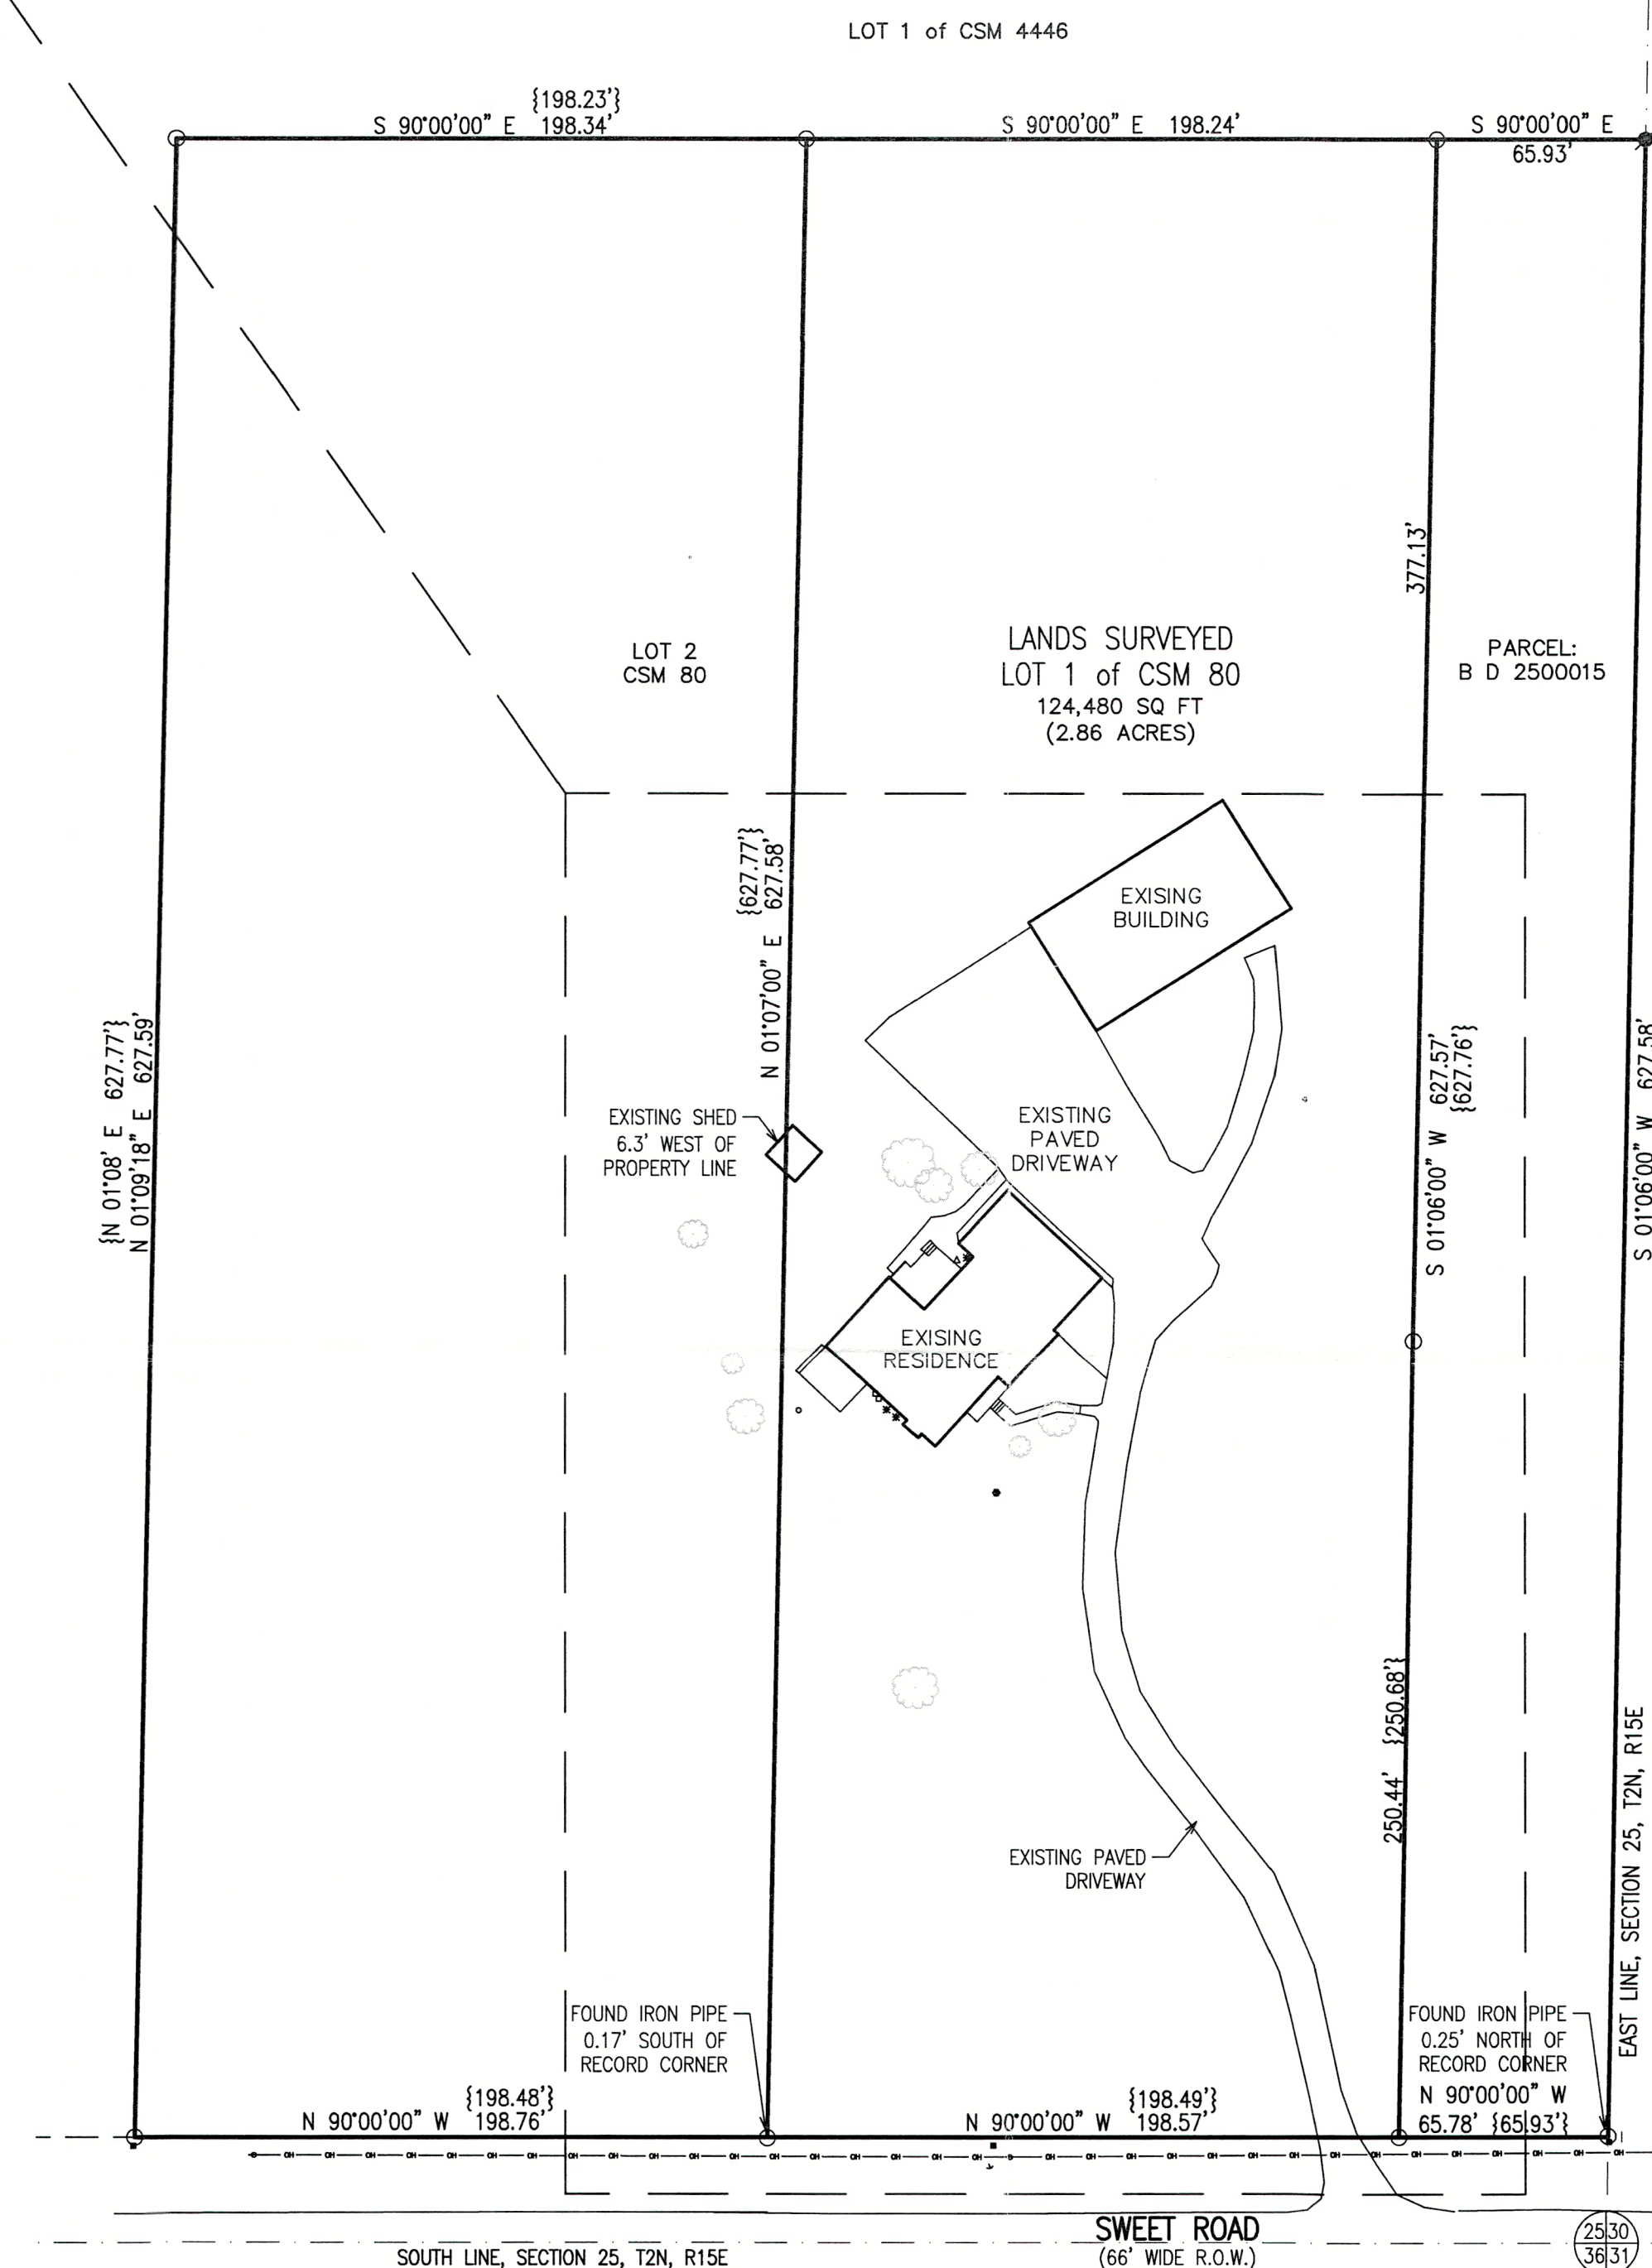

PLAT OF SURVEY LOT 1 OF CERTIFIED SURVEY MAP NO. 80

LOCATED IN THE SE 1/4 OF THE SE 1/4 OF SECTION 25, TOWN 2 NORTH, RANGE 15 EAST,
TOWN OF DARIEN, WALWORTH COUNTY, WISCONSIN

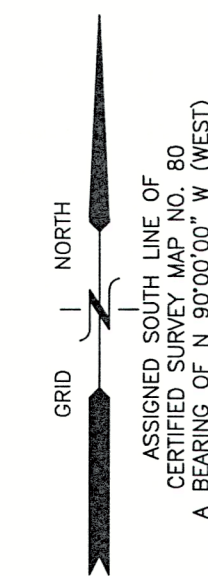

- LEGEND
- = IRON PIPE FOUND 1 3/8" O.D.
 - = IRON REBAR SET 3/4" x 18" x 1.13 lbs/ft
 - ◆ = BENCHMARK
 - ⊕ = UTILITY POLE
 - ⊗ = TELEPHONE BOX
 - {xxx} = RECORDED AS
 - FF = FIRST FLOOR ELEVATION
 - GE = GARAGE ELEVATION
 - OH — = OVERHEAD UTILITY WIRES


NOTE: COPIES OF THIS MAP TO WHICH THE FOLLOWING CERTIFICATE WILL APPLY SHOW THE SURVEYOR'S ORIGINAL SEAL AND SIGNATURE IN RED INK. COPIES BY ANY OTHER MEANS MAY HAVE ALTERATIONS WHICH DO NOT REPRESENT THE SURVEYOR'S WORK PRODUCT.

I HEREBY CERTIFY THAT THE ABOVE DESCRIBED PROPERTY HAS BEEN SURVEYED UNDER MY DIRECTION AND THAT THE ABOVE MAP IS A TRUE REPRESENTATION THEREOF AND SHOWS THE SIZE AND LOCATION OF THE PROPERTY AND ITS EXTERIOR BOUNDARIES. THIS SURVEY IS MADE FOR THE USE OF THE PRESENT OWNERS OF THE PROPERTY, AND ALSO THOSE WHO PURCHASE, MORTGAGE, OR GUARANTEE THE TITLE THERETO WITHIN ONE YEAR FROM THE DATE HEREOF.

DATE: 12/15/2023

CHRISTOPHER A. HODGES
P.L.S. 2760

JAN 19 2024
om

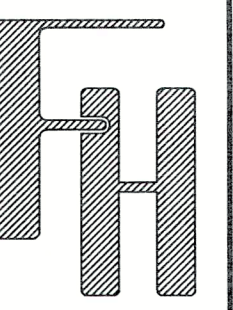

TOPOGRAPHIC MAP

W7308 SWEET ROAD
DELAWARE, WI 53115

WORK ORDERED BY -
DAVID LEVERRE
24W066 ST. CHARLES ROAD
CAROL STREAM, IL 60188

FARRIS, HANSEN & ASSOCIATES, INC.
ENGINEERING - ARCHITECTURE - SURVEYING
7 RIDGWAY COURT P.O. BOX 437
ELKHORN, WISCONSIN 53121
PHONE: (262) 723-2098 e-mail: office@farris-hansen.com

REVISIONS
12/15/2023 - DHC
ADDED 2 LOTS

PROJECT NO.
10967

DATE
12/06/2023

SHEET NO.
1 OF 1