


PLAT OF SURVEY

OF LOT 13 OF HIEMSTRA'S SUBDIVISION,
BEING PART OF THE NE 1/4 AND SE 1/4 OF THE NW 1/4 OF
SECTION 13, T. 2 N., R. 15 E., OF THE 4TH P.M.,
TOWN OF DARIEN, WALWORTH COUNTY, WISCONSIN.

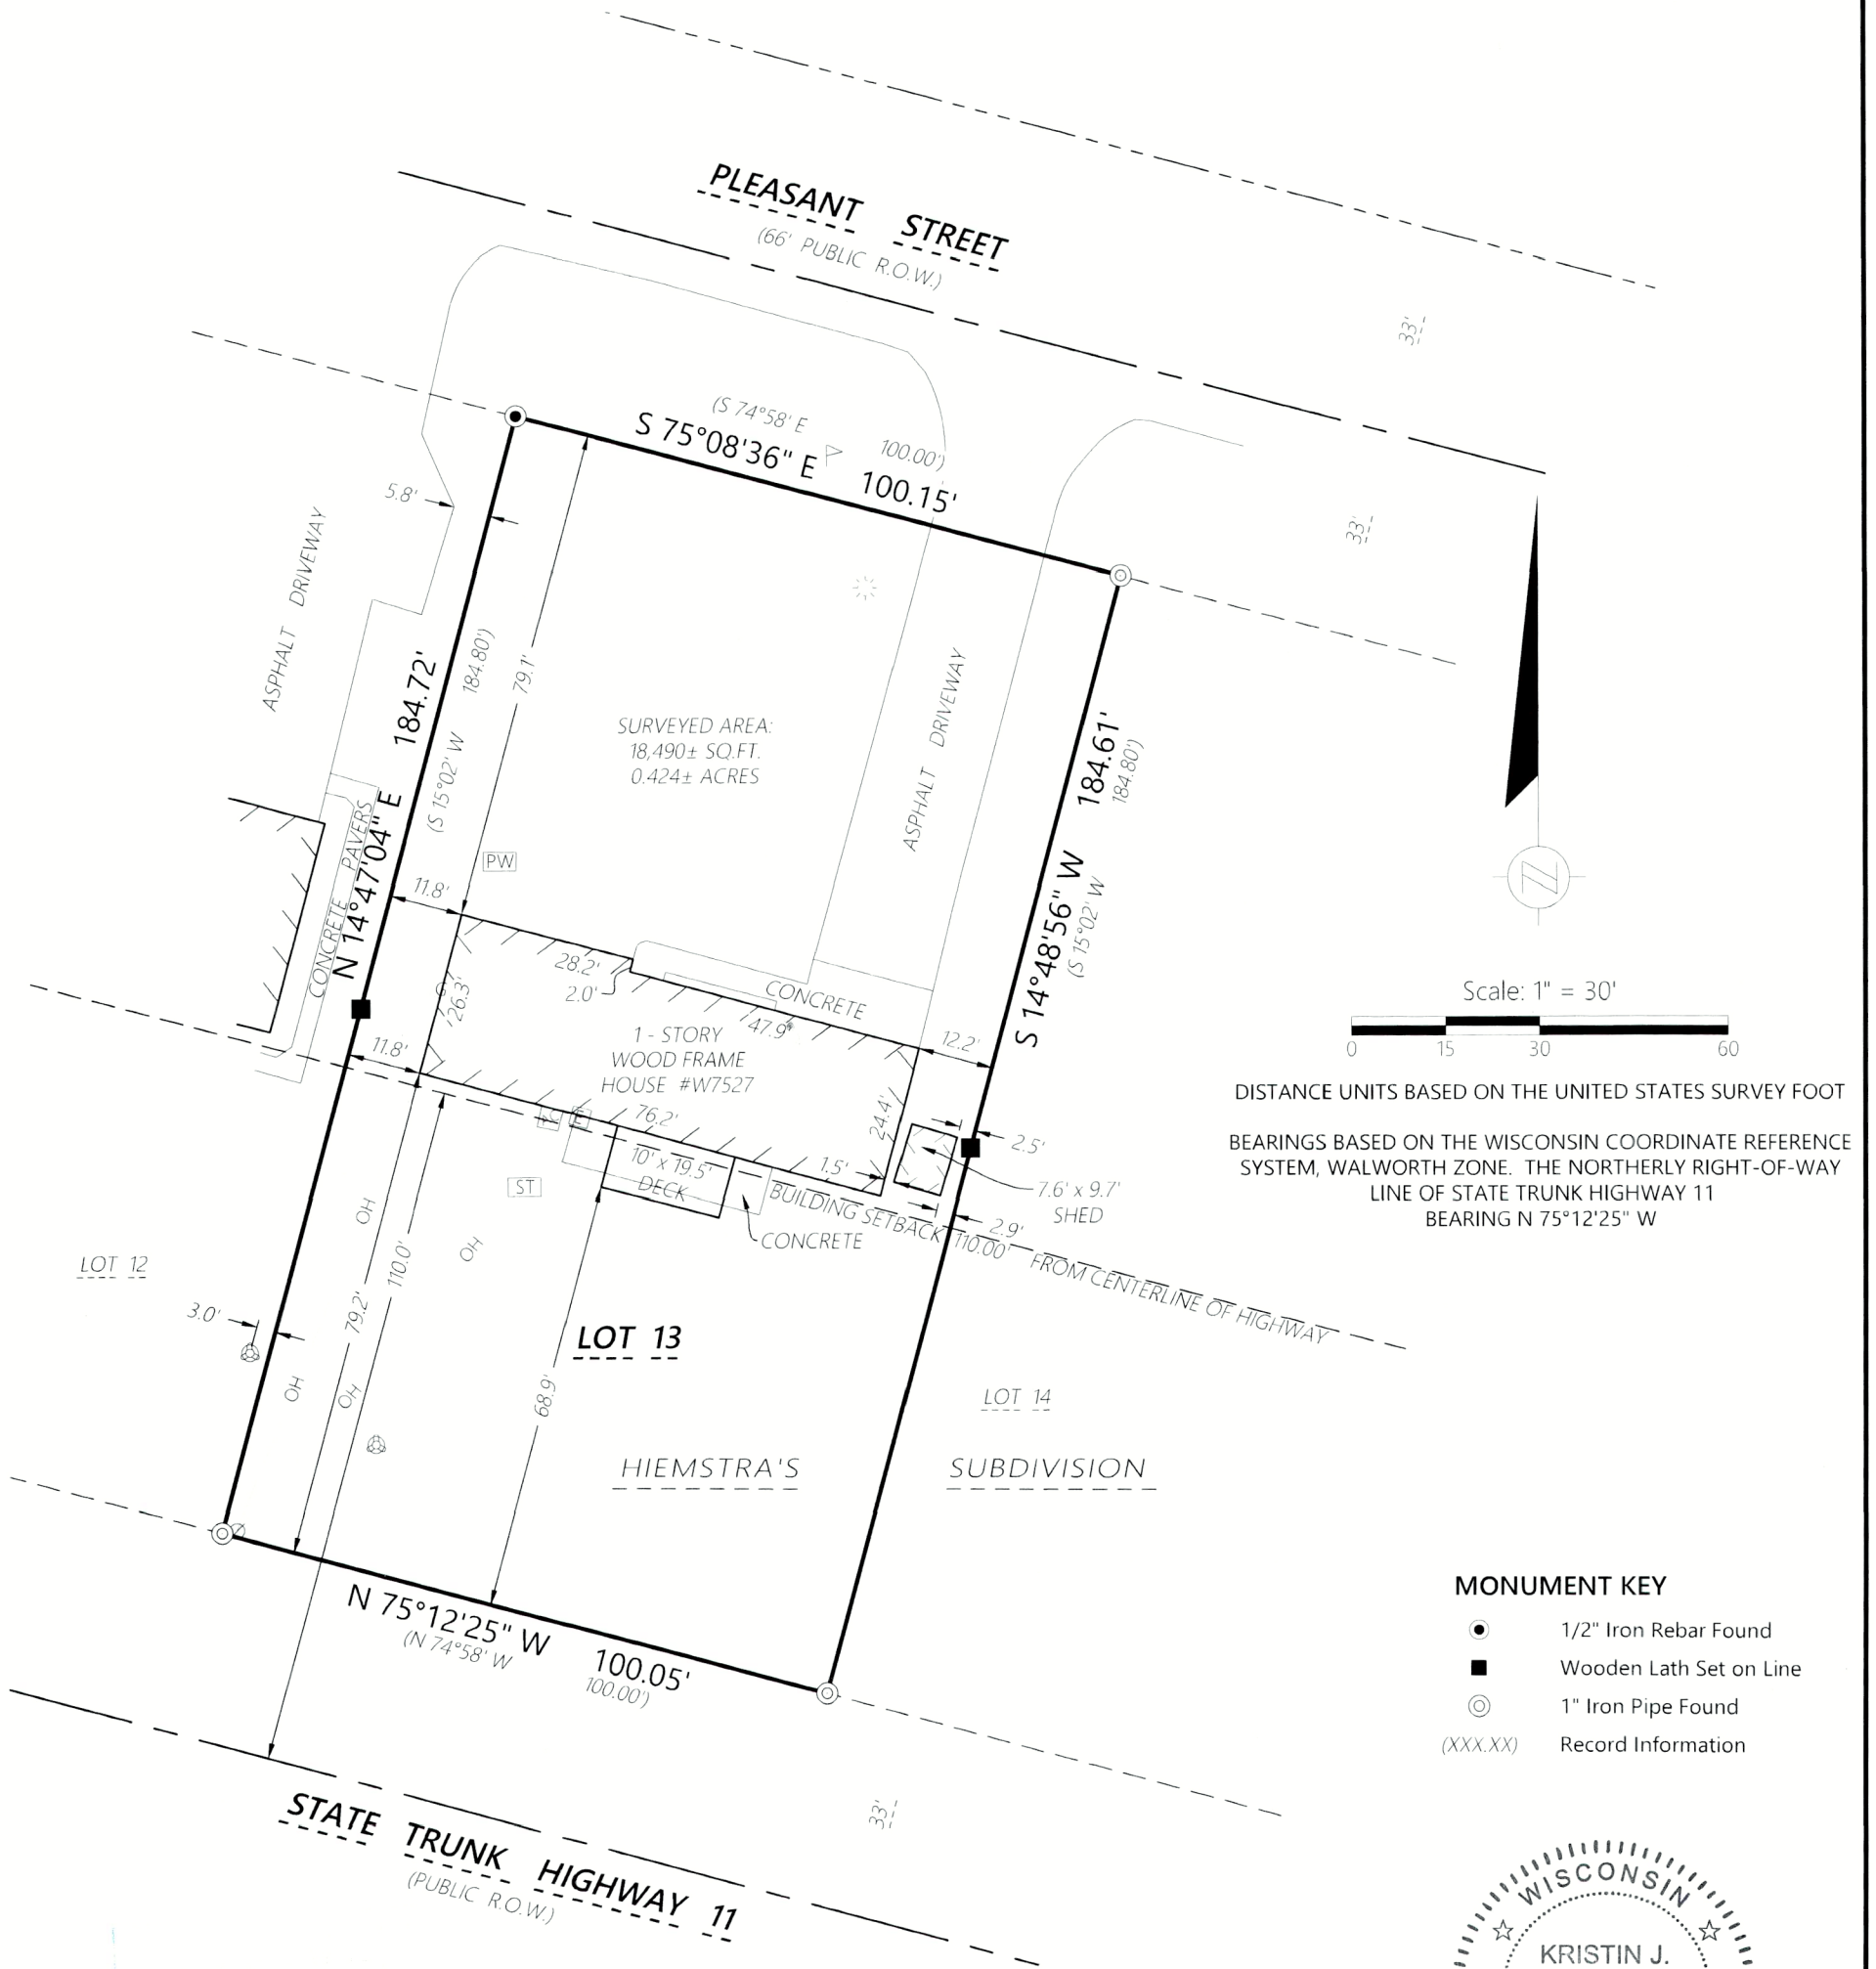

DISTANCE UNITS BASED ON THE UNITED STATES SURVEY FOOT
BEARINGS BASED ON THE WISCONSIN COORDINATE REFERENCE
SYSTEM, WALWORTH ZONE. THE NORTHERLY RIGHT-OF-WAY
LINE OF STATE TRUNK HIGHWAY 11
BEARING N 75°12'25" W

MONUMENT KEY

- 1/2" Iron Rebar Found
- Wooden Lath Set on Line
- ⊙ 1" Iron Pipe Found
- (XXX.XX) Record Information



FEB 13 2024

KRF

LEGEND

- | | | | |
|----|--------------------------|-----------|----------------------------|
| E | Existing Electric Meter | — — — — — | Existing Boundary Line |
| AC | Existing Air Conditioner | - - - - - | Existing Right-of-Way |
| G | Existing Gas Meter | - - - - - | Existing Adjacent Property |
| PW | Existing Well | - - - - - | Existing Centerline |
| ST | Existing Septic Tank | — OH — | Existing Overhead Power |
| SV | Existing Septic Vent | | |
| UP | Existing Utility Pole | | |
| GL | Existing Ground Light | | |
| FP | Existing Flag Pole | | |

Kristin J. Belongia

Kristin J. Belongia, P.L.S.
Wisconsin Professional Land Surveyor S-2943

State of Wisconsin }
County of Walworth } ss

I hereby certify that I have supervised the survey of the property described above and to the best
my knowledge and belief, the plat drawn hereon complies with Chapter A-E 7 of the State of
Wisconsin Administrative Code, Minimum Standards for Property Surveys and correctly
represents said survey and its location.

Given under my hand and seal this 27th day of November, 2023 at Elkhorn, Wisconsin.
Last day of field work November 13th, 2023

If the surveyor's signature is not red in color,
the plan is a copy that should be assumed to
contain unauthorized alterations.
The certification contained on this document
shall not apply to any copies.

ORDER NO: 34856

FIELD CREW: JV
DRAWN BY: KRS
SHEET 1 OF 1

FOR THE EXCLUSIVE USE OF:

Duwayne Peters
W7527 Pleasant Street
Delavan, WI 53115

PLAT OF SURVEY

Batterman
engineers surveyors planners

2857 Bartells Drive 1040 N Wisconsin Street
Beloit, Wisconsin 53511 Elkhorn, Wisconsin 53121
608.365.4464 262.379.2250

