

ABELL
 SURVEYING & MAPPING
 DELAVAN, WISCONSIN 53115
 414-728-6737




SCALE 1" = 30'

LEGEND

- ⊙ - IRON PIPE FOUND
- - IRON ROD SET
- XX - WIRE OR CHAINLINK FENCE
- * - WOOD FENCE
- CS - CONCRETE STOOP
- △ - UTILITY POLE
- └ - GUY WIRE
- () - RECORDED AS

PLAT OF SURVEY OF

LOT 7, CHICAGO CLUB, LOCATED IN T2N,
 R16E, WALWORTH COUNTY, WISCONSIN.

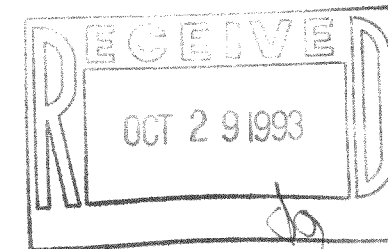

ORDERED BY: PROFESSIONAL REALTY
 706 E. GENEVA ST.
 DELAVAN, WI. 53115

I HEREBY CERTIFY THAT I HAVE SURVEYED THE ABOVE DESCRIBED PROPERTY AND THAT THE ABOVE MAP IS A TRUE REPRESENTATION THEREOF AND SHOWS THE SIZE AND LOCATION OF THE PROPERTY, ITS EXTERIOR BOUNDARIES, THE LOCATION OF ALL VISIBLE STRUCTURES AND DIMENSIONS OF ALL PRINCIPAL BUILDINGS THEREON, BOUNDARY FENCES, APPARENT EASEMENTS, ROADWAYS AND VISIBLE ENCROACHMENTS, IF ANY, TO THE BEST OF MY KNOWLEDGE AND BELIEF.


THIS SURVEY IS MADE FOR THE USE OF THE PRESENT OWNERS OF THE PROPERTY, AND ALSO THOSE WHO PURCHASE, MORTGAGE, OR GUARANTEE THE TITLE THERETO WITHIN ONE (1) YEAR FROM DATE HEREON.

David F. Abell

DAVID F. ABELL
 WISCONSIN REGISTERED LAND SURVEYOR, S-1596

July 28, 1993

DATE: _____ JOB NUMBER - 93156
 NOTE: THIS IS NOT A CERTIFIED COPY UNLESS SEALED.

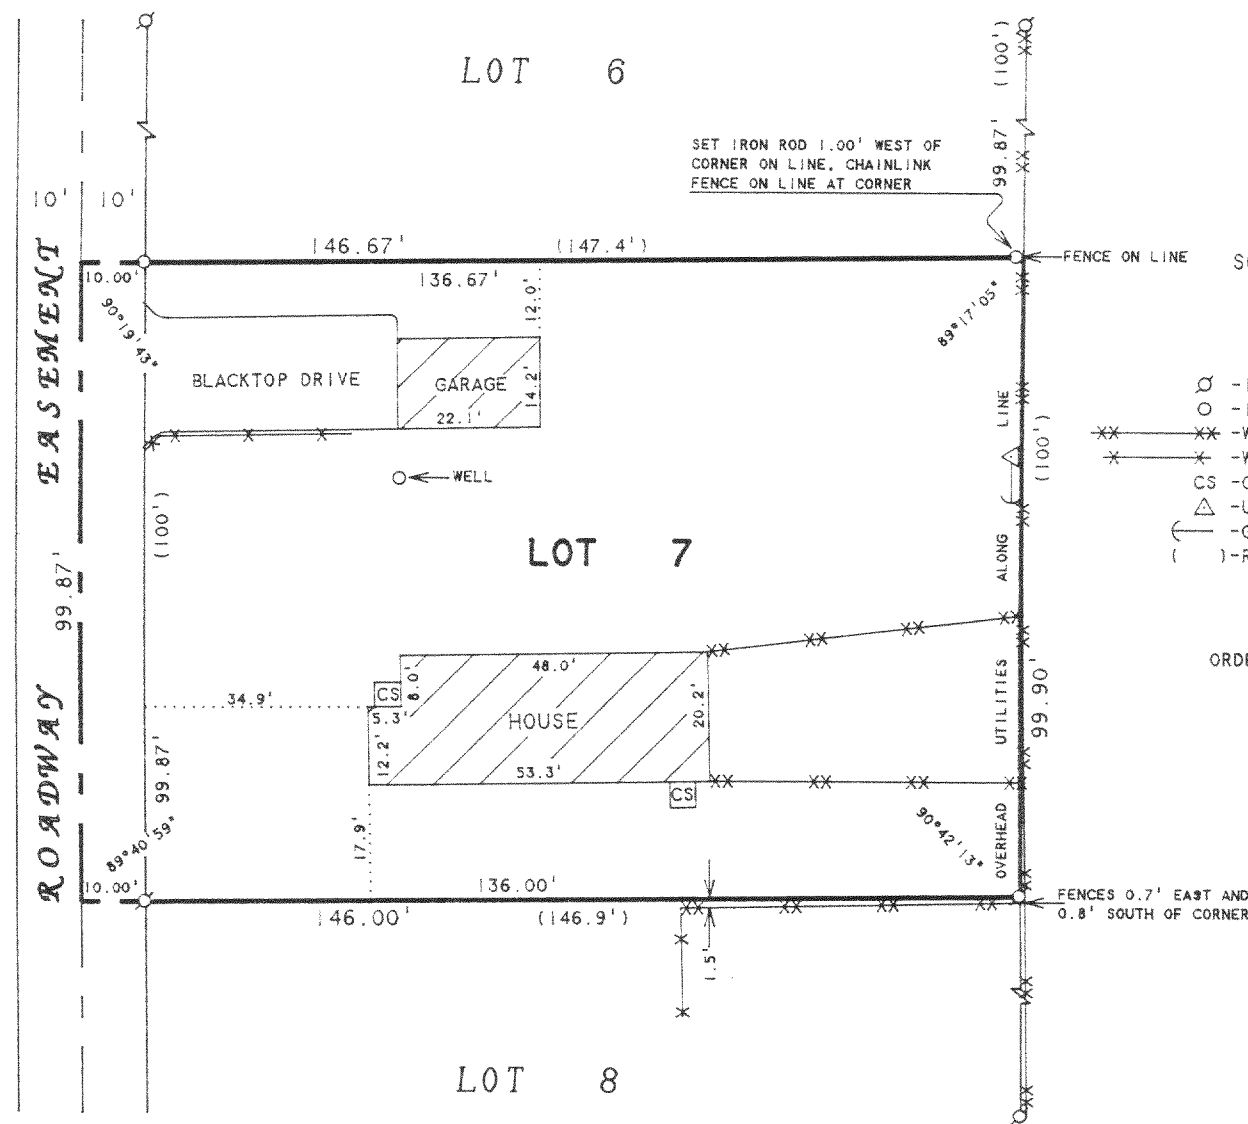

FCH-12

216-1881