


ABELL
SURVEYING & MAPPING
1140 SEQUOIA STREET • DELAVAN, WISCONSIN 53115
262-728-6737

DELAVAN
LAKE

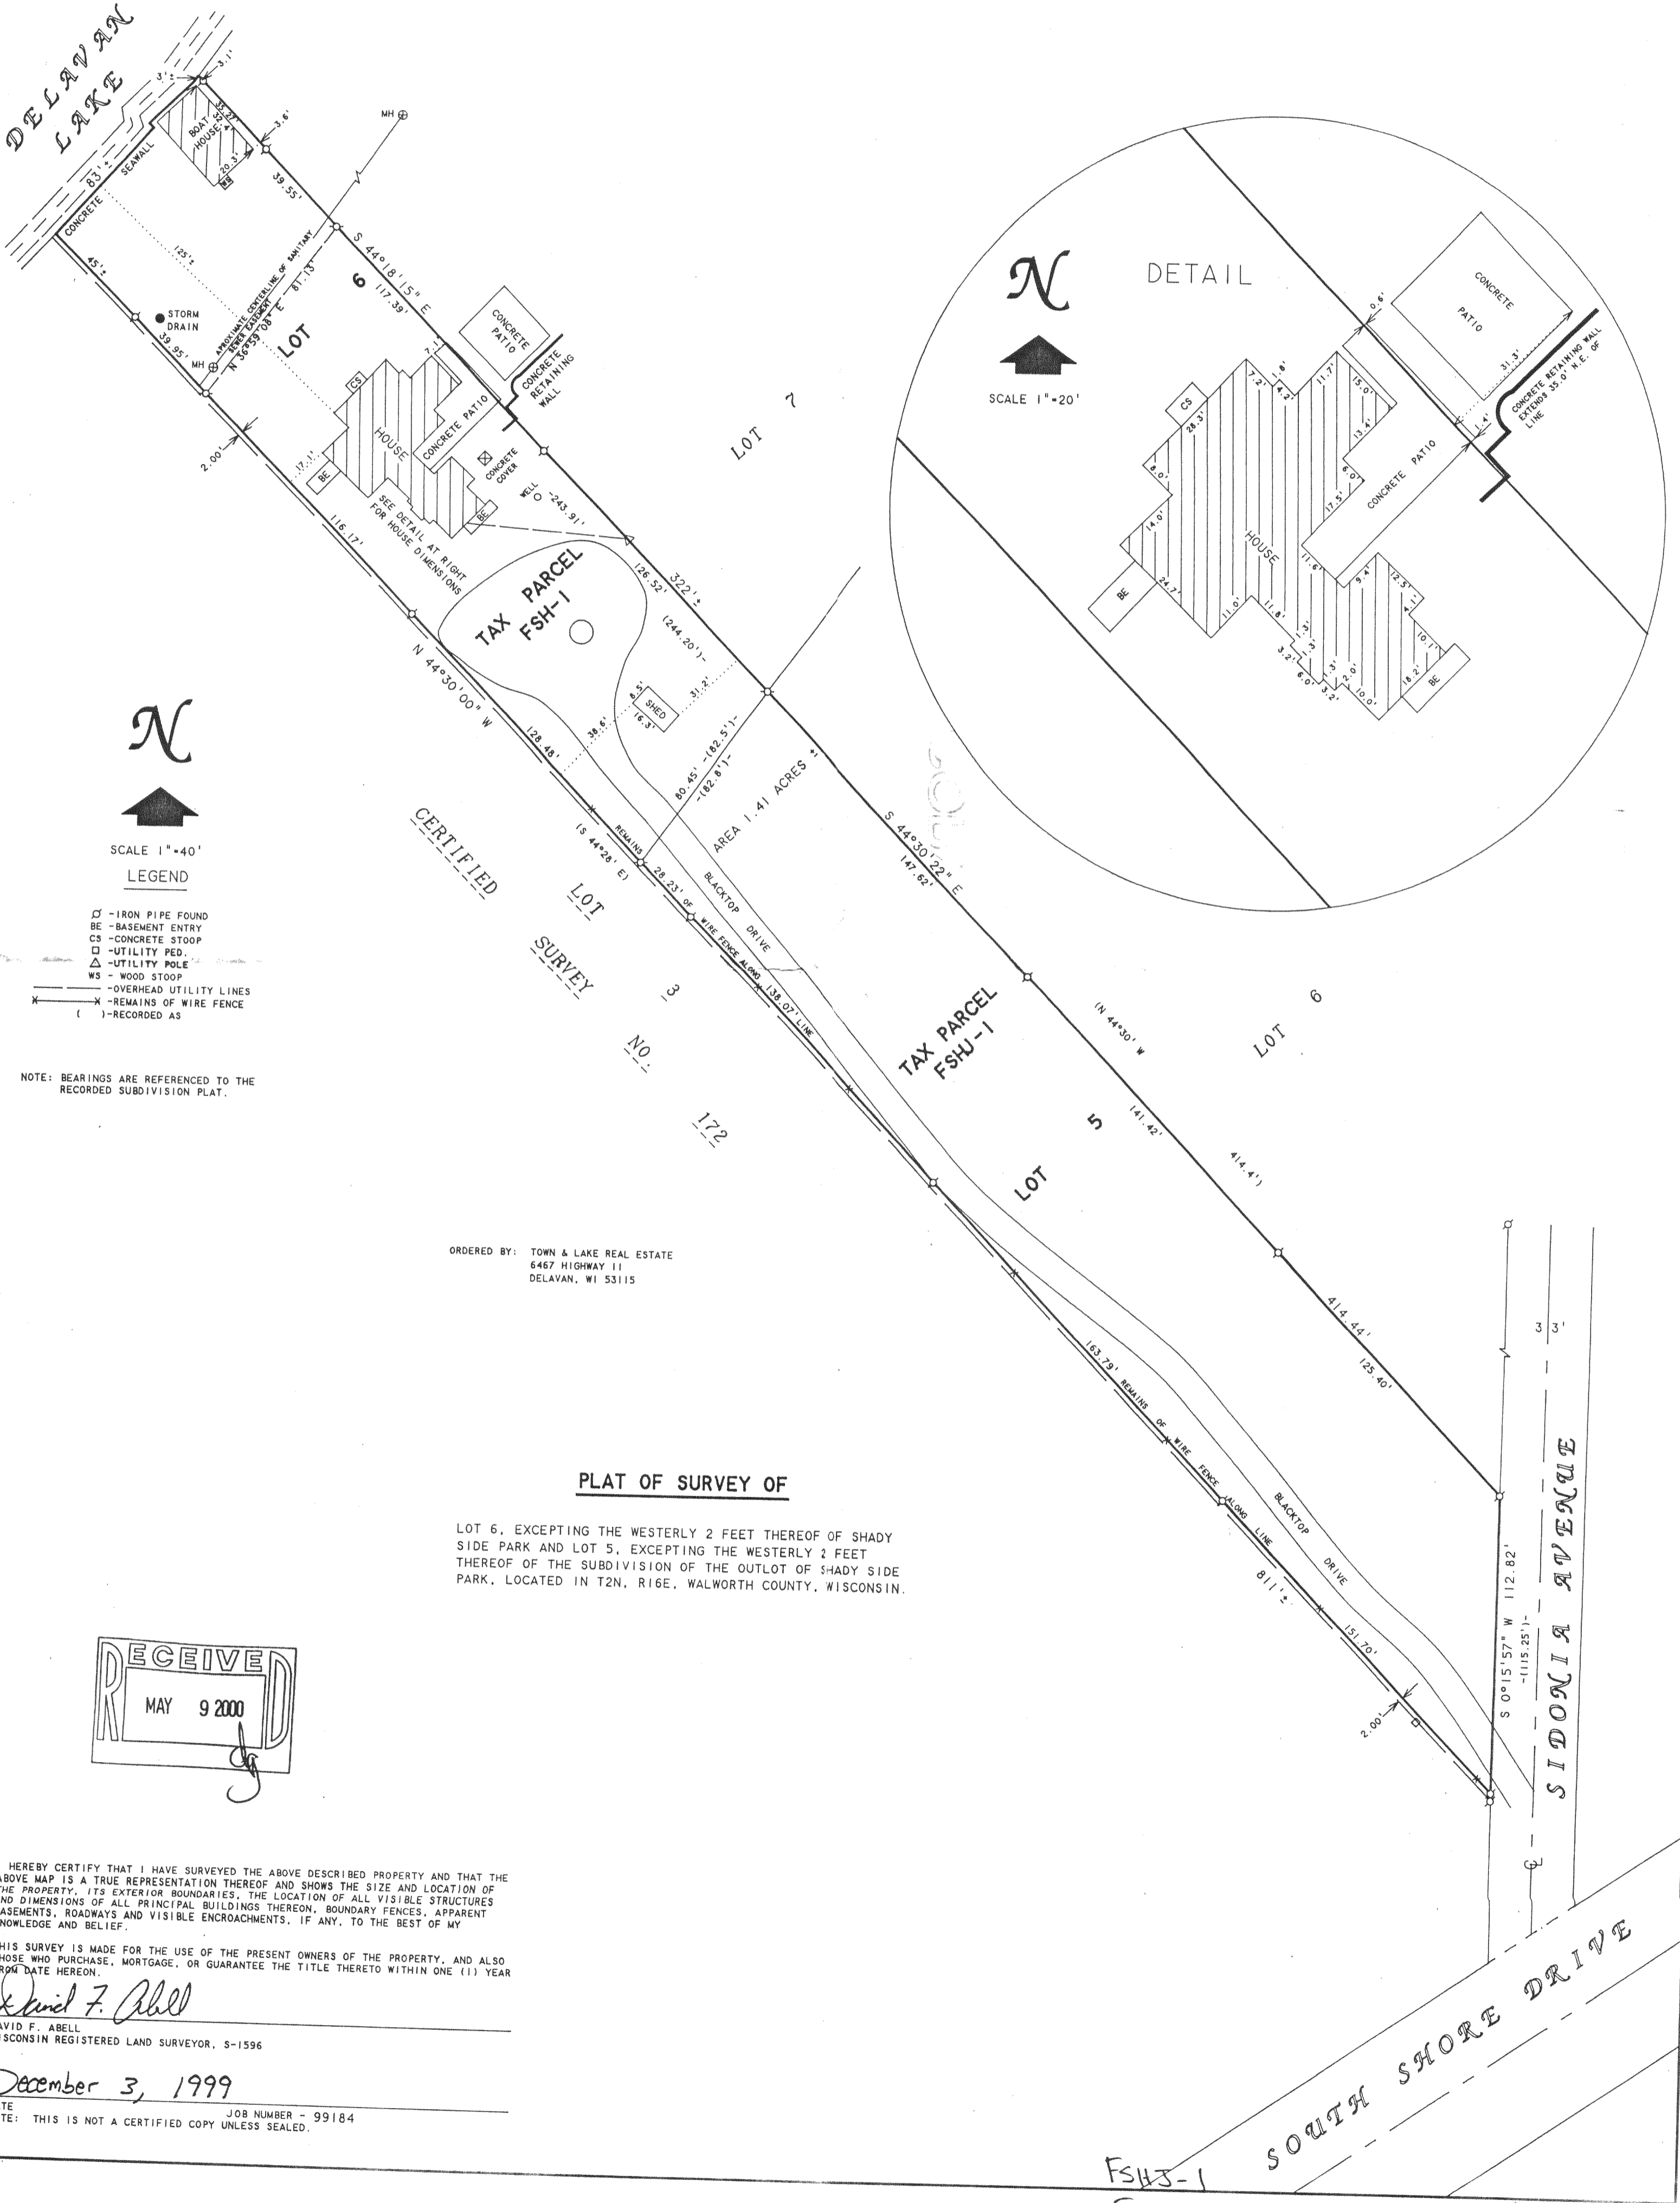

N
SCALE 1"=40'

N
SCALE 1"=20'

- LEGEND
- - IRON PIPE FOUND
 - BE - BASEMENT ENTRY
 - CS - CONCRETE STOOP
 - △ - UTILITY POLE
 - - UTILITY POLE
 - WS - WOOD STOOP
 - - OVERHEAD UTILITY LINES
 - - REMAINS OF WIRE FENCE
 - () - RECORDED AS

NOTE: BEARINGS ARE REFERENCED TO THE RECORDED SUBDIVISION PLAT.

ORDERED BY: TOWN & LAKE REAL ESTATE
6467 HIGHWAY 11
DELAVAN, WI 53115

PLAT OF SURVEY OF

LOT 6, EXCEPTING THE WESTERLY 2 FEET THEREOF OF SHADY SIDE PARK AND LOT 5, EXCEPTING THE WESTERLY 2 FEET THEREOF OF THE SUBDIVISION OF THE OUTLOT OF SHADY SIDE PARK, LOCATED IN T2N, R16E, WALWORTH COUNTY, WISCONSIN.



I HEREBY CERTIFY THAT I HAVE SURVEYED THE ABOVE DESCRIBED PROPERTY AND THAT THE ABOVE MAP IS A TRUE REPRESENTATION THEREOF AND SHOWS THE SIZE AND LOCATION OF THE PROPERTY, ITS EXTERIOR BOUNDARIES, THE LOCATION OF ALL VISIBLE STRUCTURES AND DIMENSIONS OF ALL PRINCIPAL BUILDINGS THEREON, BOUNDARY FENCES, APPARENT EASEMENTS, ROADWAYS AND VISIBLE ENCROACHMENTS, IF ANY, TO THE BEST OF MY KNOWLEDGE AND BELIEF.

THIS SURVEY IS MADE FOR THE USE OF THE PRESENT OWNERS OF THE PROPERTY, AND ALSO THOSE WHO PURCHASE, MORTGAGE, OR GUARANTEE THE TITLE THERETO WITHIN ONE (1) YEAR FROM DATE HEREON.

David F. Abell
DAVID F. ABELL
WISCONSIN REGISTERED LAND SURVEYOR, S-1596

December 3, 1999
DATE
JOB NUMBER - 99184
NOTE: THIS IS NOT A CERTIFIED COPY UNLESS SEALED.

FSH3-1
SOUTH SHORE DRIVE