


**SURVEYING & SUBDIVIDING  
DELA VAN, WISCONSIN 53115**



A circular seal with a dotted border. The text "WISCONSIN" is at the top and "LAND SURVEYOR" is at the bottom, separated by two stars. In the center, it reads "GEORGE T. DUNHAM", "S-306", and "DeLAVAN WIS."

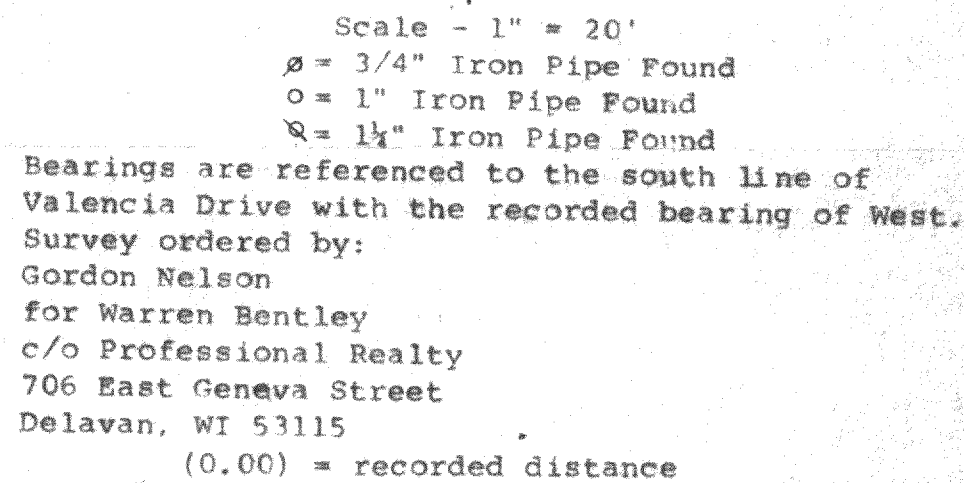