


ABERNATHY and ASSOCIATES

Kenneth B. Abernathy Jr.

Wisconsin Registered Land Surveyor S-1594

**W4058 BRAY RD.
ELKHORN, WI. 53121**
PHONE: (262) 723-4260 (OFFICE)
(262) 723-7209 (FAX)
Email: abernathy@elknet.net

OWNER: PHILLIP H. CLINE
4505 S. SHORE DR.
DELAVAN, WI. 53115

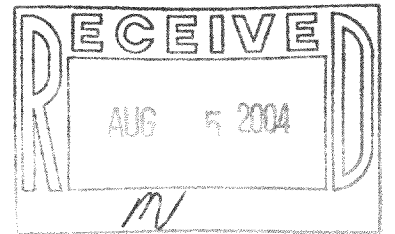



PLAT OF SURVEY

**LOT 16 AND THE NORTH 1/2 OF LOT 17
OF BLOCK 2 OF SOUTH SHORE MANOR
SUBDIVISION, LOCATED IN THE SOUTHEAST
1/4 OF SECTION 32, TOWN 2 NORTH, RANGE
16 EAST, WALWORTH COUNTY, WISCONSIN.**


REFERENCE LEGAL: VOL. 470 PAGE 349 AS DOC. NO. 185079

Legend

- FOUND IRON PIPE
- FOUND IRON ROD
- ⊠ FOUND BRASS CAPPED MONUMENT
- FOUND CONCRETE MONUMENT
- + CHISEL CUT IN CONCRETE
- SET IRON ROD, 24" LONG, WEIGHING 1.5 LBS./LINEAL FT., 3/4" DIA.
- SET IRON ROD, 30" LONG, WEIGHING 4.5 LBS./LINEAL FT., 1-11/16" DIA.
- (x x) RECORDED AS DIMENSION
- x-x- EXISTING FENCE

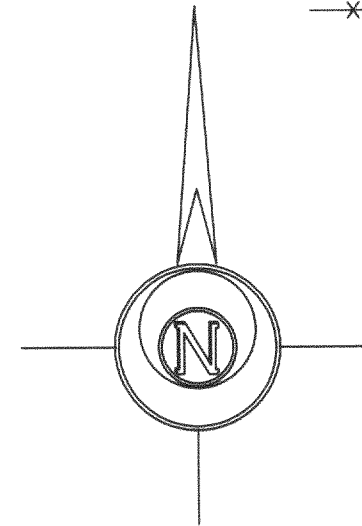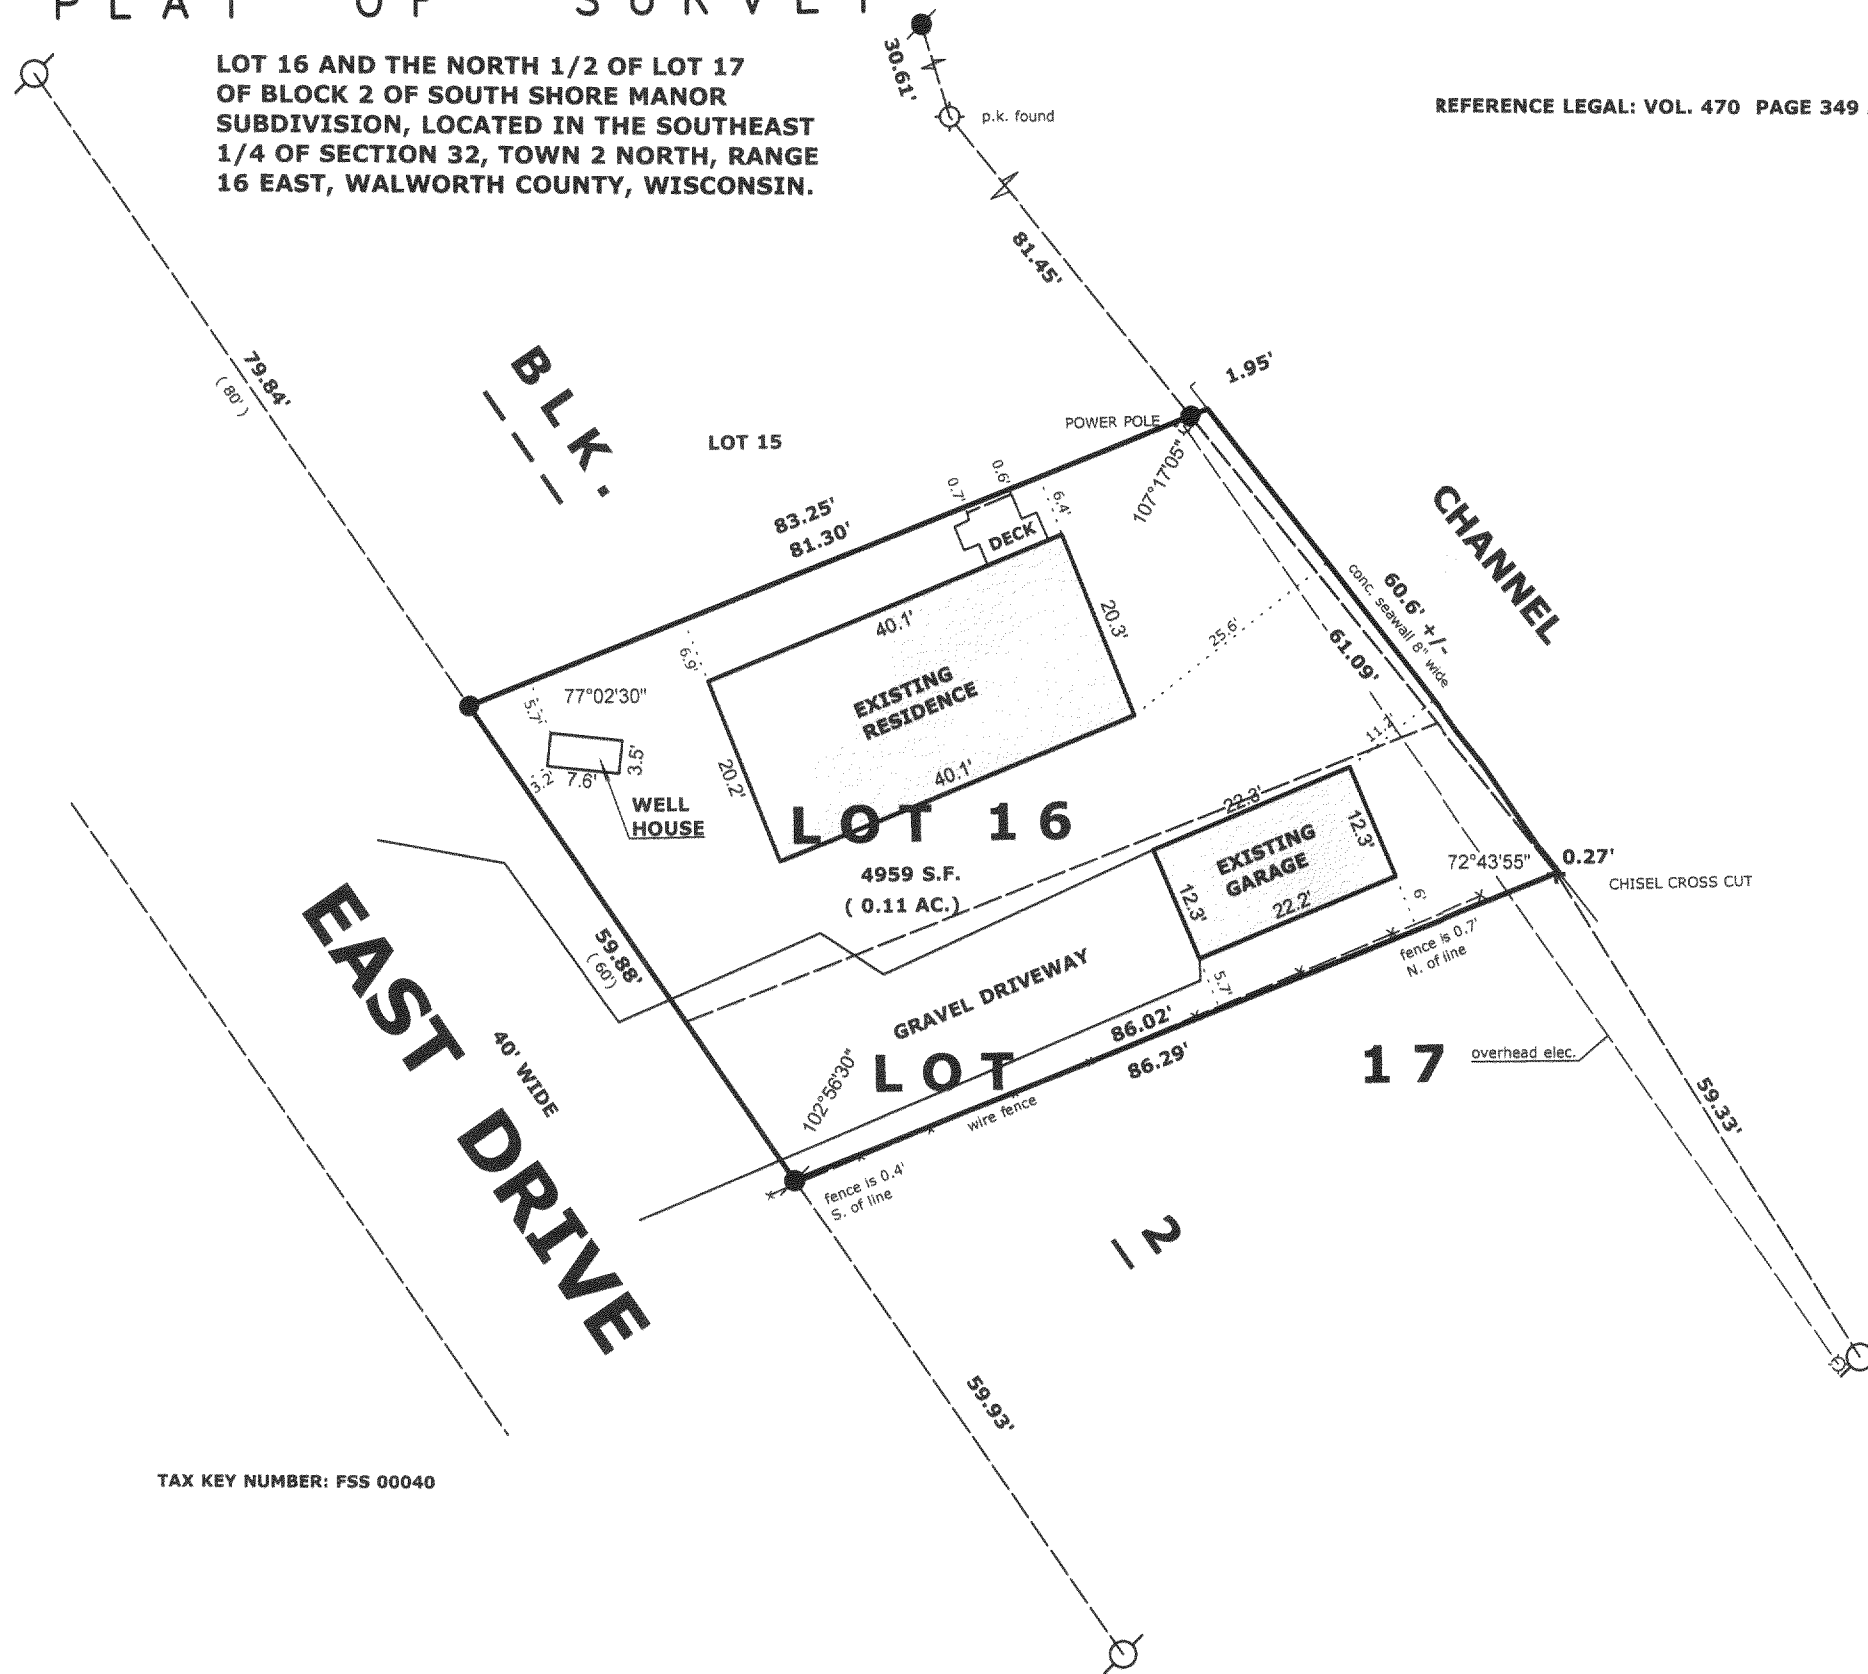

SCALE: 1" = 20 FEET

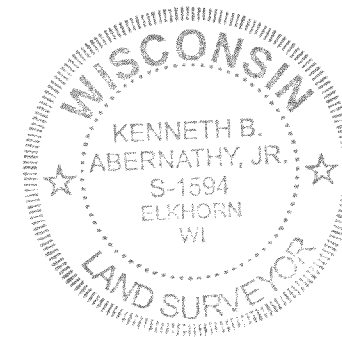

"I hereby certify that the above described property has been surveyed by me or under my direction and that the above map is a true representation thereof and shows the size and location of the property, its exterior boundaries, the location of all visible structures and dimensions of all principal buildings thereon, boundary fences, apparent easements, roadways and visible encroachments, if any."
 "This survey is made for the use of the present owners of the property, and also those who purchase, mortgage, or guarantee the title thereto within one year from the date hereof."

Kenneth B. Abernathy, Jr.

KENNETH B. ABERNATHY, JR.
WISCONSIN REGISTERED LAND SURVEYOR,
S-1594

Date: July 15, 2004 Job No. 04.608

TAX KEY NUMBER: FSS 00040

FSS 00040

216-3790