


FARRIS, HANSEN & ASSOCIATES, INC.

ENGINEERING – ARCHITECTURE – SURVEYING
7 RIDGWAY COURT – P.O. BOX 437 – ELKHORN, WISCONSIN 53121
PHONE: (262) 723-2098 FAX: (262) 723-5886


PLAT OF SURVEY

TAX PARCELS F D 3200029, F D 3200030, F D 3200031, F D 3200037, AND FPO 00009
PART OF THE SE 1/4 OF THE SW 1/4, SECTION 32, TOWN 2 NORTH, RANGE 16 EAST
WALWORTH COUNTY, WISCONSIN

WILDWOOD DRIVE

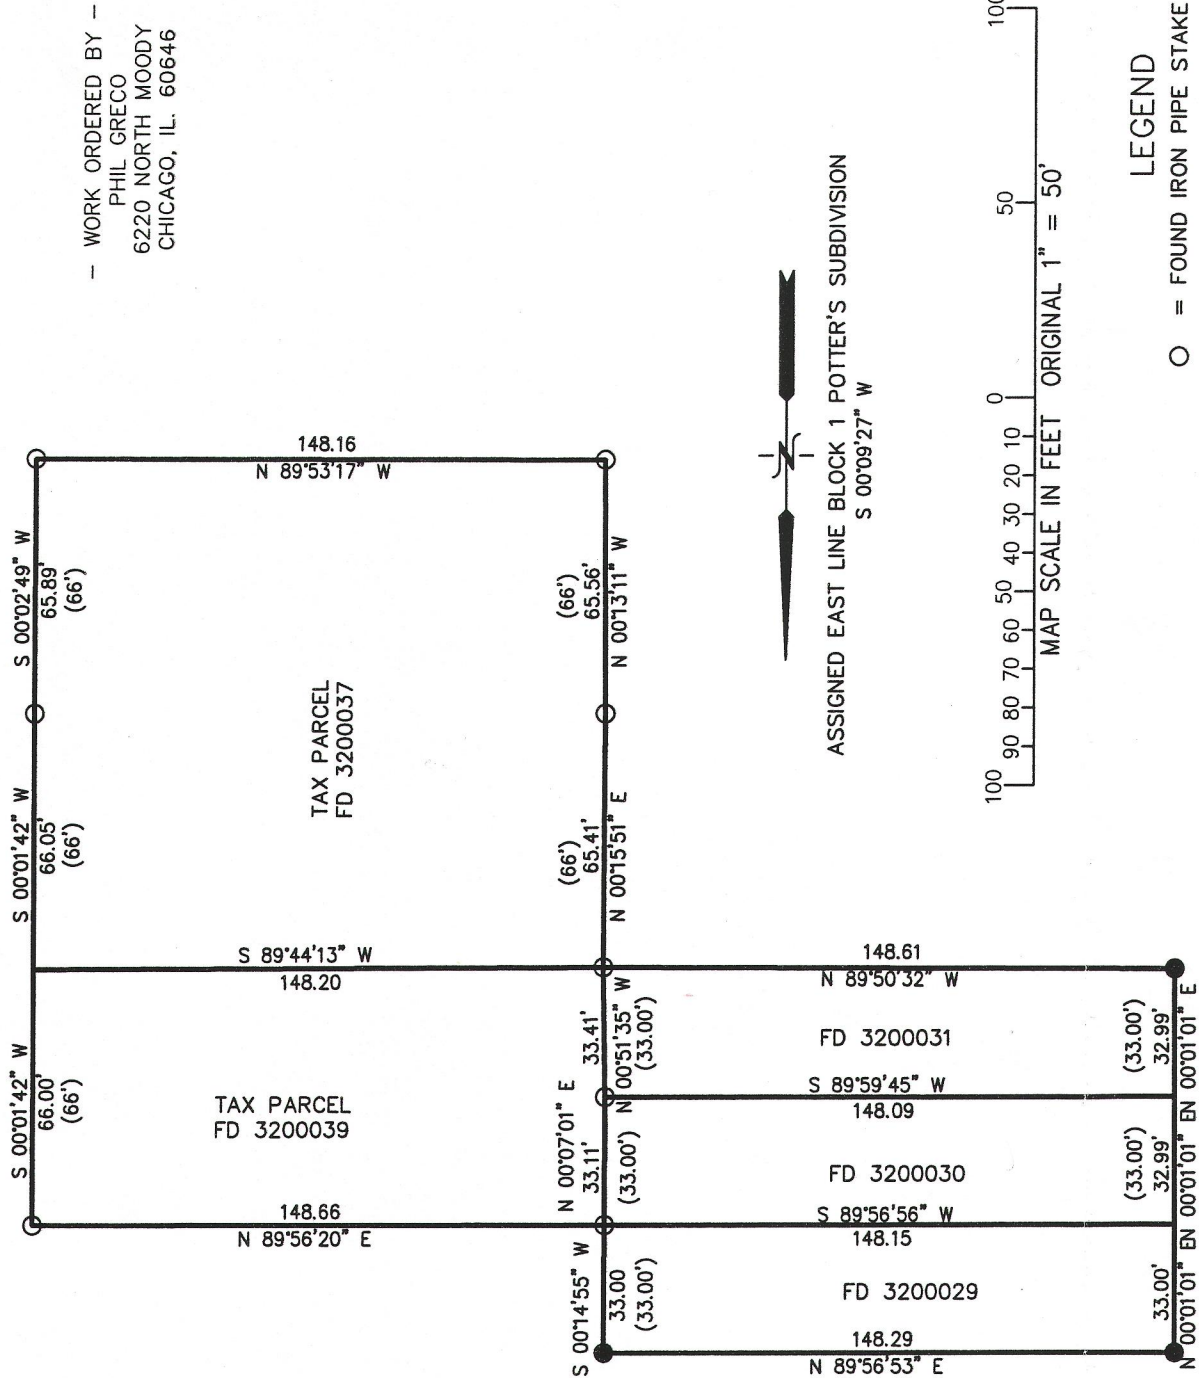


BLUEGILL ROAD

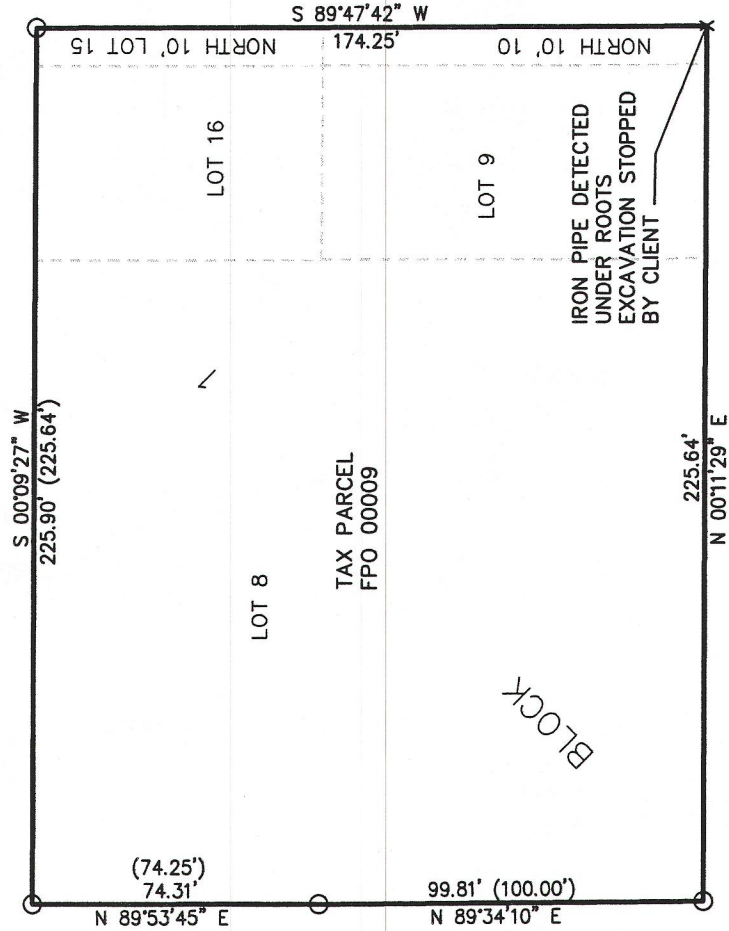

DUTCH MILL ROAD

NOTE: COPIES OF THIS MAP TO WHICH THE FOLLOWING CERTIFICATE
WILL APPLY SHOW THE SURVEYOR'S ORIGINAL SEAL AND SIGNATURE
IN RED INK. COPIES BY ANY OTHER MEANS MAY HAVE ALTERATIONS
WHICH DO NOT REPRESENT THE SURVEYOR'S WORK PRODUCT.

I HEREBY CERTIFY THAT THE ABOVE DESCRIBED PROPERTY HAS BEEN
SURVEYED UNDER MY DIRECTION AND THAT THE ABOVE MAP IS A TRUE
REPRESENTATION THEREOF AND SHOWS THE SIZE AND LOCATION OF
THE PROPERTY AND ITS EXTERIOR BOUNDARIES. THIS SURVEY IS
MADE FOR THE USE OF THE PRESENT OWNERS OF THE PROPERTY, AND
ALSO THOSE WHO PURCHASE, MORTGAGE, OR GUARANTEE THE TITLE
THERE TO WITHIN ONE YEAR FROM THE DATE HEREOF.

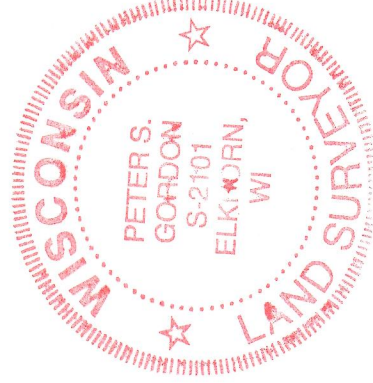

DATED: SEPTEMBER 16, 2013

PETER S. GORDON R.L.S. 2101

SEP 16 2013

FPO 00009 31 39
FD 3200029 30 37

PROJECT: 8873
DATE: 09-13-2013
SHEET 1 OF 1

216-5067