


DELAYAN

LAKE

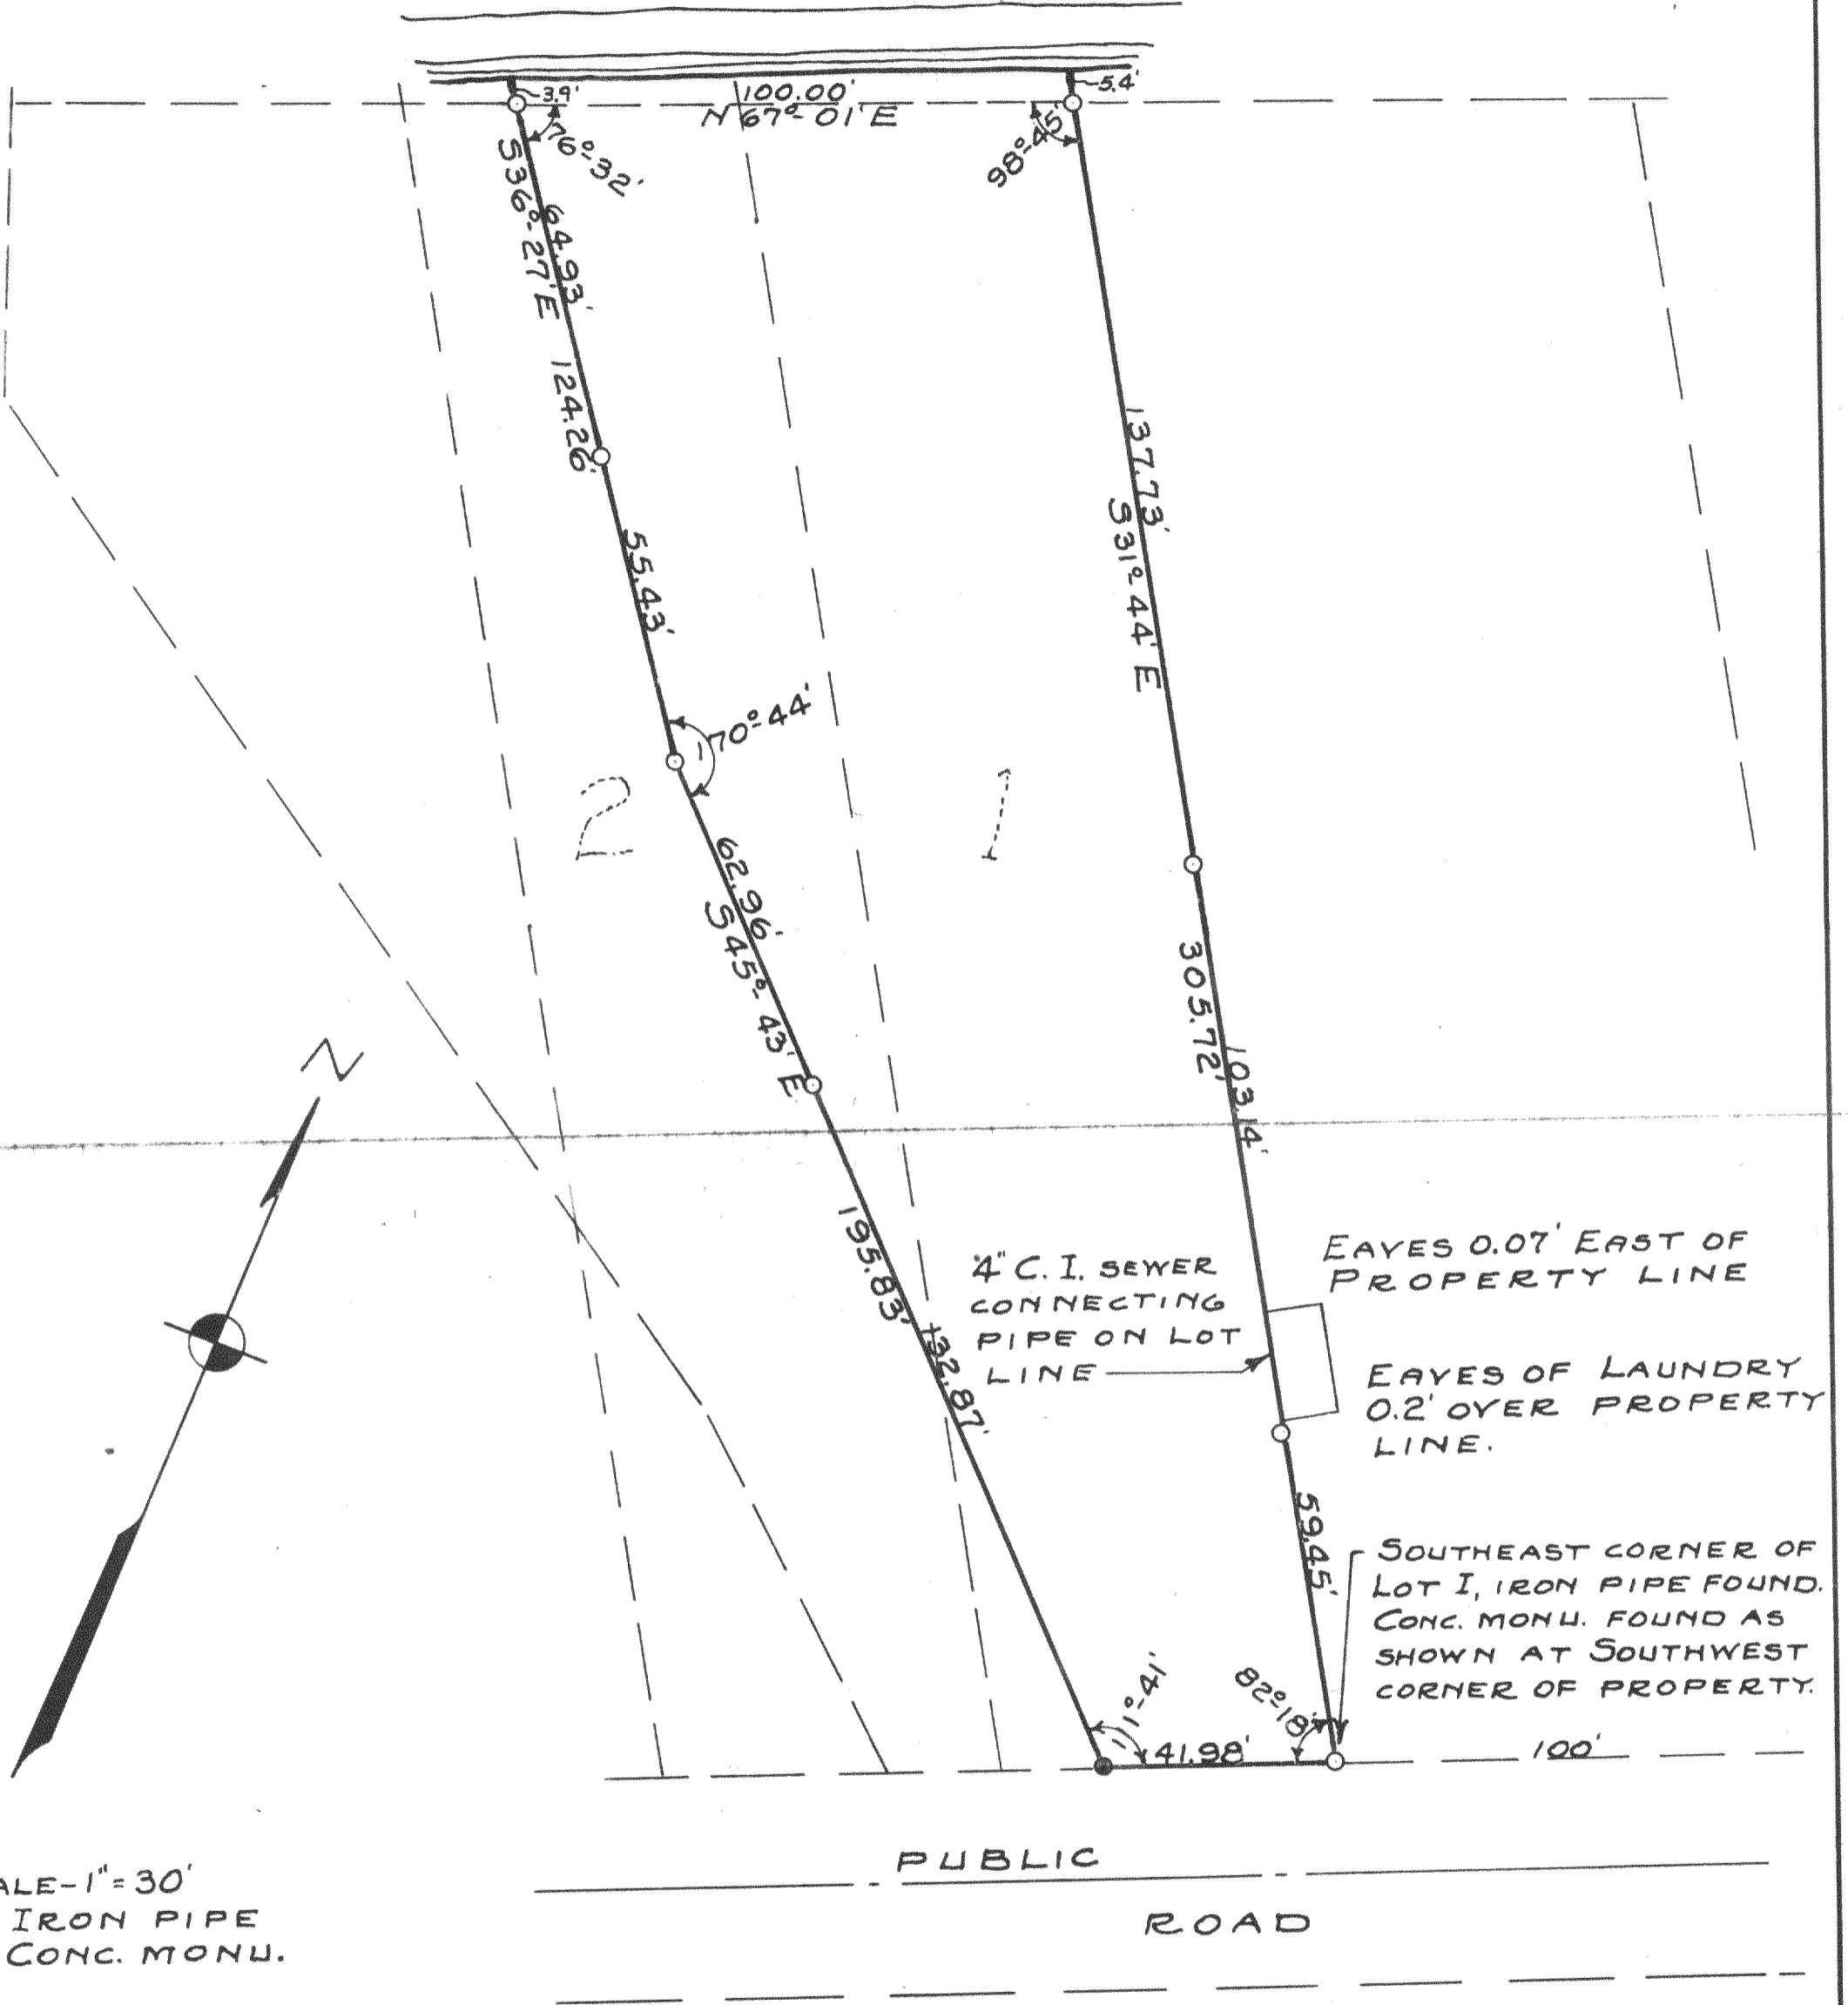

SCALE-1"=30'  
 O = IRON PIPE  
 ● = CONC. MONU.

PLAT OF SURVEY OF PART OF LOTS 1 AND 2  
 OF THE PLAT OF SANS SOUCI, LOCATED IN  
 SECTION 22, T2 N R16 E OF WALWORTH COUNTY  
 WISCONSIN  
 Nov. 1947

*Floyd L. Jensen*  
 COUNTY SURVEYOR

FSA-1