
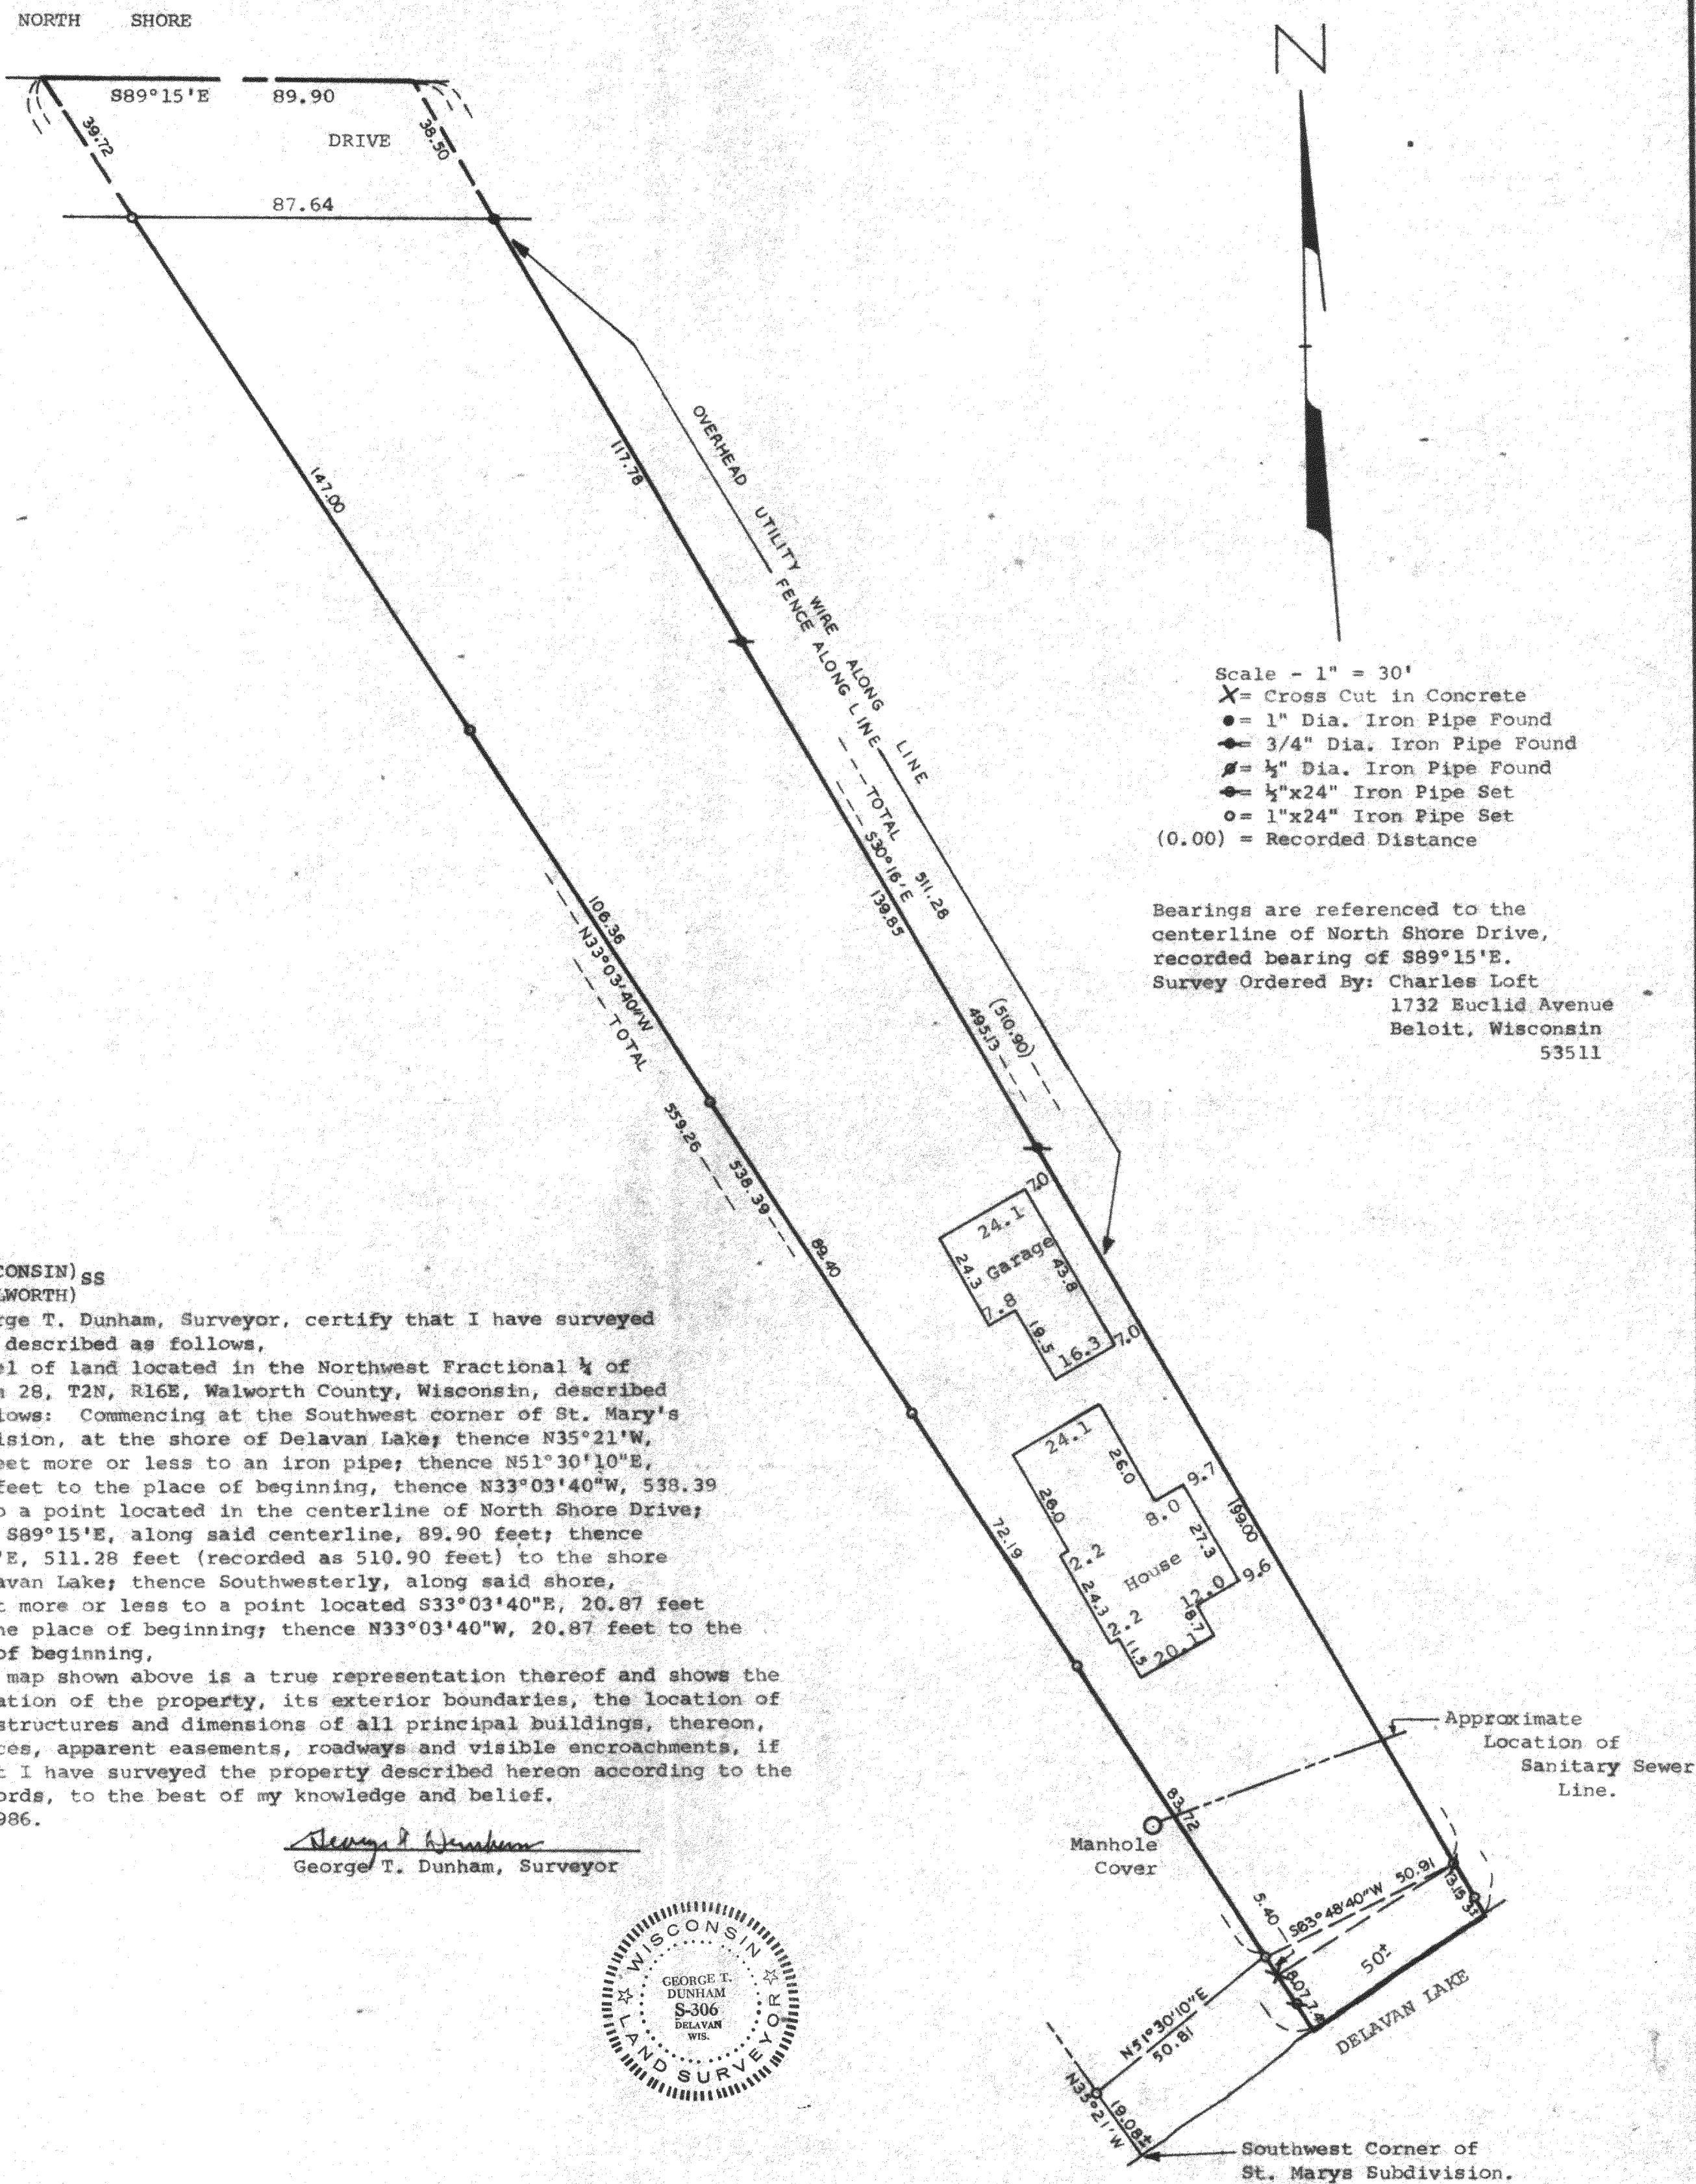


DUNHAM SURVEYING, S.C.
SURVEYING & SUBDIVIDING
DELAVER, WISCONSIN 53115

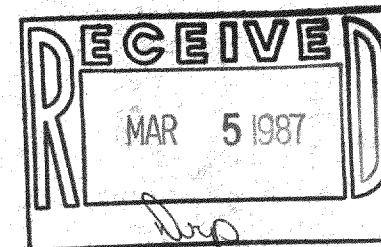

STATE OF WISCONSIN) ss
COUNTY OF WALWORTH)

I, George T. Dunham, Surveyor, certify that I have surveyed the property described as follows,

A parcel of land located in the Northwest Fractional 1/4 of Section 28, T2N, R16E, Walworth County, Wisconsin, described as follows: Commencing at the Southwest corner of St. Mary's Subdivision, at the shore of Delavan Lake; thence N35°21'W, 19.1 feet more or less to an iron pipe; thence N51°30'10"E, 50.81 feet to the place of beginning, thence N33°03'40"W, 538.39 feet to a point located in the centerline of North Shore Drive; thence S89°15'E, along said centerline, 89.90 feet; thence S30°16'E, 511.28 feet (recorded as 510.90 feet) to the shore of Delavan Lake; thence Southwesterly, along said shore, 50 feet more or less to a point located S33°03'40"E, 20.87 feet from the place of beginning; thence N33°03'40"W, 20.87 feet to the place of beginning,

and that the map shown above is a true representation thereof and shows the size and location of the property, its exterior boundaries, the location of all visible structures and dimensions of all principal buildings, thereon, boundary fences, apparent easements, roadways and visible encroachments, if any, and that I have surveyed the property described hereon according to the official records, to the best of my knowledge and belief.
August 19, 1986.

George T. Dunham
George T. Dunham, Surveyor

