

NOTE: THIS IS NOT A CERTIFIED COPY UNLESS SEALED.

DATE JOB NUMBER - 87113

August 17, 1987

WISCONSIN REGISTERED LAND SURVEYOR, S-1596


DAVID F. ABELL

David F. Abell

I, DAVID F. ABELL, DO HEREBY CERTIFY THAT I HAVE SURVEYED THE PROPERTY HEREON DESCRIBED ACCORDING TO THE OFFICIAL RECORDS AND THAT THE PLAT HEREON IS A CORRECT REPRESENTATION OF THE PROPERTY LINES TO THE BEST OF MY KNOWLEDGE AND BELIEF.

LEGEND  
⊘ - IRON PIPE FOUND  
( ) - RECORDED AS

SCALE - 1"=30'

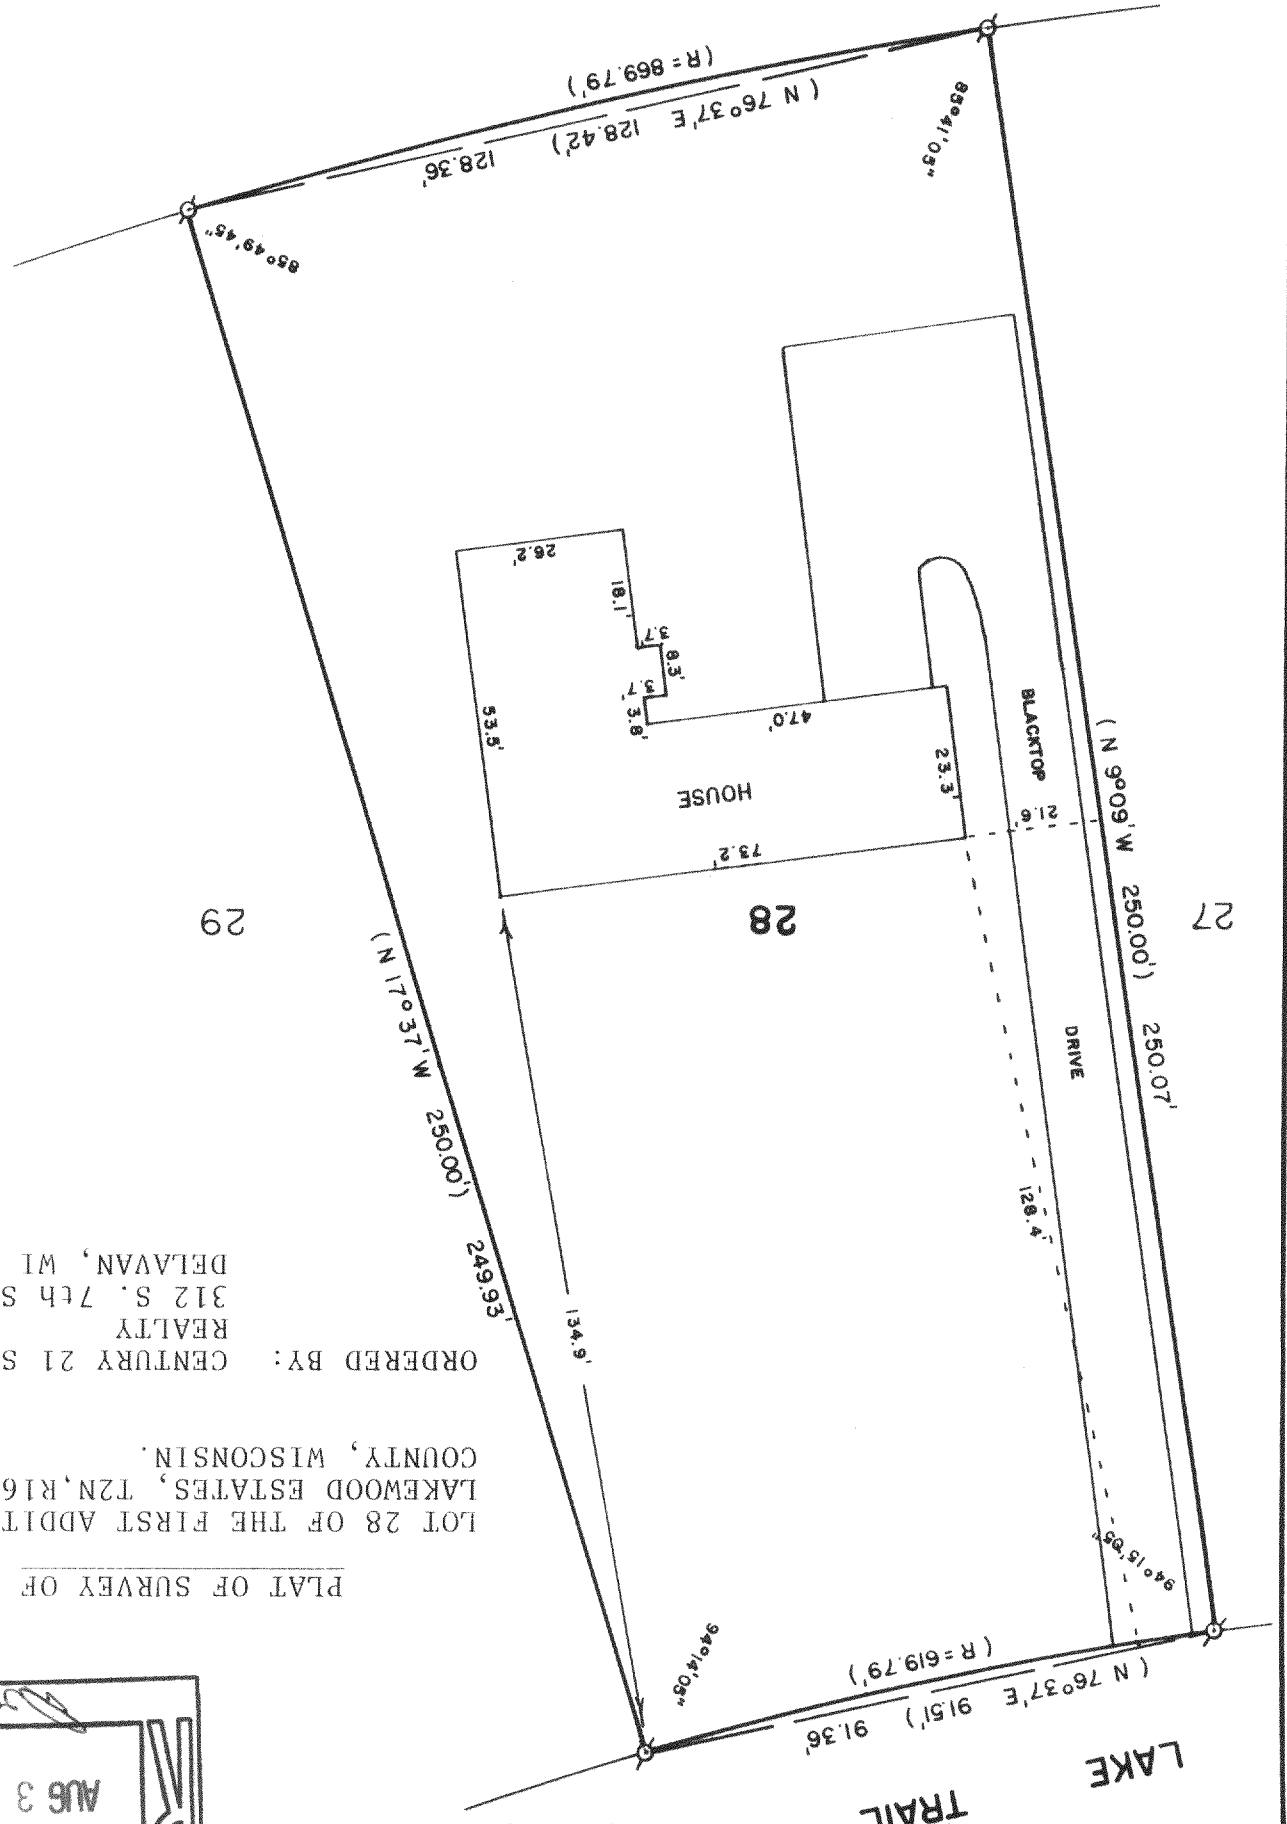

ORDERED BY: CENTURY 21 SKANDIA REALTY  
312 S. 7th STREET  
DELAVAN, WI 53115  
LOT 28 OF THE FIRST ADDITION TO LAKEWOOD ESTATES, T2N, R16E, WALWORTH COUNTY, WISCONSIN.

PLAT OF SURVEY OF

ABELL  
SURVEYING & MAPPING  
DELAVAN, WISCONSIN 53115  
414-728-6737

