


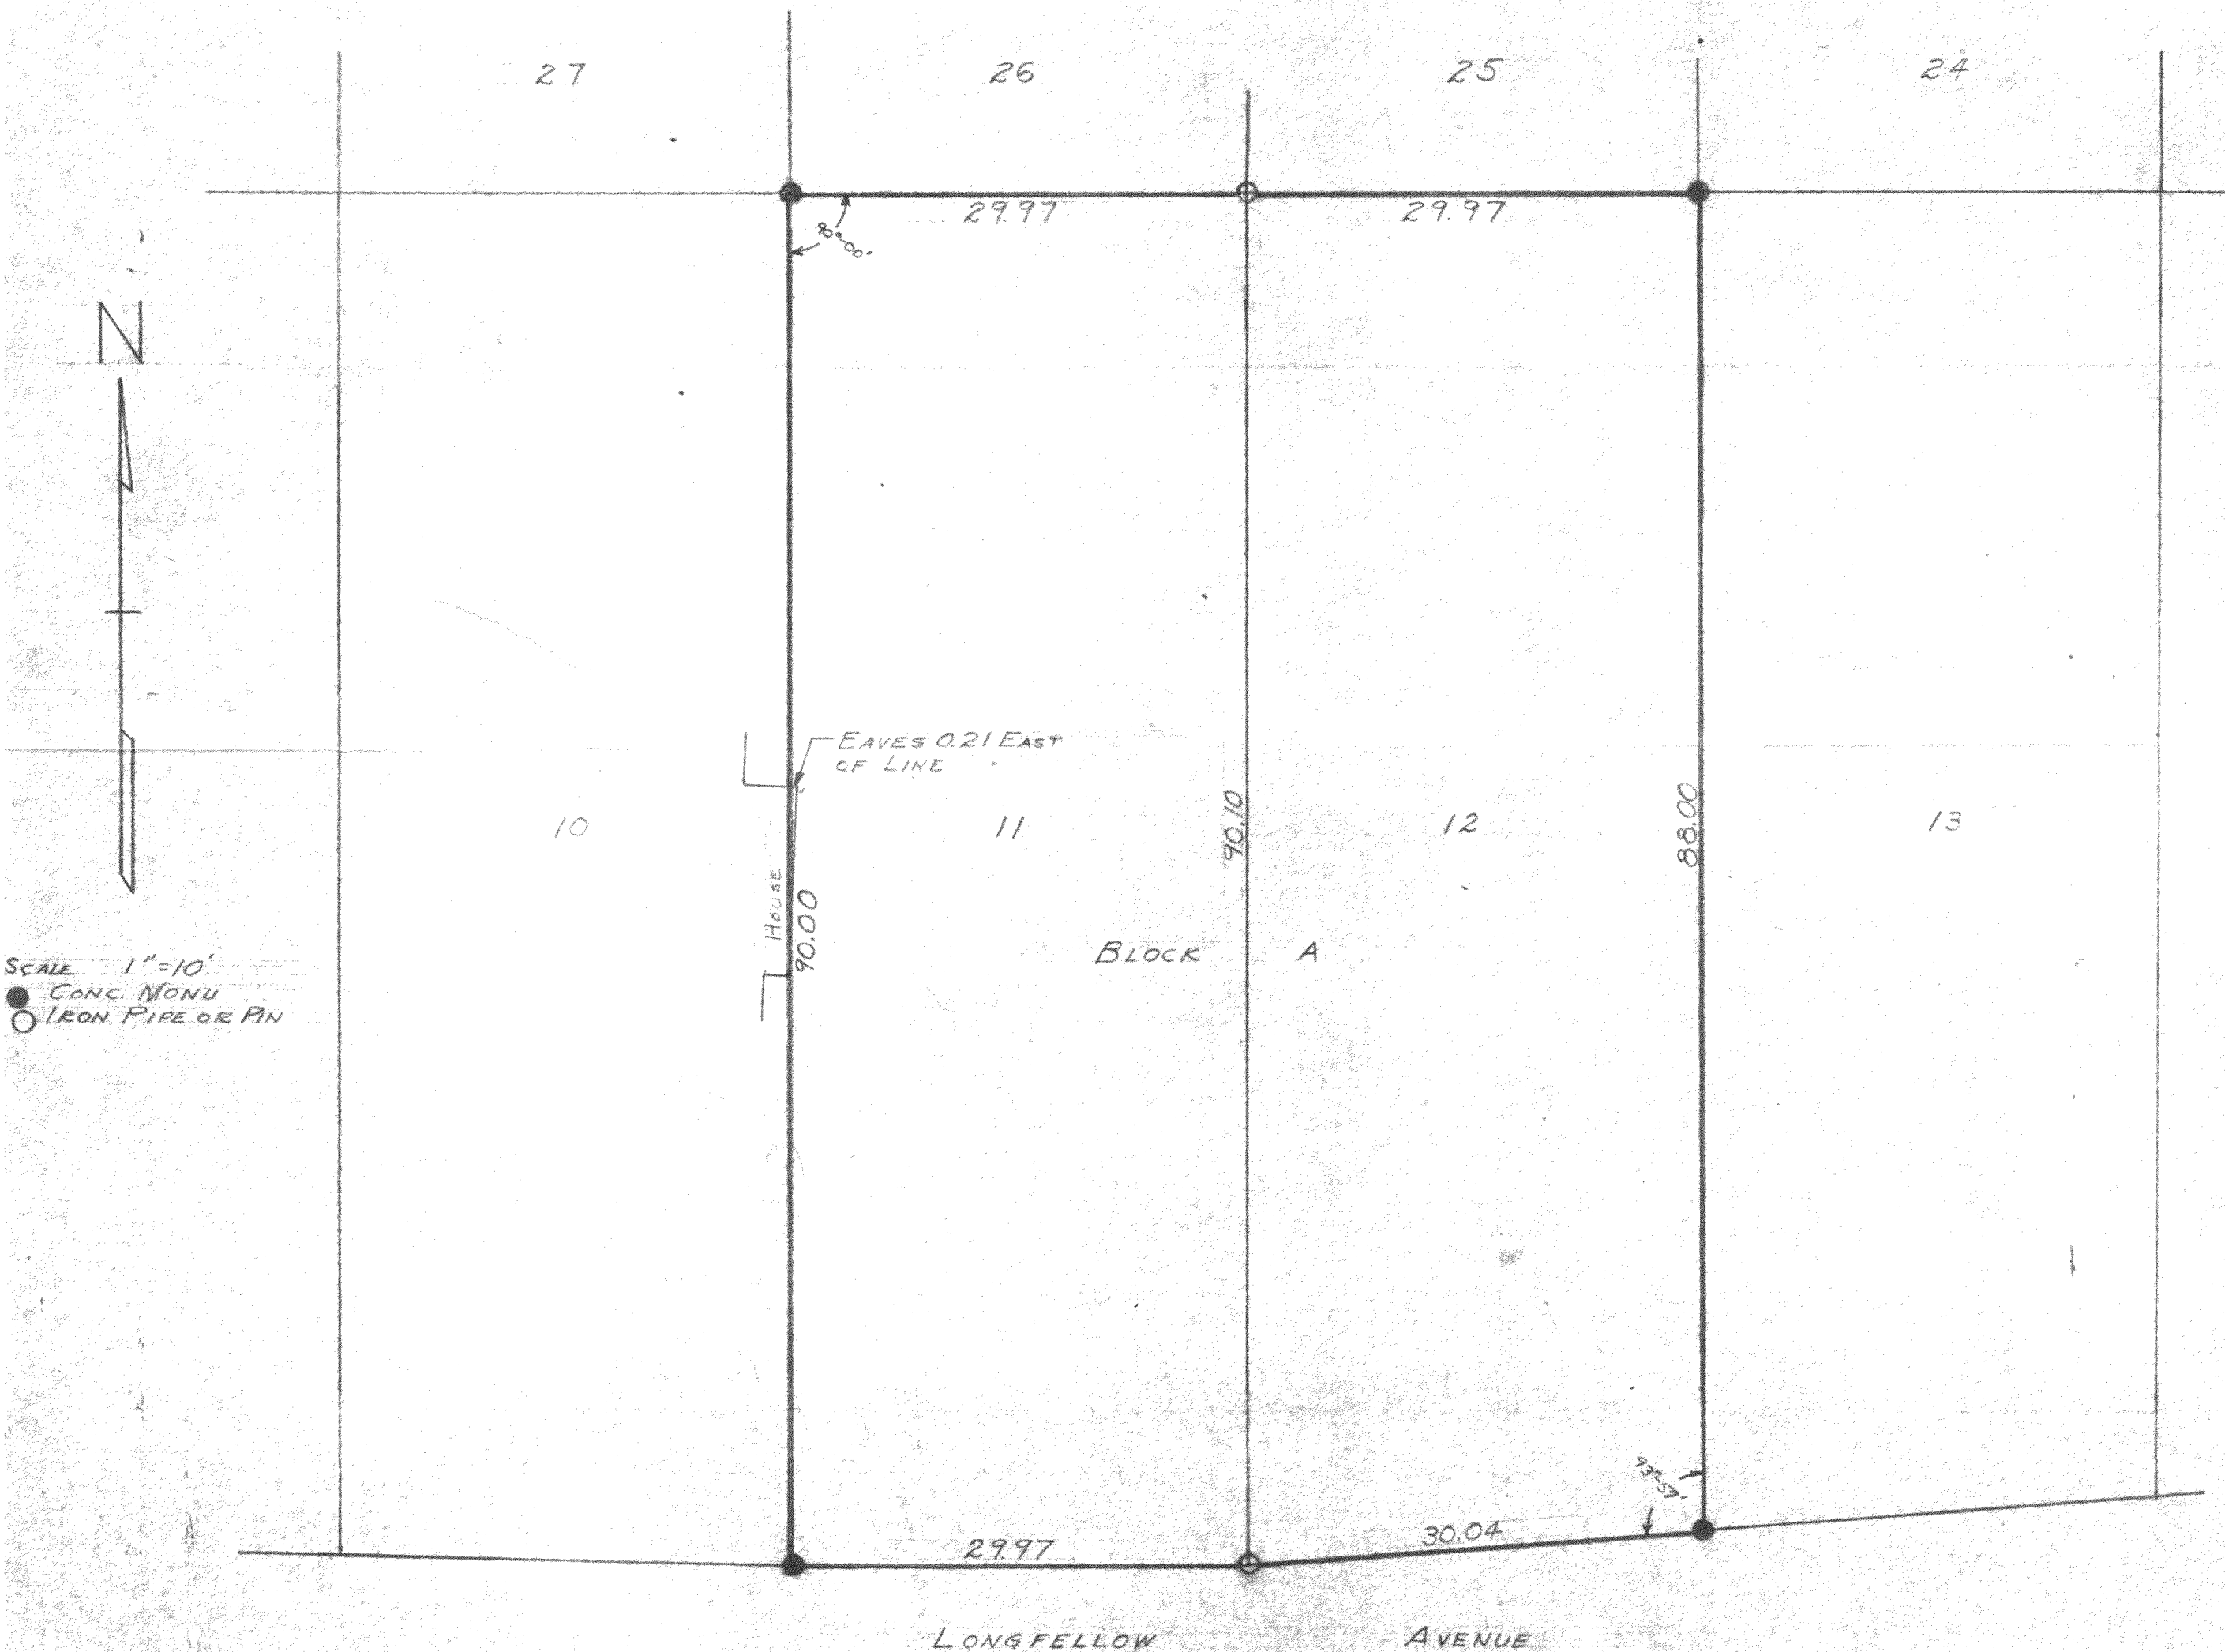

PLAT OF SURVEY OF LOTS 11 & 12, BLOCK A OF DELAVAN LAKE
 ASSEMBLY GROUNDS SUBD, LOCATED IN SECTION 21, T2N R16E
 WALWORTH COUNTY, WISCONSIN

MAY 1952

Lloyd LaFense
 COUNTY SURVEYOR

216-10001

FOLA-10