


D D Cooper & CO., INC



Rt 4 Box 508B * Elkhorn WI 53121

Plat of Survey of Lots 26, 27, 28, 29, Block C of Jackson Park Subdivision
located in the Southeast 1/4 of Section 21, T2N, R16E, Walworth County, Wisconsin.

Survey ordered by Keefe Realty-Walworth, WI

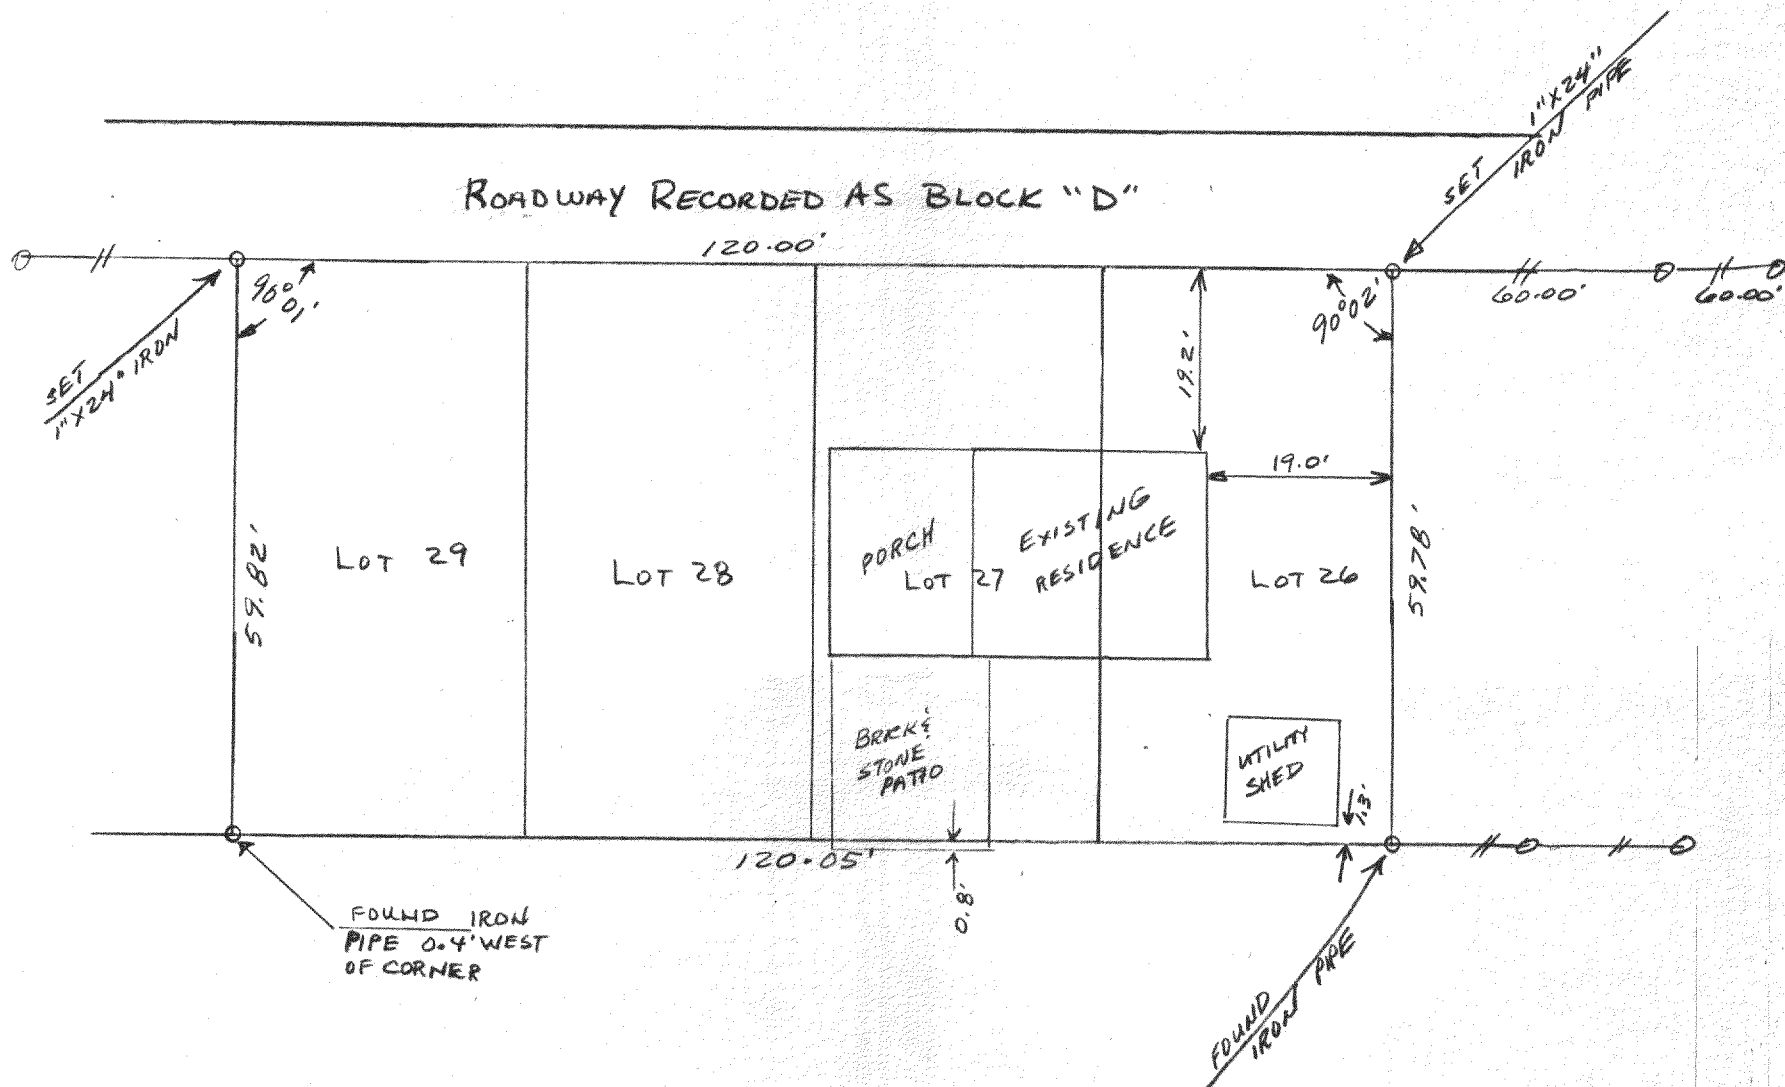

SCALE 1"=20'

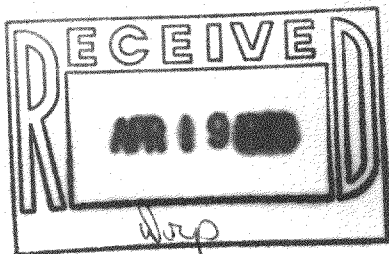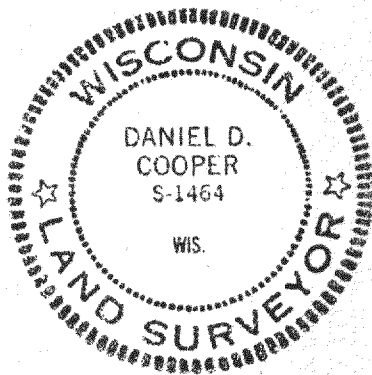

I hereby certify that I have surveyed the
property described hereon and that the
map shown hereon is a true and accurate
representation thereof to the best of my
professional knowledge and belief.

Dated this 13 day of April, 1988

Daniel D. Cooper
Daniel D. Cooper, RLS No. S-1464