
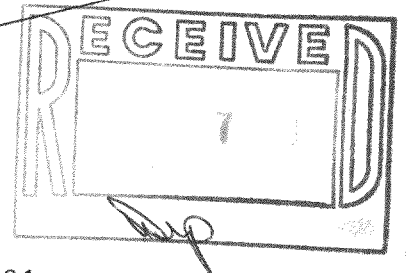


**ABELL
SURVEYING & MAPPING
DELAVAN, WISCONSIN 53115
414-728-6737**

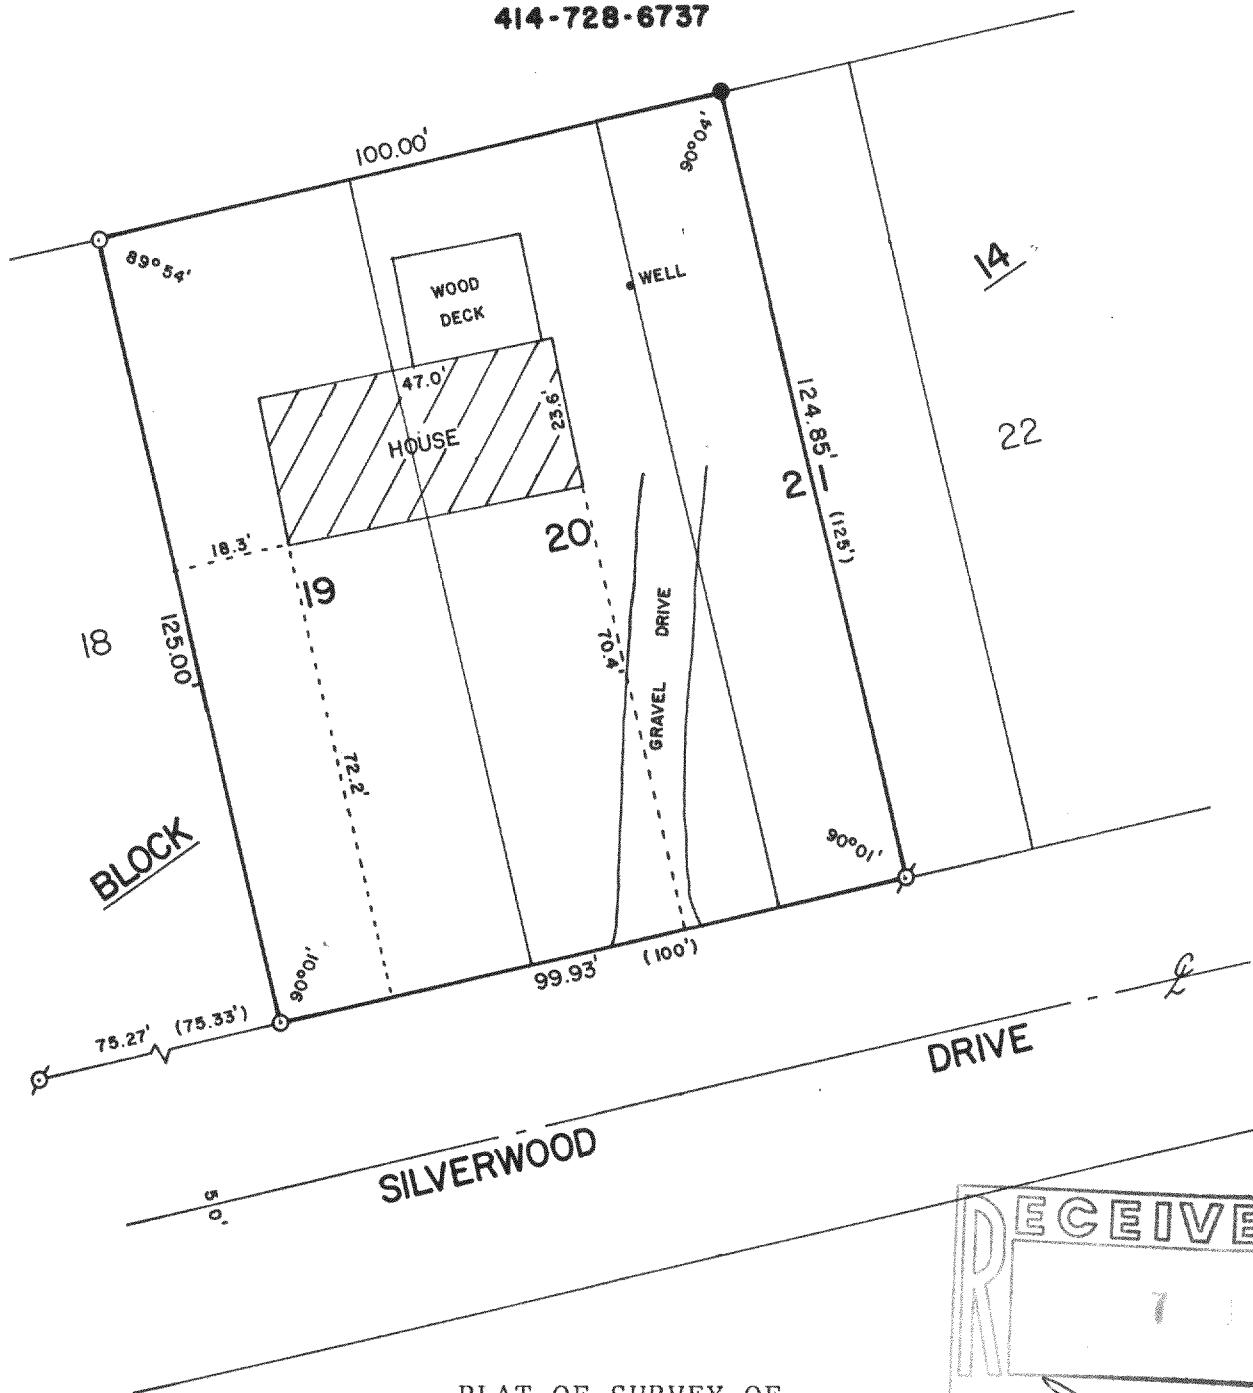


PLAT OF SURVEY OF

LOTS 19 AND 20 AND THE WEST 1/2 OF LOT 21,
BLOCK 14 OF DELAVAN LAKE VIEW CREST, A
SUBDIVISION LOCATED IN TOWN 2 NORTH, RANGE
16 EAST, WALWORTH COUNTY, WISCONSIN.

ORDERED BY: CENTURY 21 - SKANDIA REALTY
312 S. 7th STREET
DELAVAN, WI. 53115

NOTE: LOCATION OF DRIVEWAY IS APPROXIMATE DUE TO
SNOW COVER.

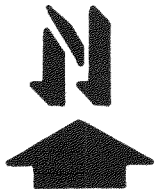

SCALE - 1"=30'

LEGEND

- ⊗ - IRON PIPE FOUND
- - IRON ROD FOUND
- - IRON ROD SET
- () - RECORDED AS

I, DAVID F. ABELL, DO HEREBY CERTIFY
THAT I HAVE SURVEYED THE PROPERTY
HEREON DESCRIBED ACCORDING TO THE
OFFICIAL RECORDS AND THAT THE PLAT
HEREON IS A CORRECT REPRESENTATION
OF THE PROPERTY LINES TO THE BEST OF
MY KNOWLEDGE AND BELIEF.

David F. Abell

DAVID F. ABELL
WISCONSIN REGISTERED LAND SURVEYOR, S-1596

DATE *January 25, 1988* JOB NUMBER - 88008

NOTE: THIS IS NOT A CERTIFIED COPY UNLESS SEALED.