


PLAT OF SURVEY OF
LOT 36 OF KRUMHAR'S ADDITION
TO RAVENSWOOD, LOCATED IN
T2N, R16E, WALWORTH COUNTY,
WISCONSIN.

ORDERED BY:
NANCY LAHO (OWNER)
2100 LINCOLN PARK WEST
CHICAGO, IL. 60614

LOT 35

LOT 36

LOT 37

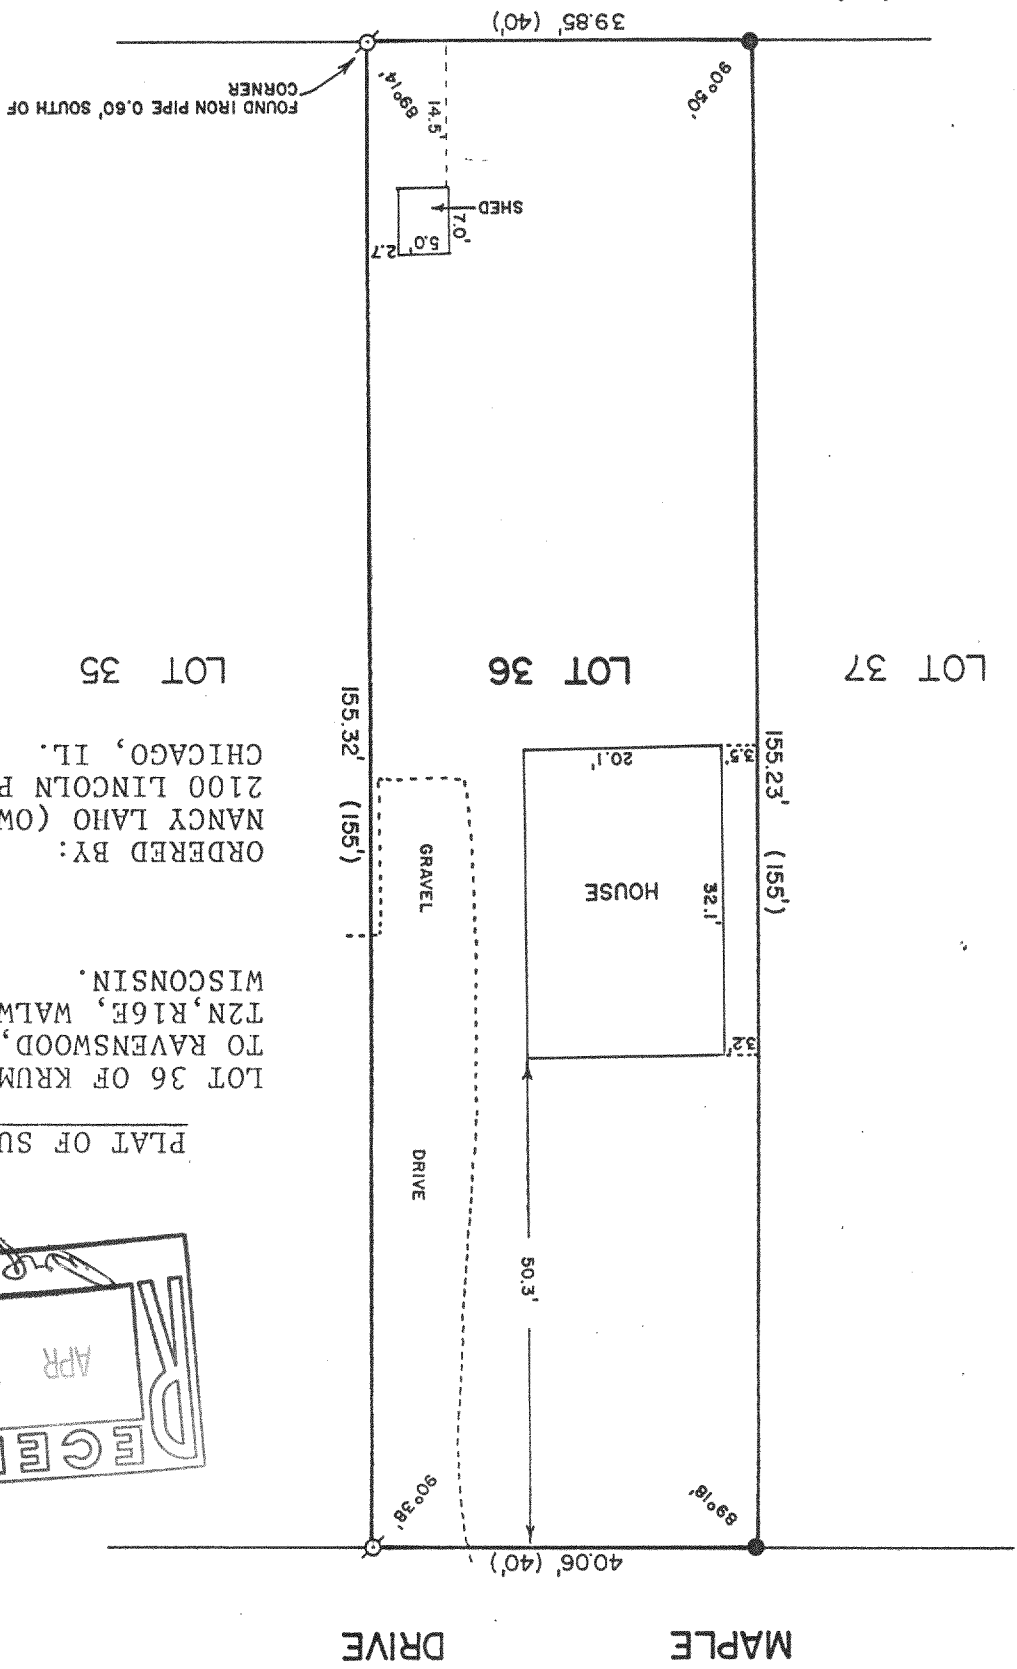

I, DAVID F. ABELL, DO HEREBY CERTIFY
THAT I HAVE SURVEYED THE PROPERTY
HEREON DESCRIBED ACCORDING TO THE
OFFICIAL RECORDS AND THAT THE PLAT
HEREON IS A CORRECT REPRESENTATION
OF THE PROPERTY LINES TO THE BEST OF
MY KNOWLEDGE AND BELIEF.

David F. Abell

DAVID F. ABELL

WISCONSIN REGISTERED LAND SURVEYOR, S-1596

DATE March 10, 1988 JOB NUMBER - 88029

NOTE: THIS IS NOT A CERTIFIED COPY UNLESS SEALED.

SCALE - 1"=20'
LEGEND
○ - IRON PIPE FOUND
● - IRON ROD FOUND
() - RECORDED AS