


DELAYAN

LAKE

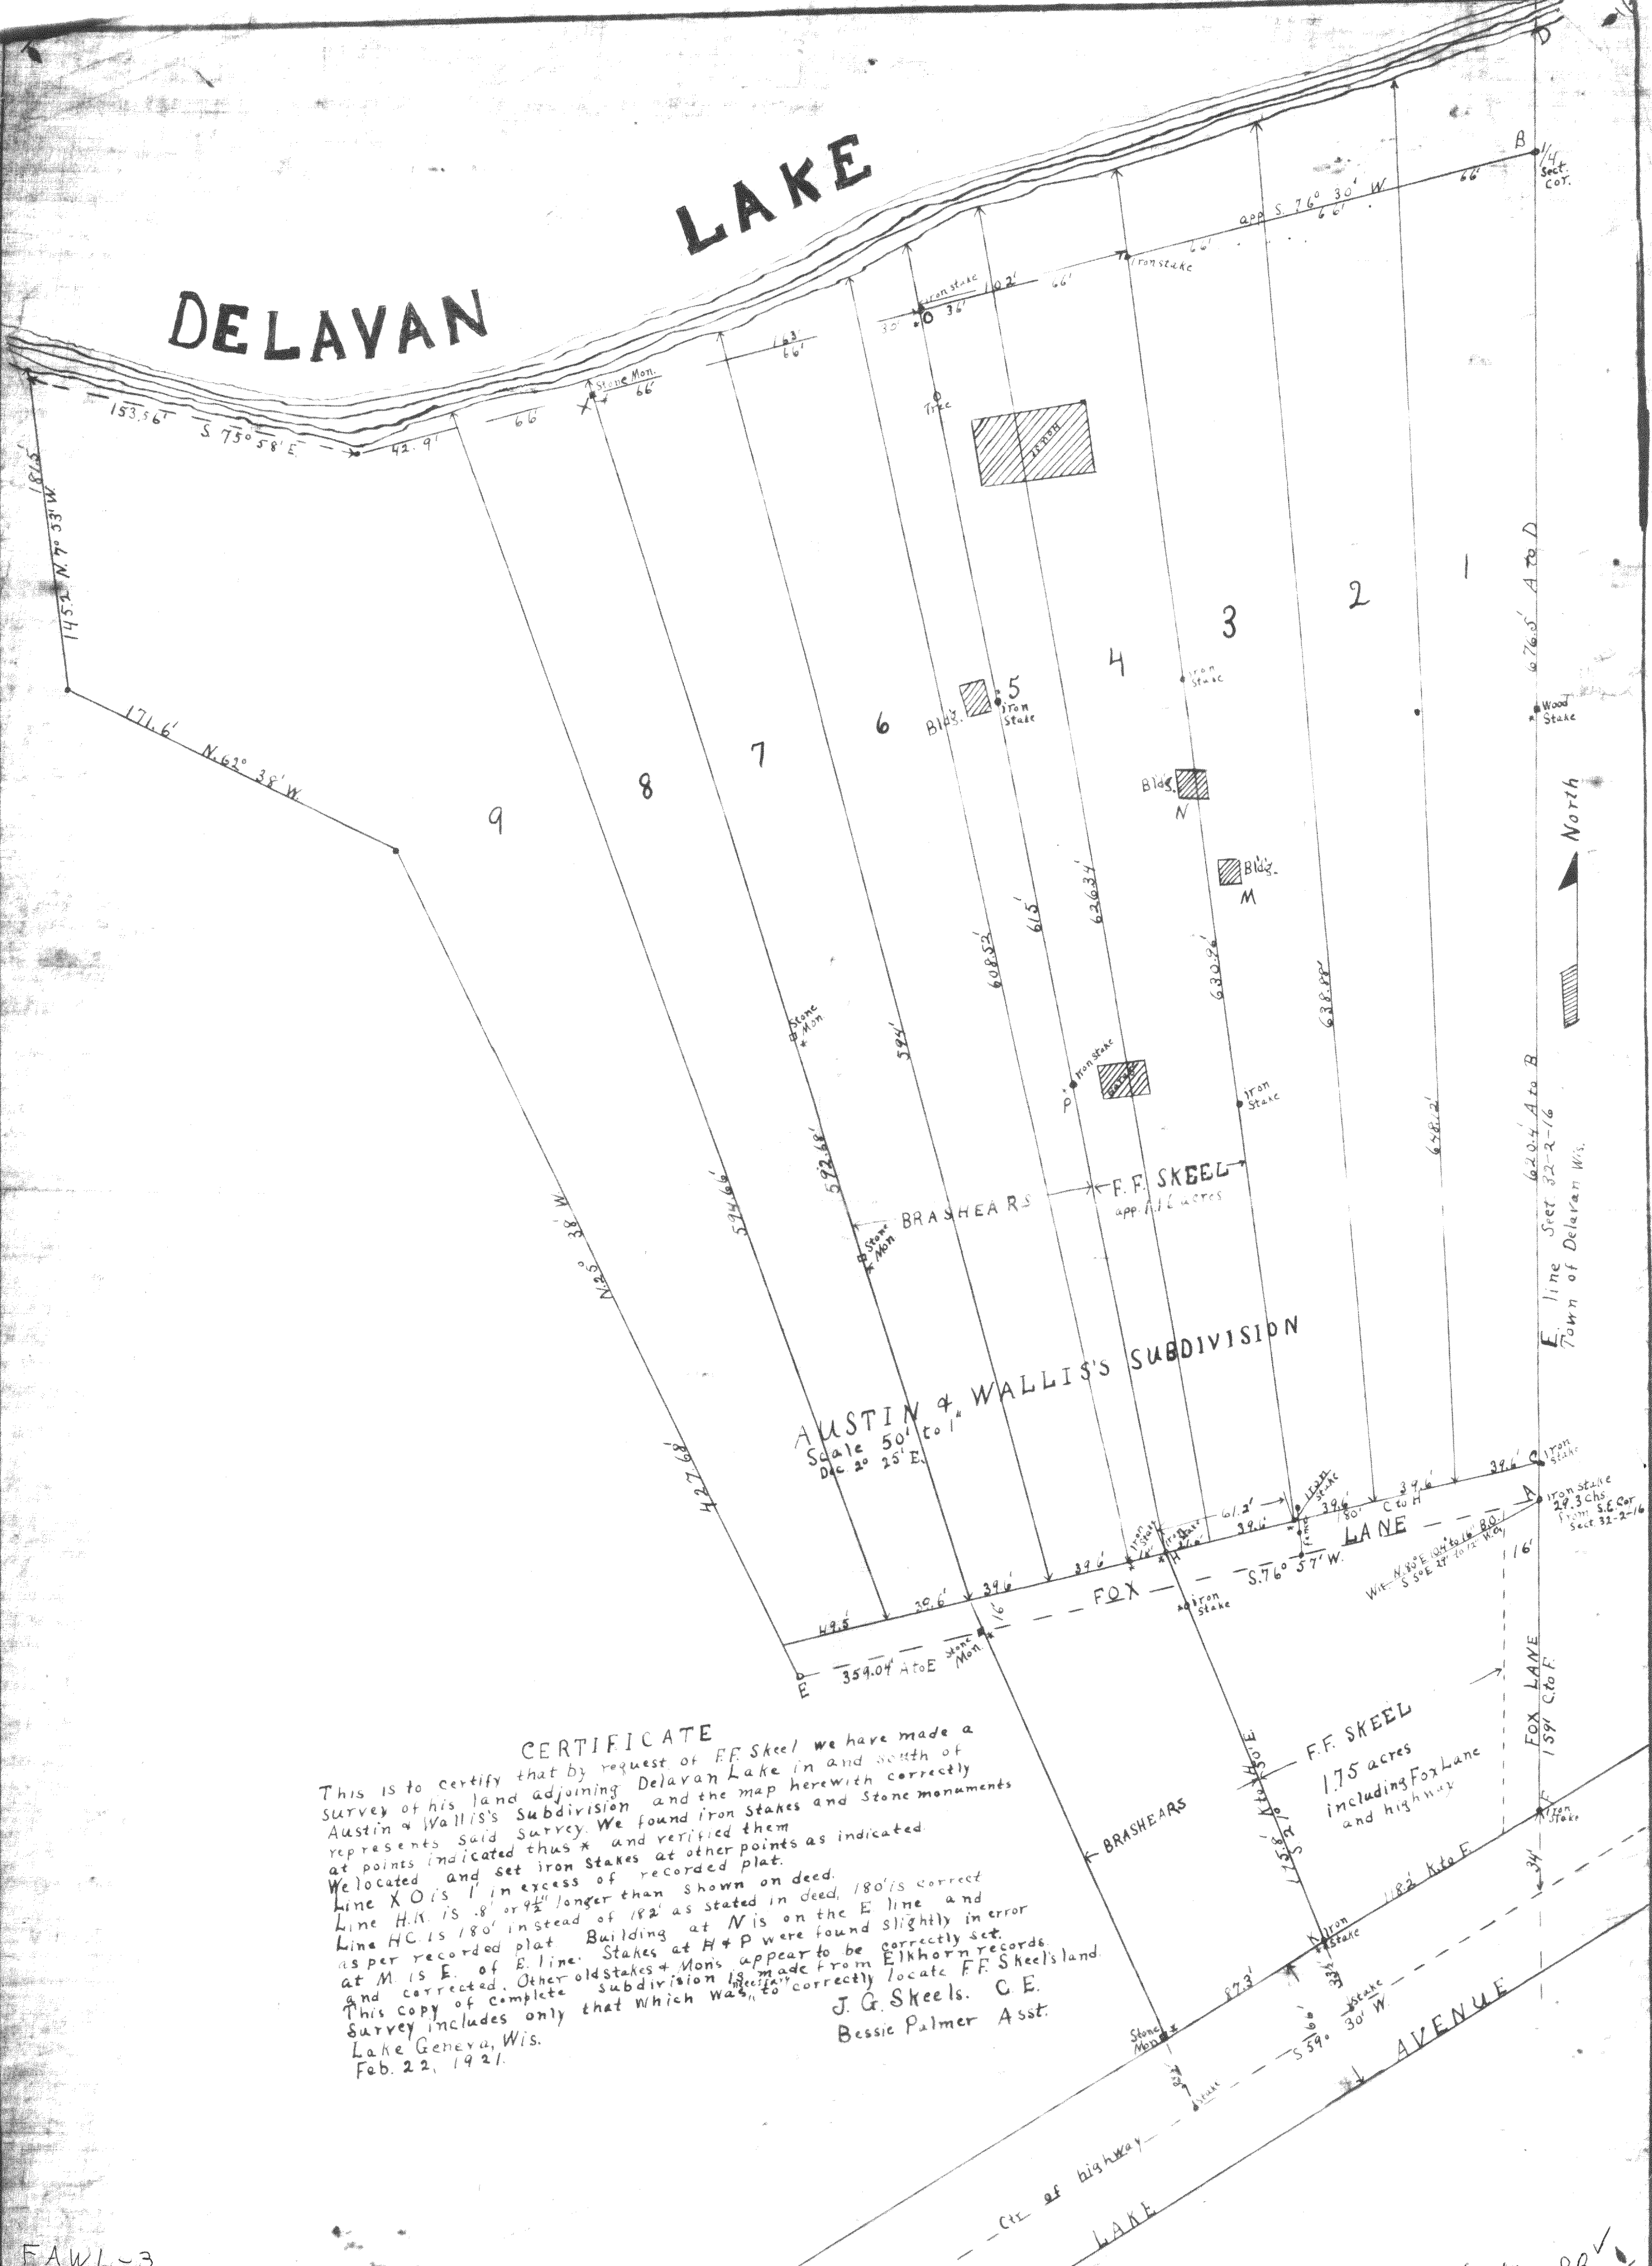

CERTIFICATE

This is to certify that by request of F.F. Skeel we have made a survey of his land adjoining Delavan Lake in and south of Austin & Wallis's Subdivision and the map herewith correctly represents said survey. We found iron stakes and stone monuments at points indicated thus * and verified them. We located and set iron stakes at other points as indicated. We located and set iron stakes at other points as indicated. Line X.O.'s 1' in excess of recorded plat. Line H.K. is 180' instead of 182' as stated in deed, 180' is correct as per recorded plat. Building at M is on the E line and at M is E. of E. line. Stakes at H & P were found slightly in error and corrected. Other old stakes & Mon. appear to be correctly set. This copy of complete subdivision is made from Elk Horn records. Survey includes only that which was to correctly locate F.F. Skeel's land.

J.G. Skeels. C.E.
Bessie Palmer Asst.

Lake Geneva, Wis.
Feb. 22, 1921.

25

2/22/21

Survey for
subdivision, Sect. 32,Lot 4 and all of Lot
5, end and 30' wide

of land between said

Ave. a public high

Beginning at an iron stake

of the S. W. cor. of said

of highway, (229.2) thence

(118.8) to E. line Sect. 32,

iron stake, at the S. E. Cor.

57' along the S line of

beginning.

Stone monuments along the

a line running app. par

highway, iron stakes were

mentioned line (S. 21° 50' E) 25th

above dividing lot 4 N. & S.

1 1/2" too far east. Set new

giving lake shore line is

R. F. Skeel, Austin & Wallis

-2-16, Delavan Lake

except a strip, 18' wide at

at N. end also, a ~~strip~~ parcel

plat subdivision and Lake

way, running N.E. & S.W. describe

in S. line of lot 5 18' East

lot thence S. 21° 50' E, to center

N. 2. along ctr. of highway

thence N. in said E. line to an

of said subdivision, thence S. 76°

said Sub. 180' to place of

W. side of lot 4, and also, along

S. line Brasshear's 8 1/2' to

also found set along the above

also along the line mentioned.

4 stakes, No. 2 from south was

stake. If the line of stakes

set correctly Brasshear has

Lots 4 + part of 5 Austin & Wallis hold

216-10022

26

1' more on said line than plat indicates.

Measured ~~app.~~ & app. parallel Brashear's E. stake and set line. With transit run rand of above stake and set and set over $\frac{2}{3}$ & $\frac{1}{3}$ of

runs thru a building on long ^{known} extreme stakes, to total located cor. at S.E. Cor. E &

1933.8' N. of S.E. Cor. Set. Sect. line 16' N. of above stake, about $\frac{2}{3}$ distance to lake, 1' from W. line lot 4

Whether Brashear's E. or W. be determined without a re-survey. Boundaries of parcel exclusive of road, N. 150' W. 195.8' S. 118.2'

E. ~~159~~ 159, including Fox Lane 16' Witness to stake at E end S line of lot 4 (N. 80° 2', 16' B.O. 124' S. 55° 29' to 12' W. 6)

See description on back copy

(66' wide)

Brashear, has lots 6 & 7 and 30 off at lot 5, 162', actually 163' with lake shore. 102' from

iron stake, app. 38' from low water on line between two bkks. 94' E.

two iron stakes, each at $\frac{1}{3}$ distance random divergence. This line

Sheels lot. said line is 592.5' to lake 630.5'

W. ^{part} of Fox Lane, said to be 32. also set iron stake on

stake found on said sect. line Lake shore line is short

as previously set. line at lake is wrong; cannot

of whole plat. See blue print No. 345

J. G. Sheels surveyor Bessie Palmer Asst

Declination ^{used} 2° 25' (Dec. on original plat. 30 42)

For complete description & copy see letter file

In the deed the front lot is described
as follows: ^{Delavan Lake}
F.F. Skeel, in Austin & Wallis Sub.
"In Austin & Wallis' subdivision, Lot four(4)
and that portion of Lot five(5) East of a line
drawn from a point on water's edge thirty (30) ft.
East of the West line of said Lot five(5) and in-
tersecting the back line of said Lot (5) at a
point East of the West lot line a distance which
shall bear the same proportion to the length of
the total rear line of said lot five (5), that
thirty (30) ft. does to the total front line of
said lot five(5): said property being in Section
thirty-two, Township two (2), North, Range sixteen
(16), East of the fourth Principal Meridian."

Feb. 1, 1921

on cent line
strong plate to