


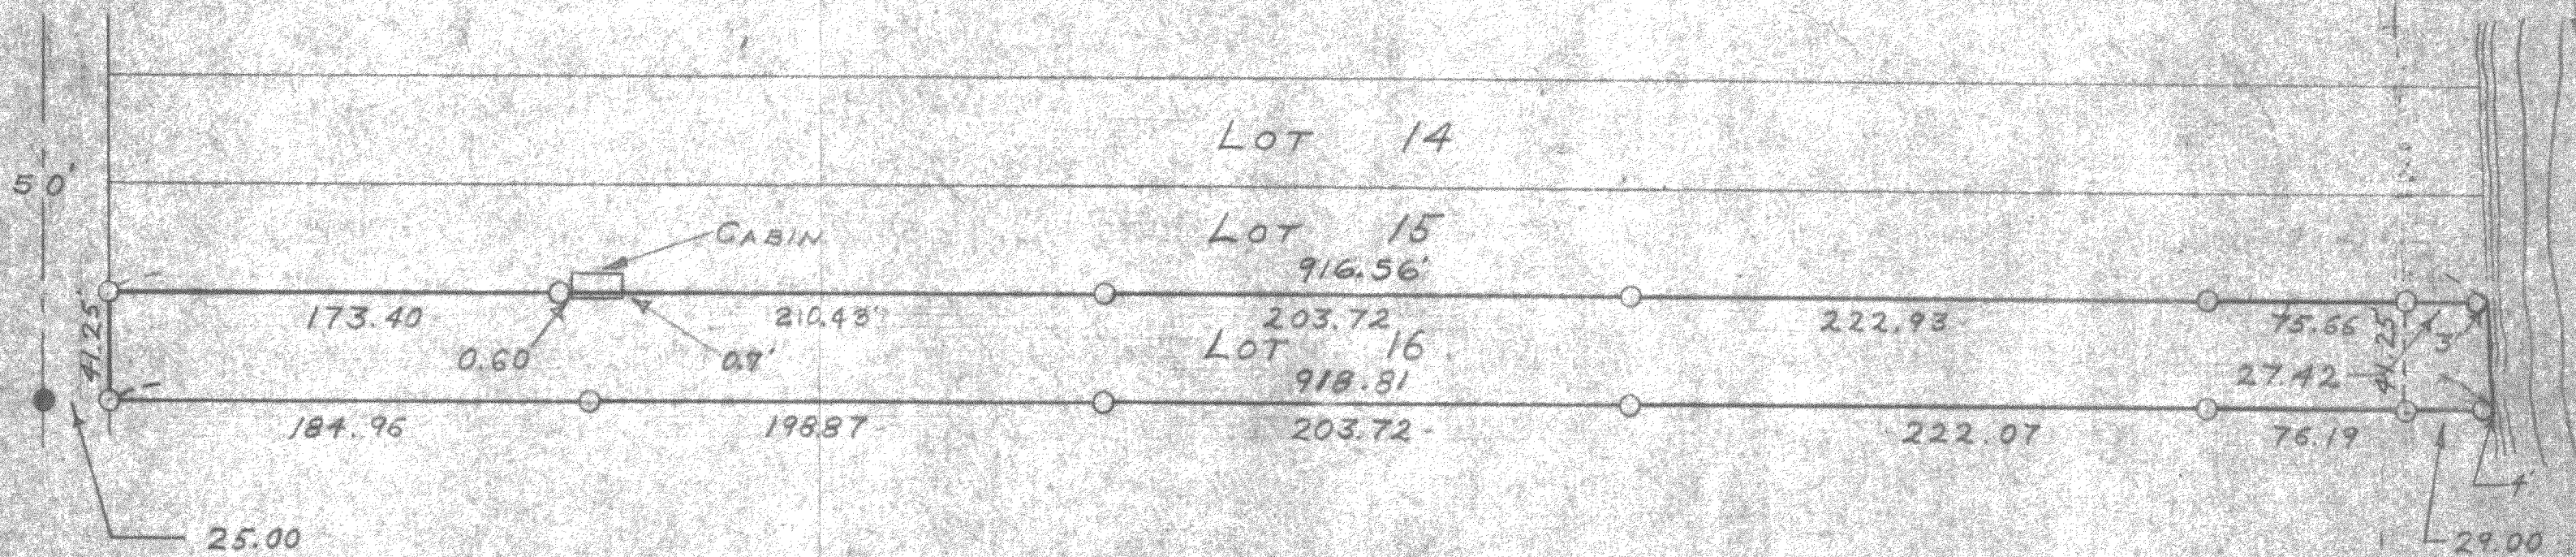

FLAT OF A SURVEY OF LOT 16 OF STROW
PARK SUBDIVISION, LOCATED IN SECTION 28, T2N R16E
OF WALWORTH COUNTY, WISCONSIN
JULY 1952

Lloyd L. Jensen
WALLBORTH COUNTY SURVEYOR

216-102.1