


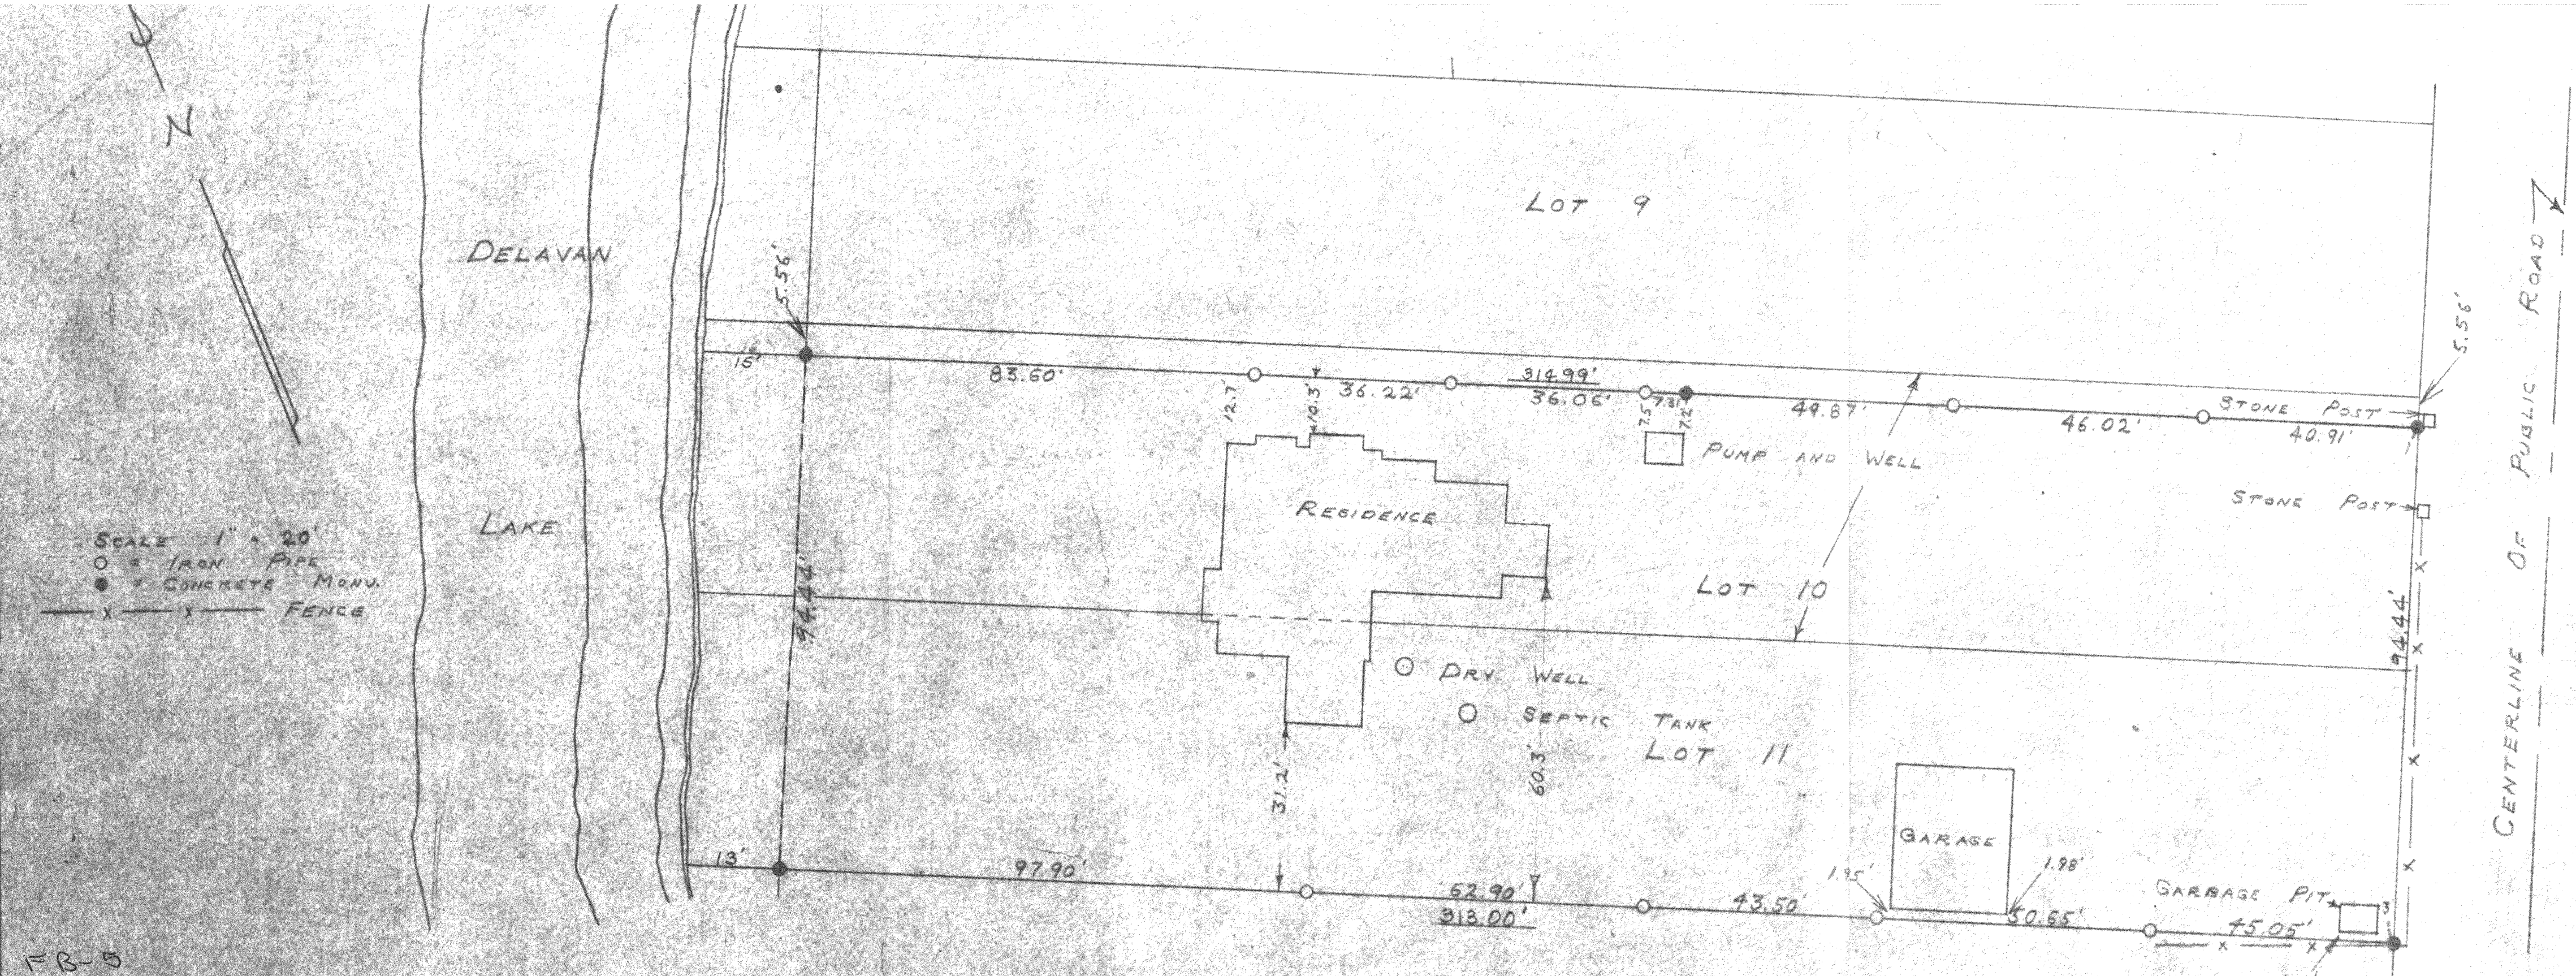

I HEREBY CERTIFY: THAT I HAVE SURVEYED THE LAND SHOWN ON THIS PLAT ACCORDING TO THE OFFICIAL RECORDS, THE DESCRIPTION OF SAID LAND IS AS FOLLOWS: LOTS NUMBERED TEN (10) AND ELEVEN (11), IN BAILEYS SUBDIVISION OF A PART OF SECTION 27, T2NR16E, WALWORTH COUNTY, WISCONSIN, EXCEPTING THEREFROM THE NORTHERLY 5.56 FEET OF SAID LOT 10; THAT I HAVE LOCATED ALL BUILDINGS, FENCES, AND OTHER IMPROVEMENTS THAT ARE ON THE PROPERTY AS DESCRIBED HEREIN; THAT THE PLAT SHOWN HEREON IS A CORRECT REPRESENTATION OF THE LOT LINES AND THE PRINCIPAL LINES OF ALL BUILDINGS AND OTHER IMPROVEMENTS THEREON.

JUNE 23, 1952

Lloyd L. Jensen
WALWORTH COUNTY SURVEYOR

216-103.1