
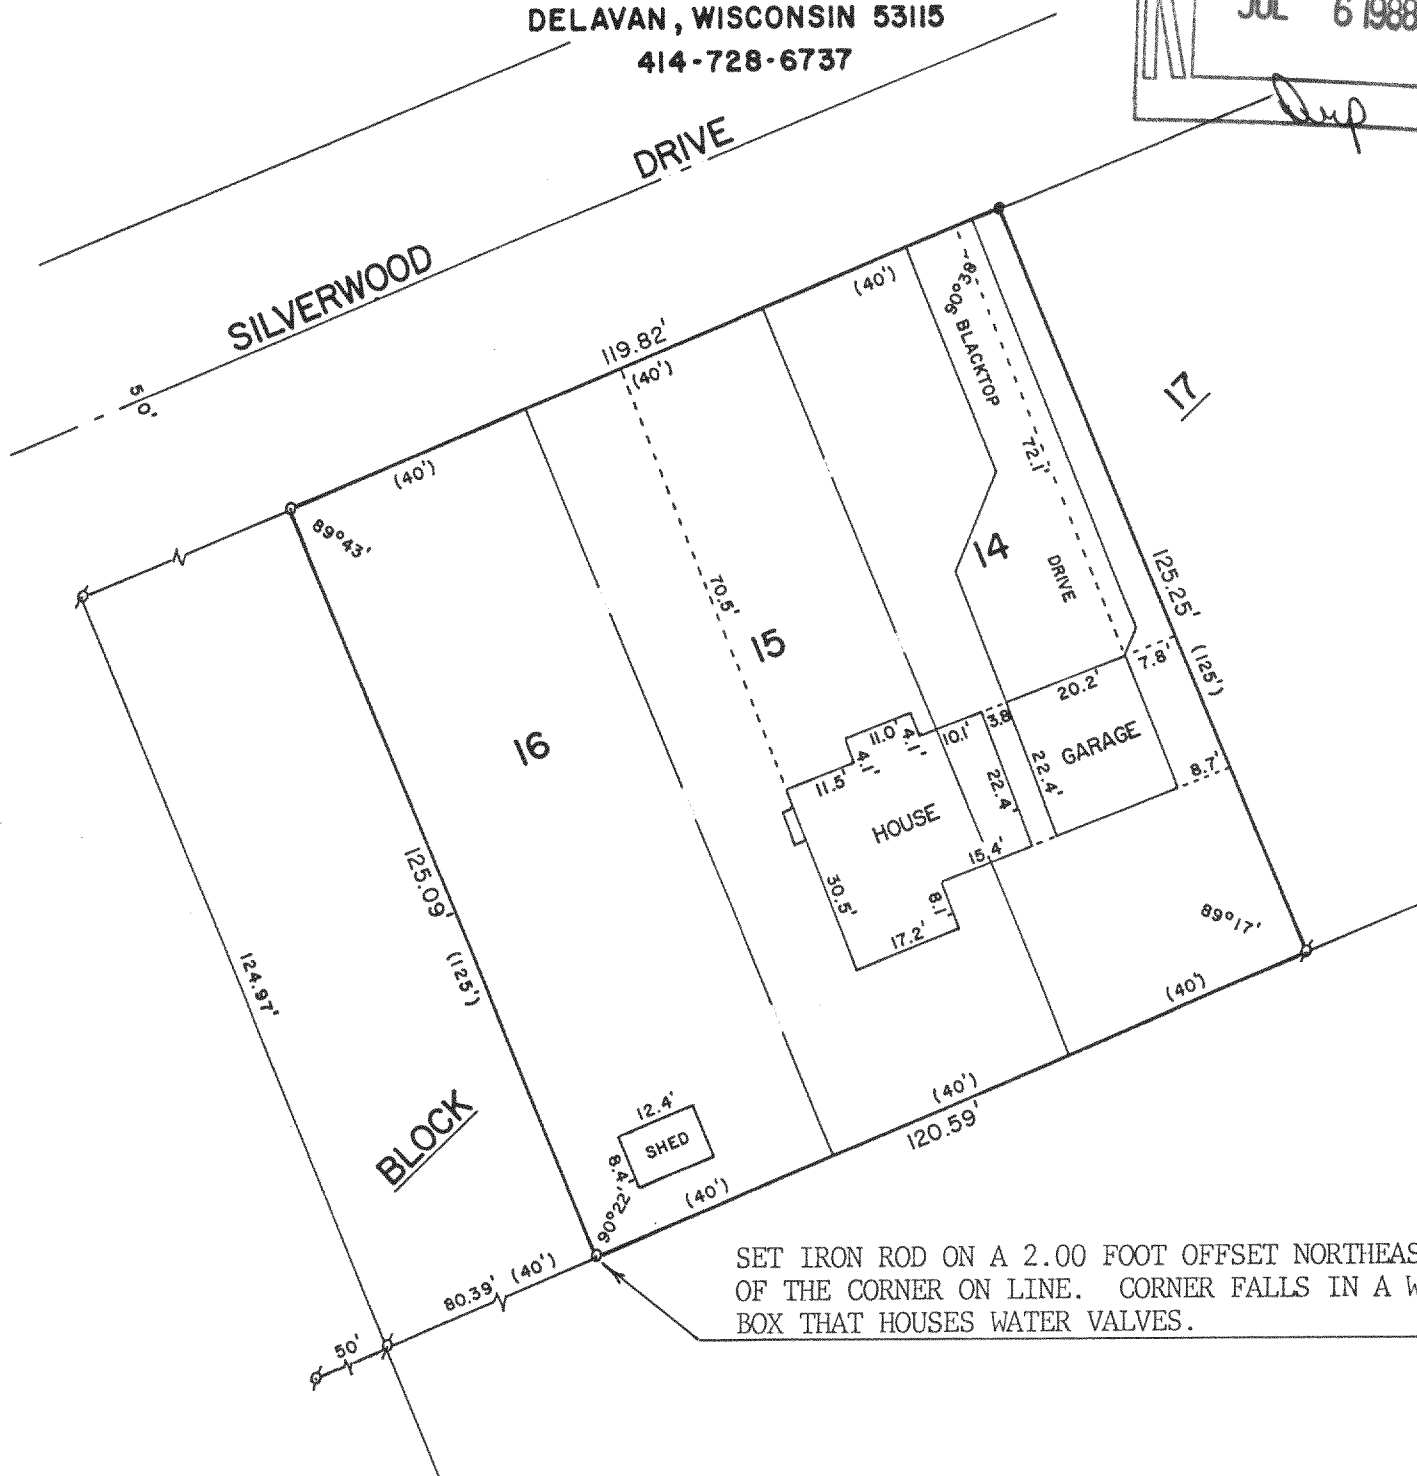


ABELL
SURVEYING & MAPPING
DELAN, WISCONSIN 53115
414-728-6737

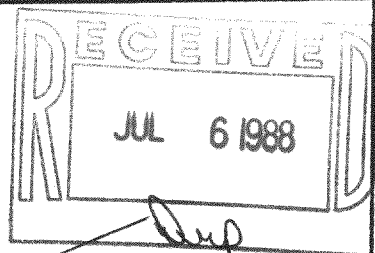


SET IRON ROD ON A 2.00 FOOT OFFSET NORTHEAST OF THE CORNER ON LINE. CORNER FALLS IN A WOOD BOX THAT HOUSES WATER VALVES.

PLAT OF SURVEY OF

LOTS 14-16, BLOCK 17 OF DELAN LAKE VIEW CREST, A SUBDIVISION LOCATED IN T2N,R16E, WALWORTH COUNTY, WISCONSIN.

ORDERED BY: JAMES MAHEU
4409 SILVERWOOD DR.
DELAN, WI. 53115

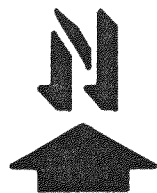

SCALE - 1"=30'

LEGEND

- ⊕ - IRON PIPE FOUND
- - IRON ROD FOUND
- - IRON ROD SET
- () - RECORDED AS

I, DAVID F. ABELL, DO HEREBY CERTIFY THAT I HAVE SURVEYED THE PROPERTY HEREON DESCRIBED ACCORDING TO THE OFFICIAL RECORDS AND THAT THE PLAT HEREON IS A CORRECT REPRESENTATION OF THE PROPERTY LINES TO THE BEST OF MY KNOWLEDGE AND BELIEF.

David F. Abell

DAVID F. ABELL
WISCONSIN REGISTERED LAND SURVEYOR, S-1596

June 20, 1988

DATE: _____ JOB NUMBER -88079

NOTE: THIS IS NOT A CERTIFIED COPY UNLESS SEALED.