


ABELL  
SURVEYING & MAPPING  
DELAVER, WISCONSIN 53115  
414-728-6737

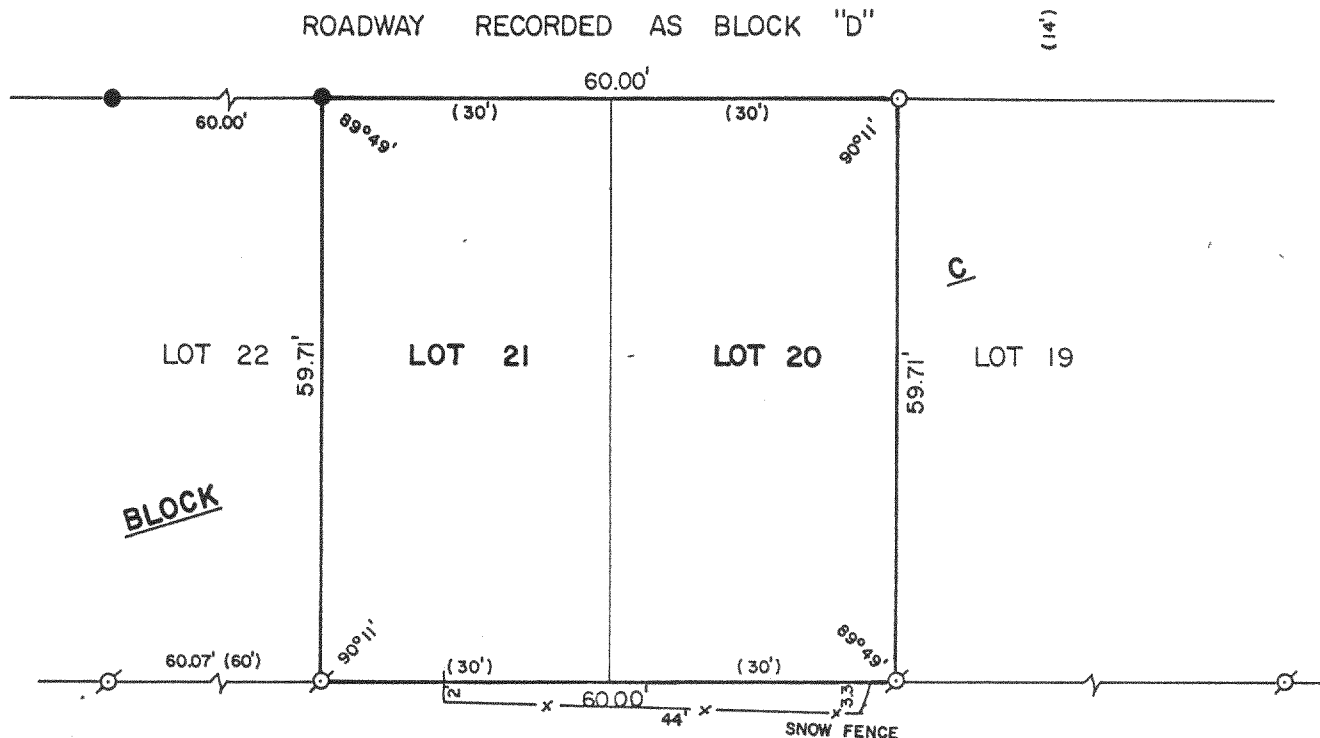

PLAT OF SURVEY OF

LOTS 20 AND 21, BLOCK C OF JACKSON'S SUBDIVISION,  
LOCATED IN THE SOUTHEAST 1/4 OF SECTION 21, T2N,  
R16E, WALWORTH COUNTY, WISCONSIN.

ORDERED BY: VACATION PROPERTIES NETWORK  
159 BROAD STREET  
LAKE GENEVA, WI. 53147

OWNER: BONNIE SWOGER

NOTE: THE HOUSE AND GARAGE WERE NOT LOCATED. THERE ARE NO  
VISIBLE ENCROACHMENTS EXCEPT AS SHOWN ON PLAT.



SCALE - 1"=20'

LEGEND

- Ø - IRON PIPE FOUND
- - IRON ROD FOUND
- - IRON ROD SET
- ( ) - RECORDED AS

I, DAVID F. ABELL, DO HEREBY CERTIFY  
THAT I HAVE SURVEYED THE PROPERTY  
HEREON DESCRIBED ACCORDING TO THE  
OFFICIAL RECORDS AND THAT THE PLAT  
HEREON IS A CORRECT REPRESENTATION  
OF THE PROPERTY LINES TO THE BEST OF  
MY KNOWLEDGE AND BELIEF.

*David F. Abell*

DAVID F. ABELL  
WISCONSIN REGISTERED LAND SURVEYOR, S-1596

*March 16, 1988*

DATE JOB NUMBER - 88034

NOTE: THIS IS NOT A CERTIFIED COPY UNLESS SEALED.