


DUNHAM SURVEYING, S.C.
SURVEYING & SUBDIVIDING
DELAVER, WISCONSIN 53115

N

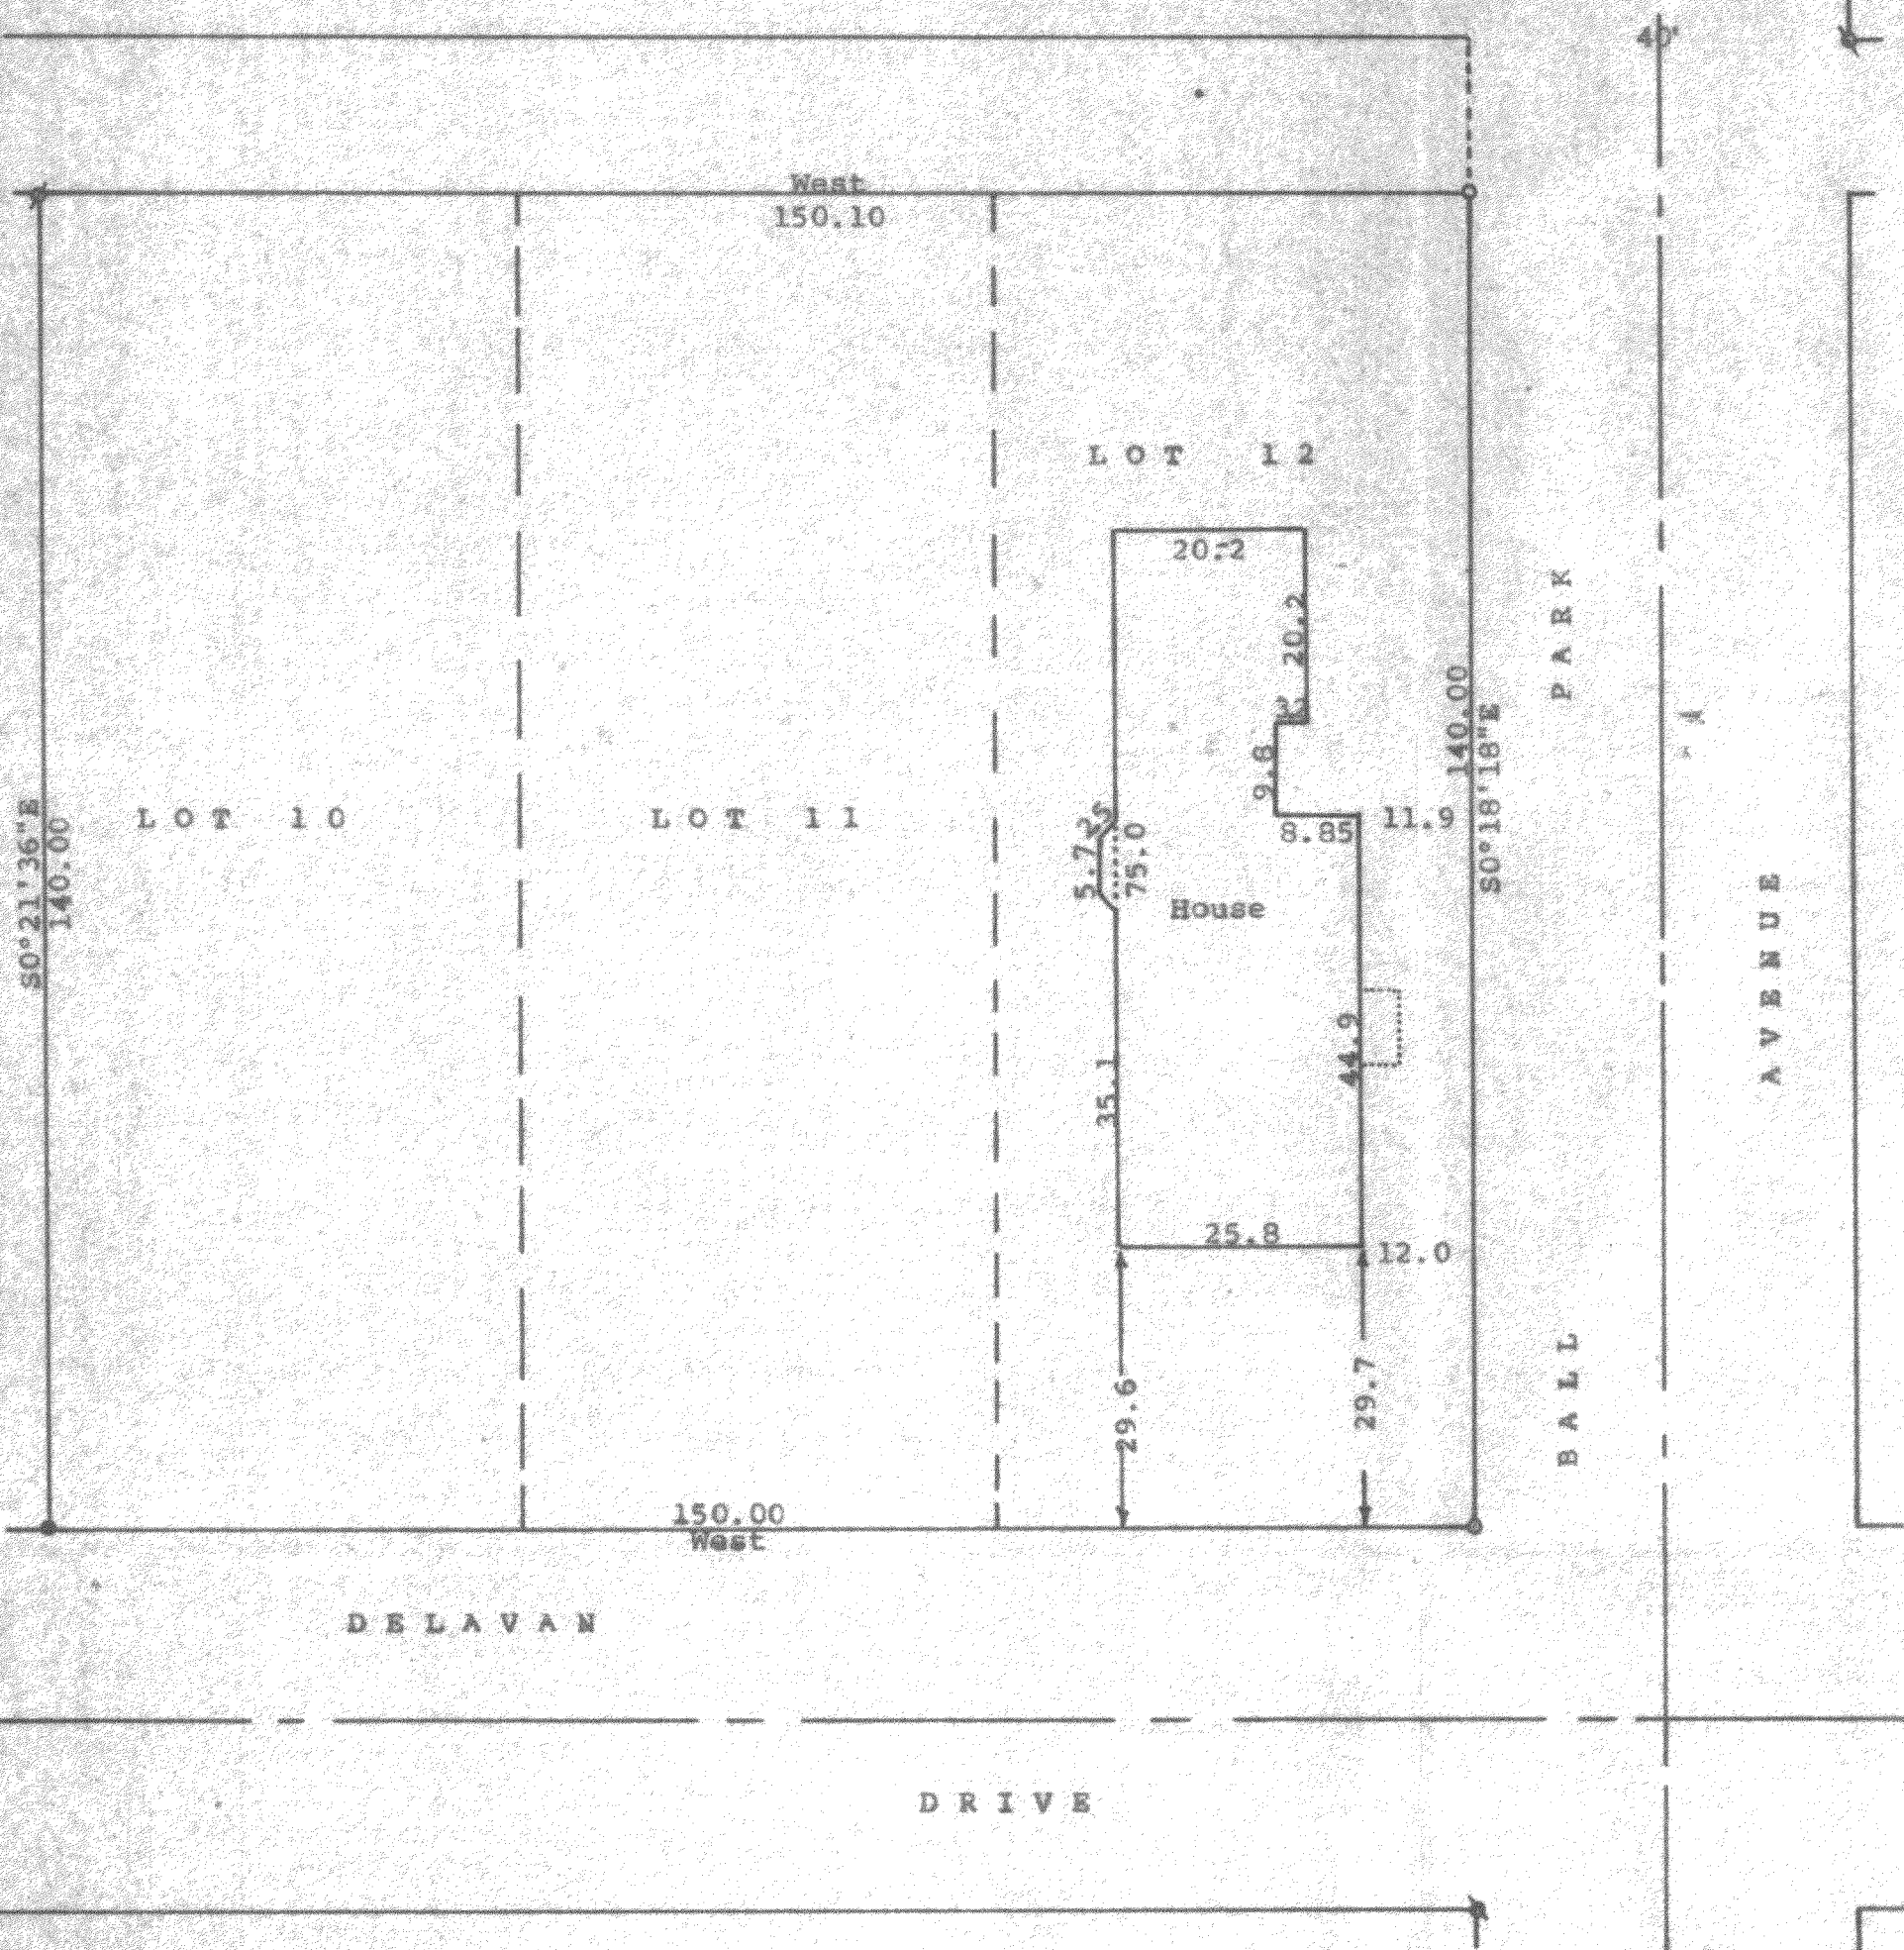


Scale - 1" = 20'
 * = 1 1/2" Iron Pipe Found
 # = 3/4" Iron Pipe Found
 @ = 1 1/4" Iron Pipe Found
 o = 3/4" X 24" Iron Pipe Set
 Bearings referenced to the assumed bearing
 of West along the northerly line of
 Delavan Drive
 Survey ordered by: Realty World, Carmin
 Realtors
 811 E. Geneva Street
 Delavan, WI 53115

STATE OF WISCONSIN)
COUNTY OF WALWORTH)

I, George T. Dunham, Surveyor, certify that I have surveyed
the property described as follows:

Lots 10, 11, and 12 in Block 2 of Inlet Oaks Subdivision No. 4
located in Section 15, T 2 N, R 16 E, Walworth County, Wisconsin,
and that the plat shown above is a correct representation thereof and shows
the size and location of the property, its exterior boundaries, the location
of all visible structures and dimensions of all principal buildings thereon,
boundary fences, apparent easements, roadways and visible encroachments, if
any, and that I have surveyed the property hereon described, according to the
official records, to the best of my knowledge and belief.
February 15, 1988

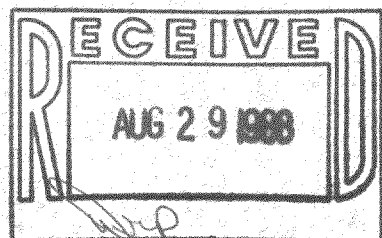

George T. Dunham
George T. Dunham, Surveyor

