


DUNHAM SURVEYING, S.C.  
SURVEYING & SUBDIVIDING  
DELAVER, WISCONSIN 53115

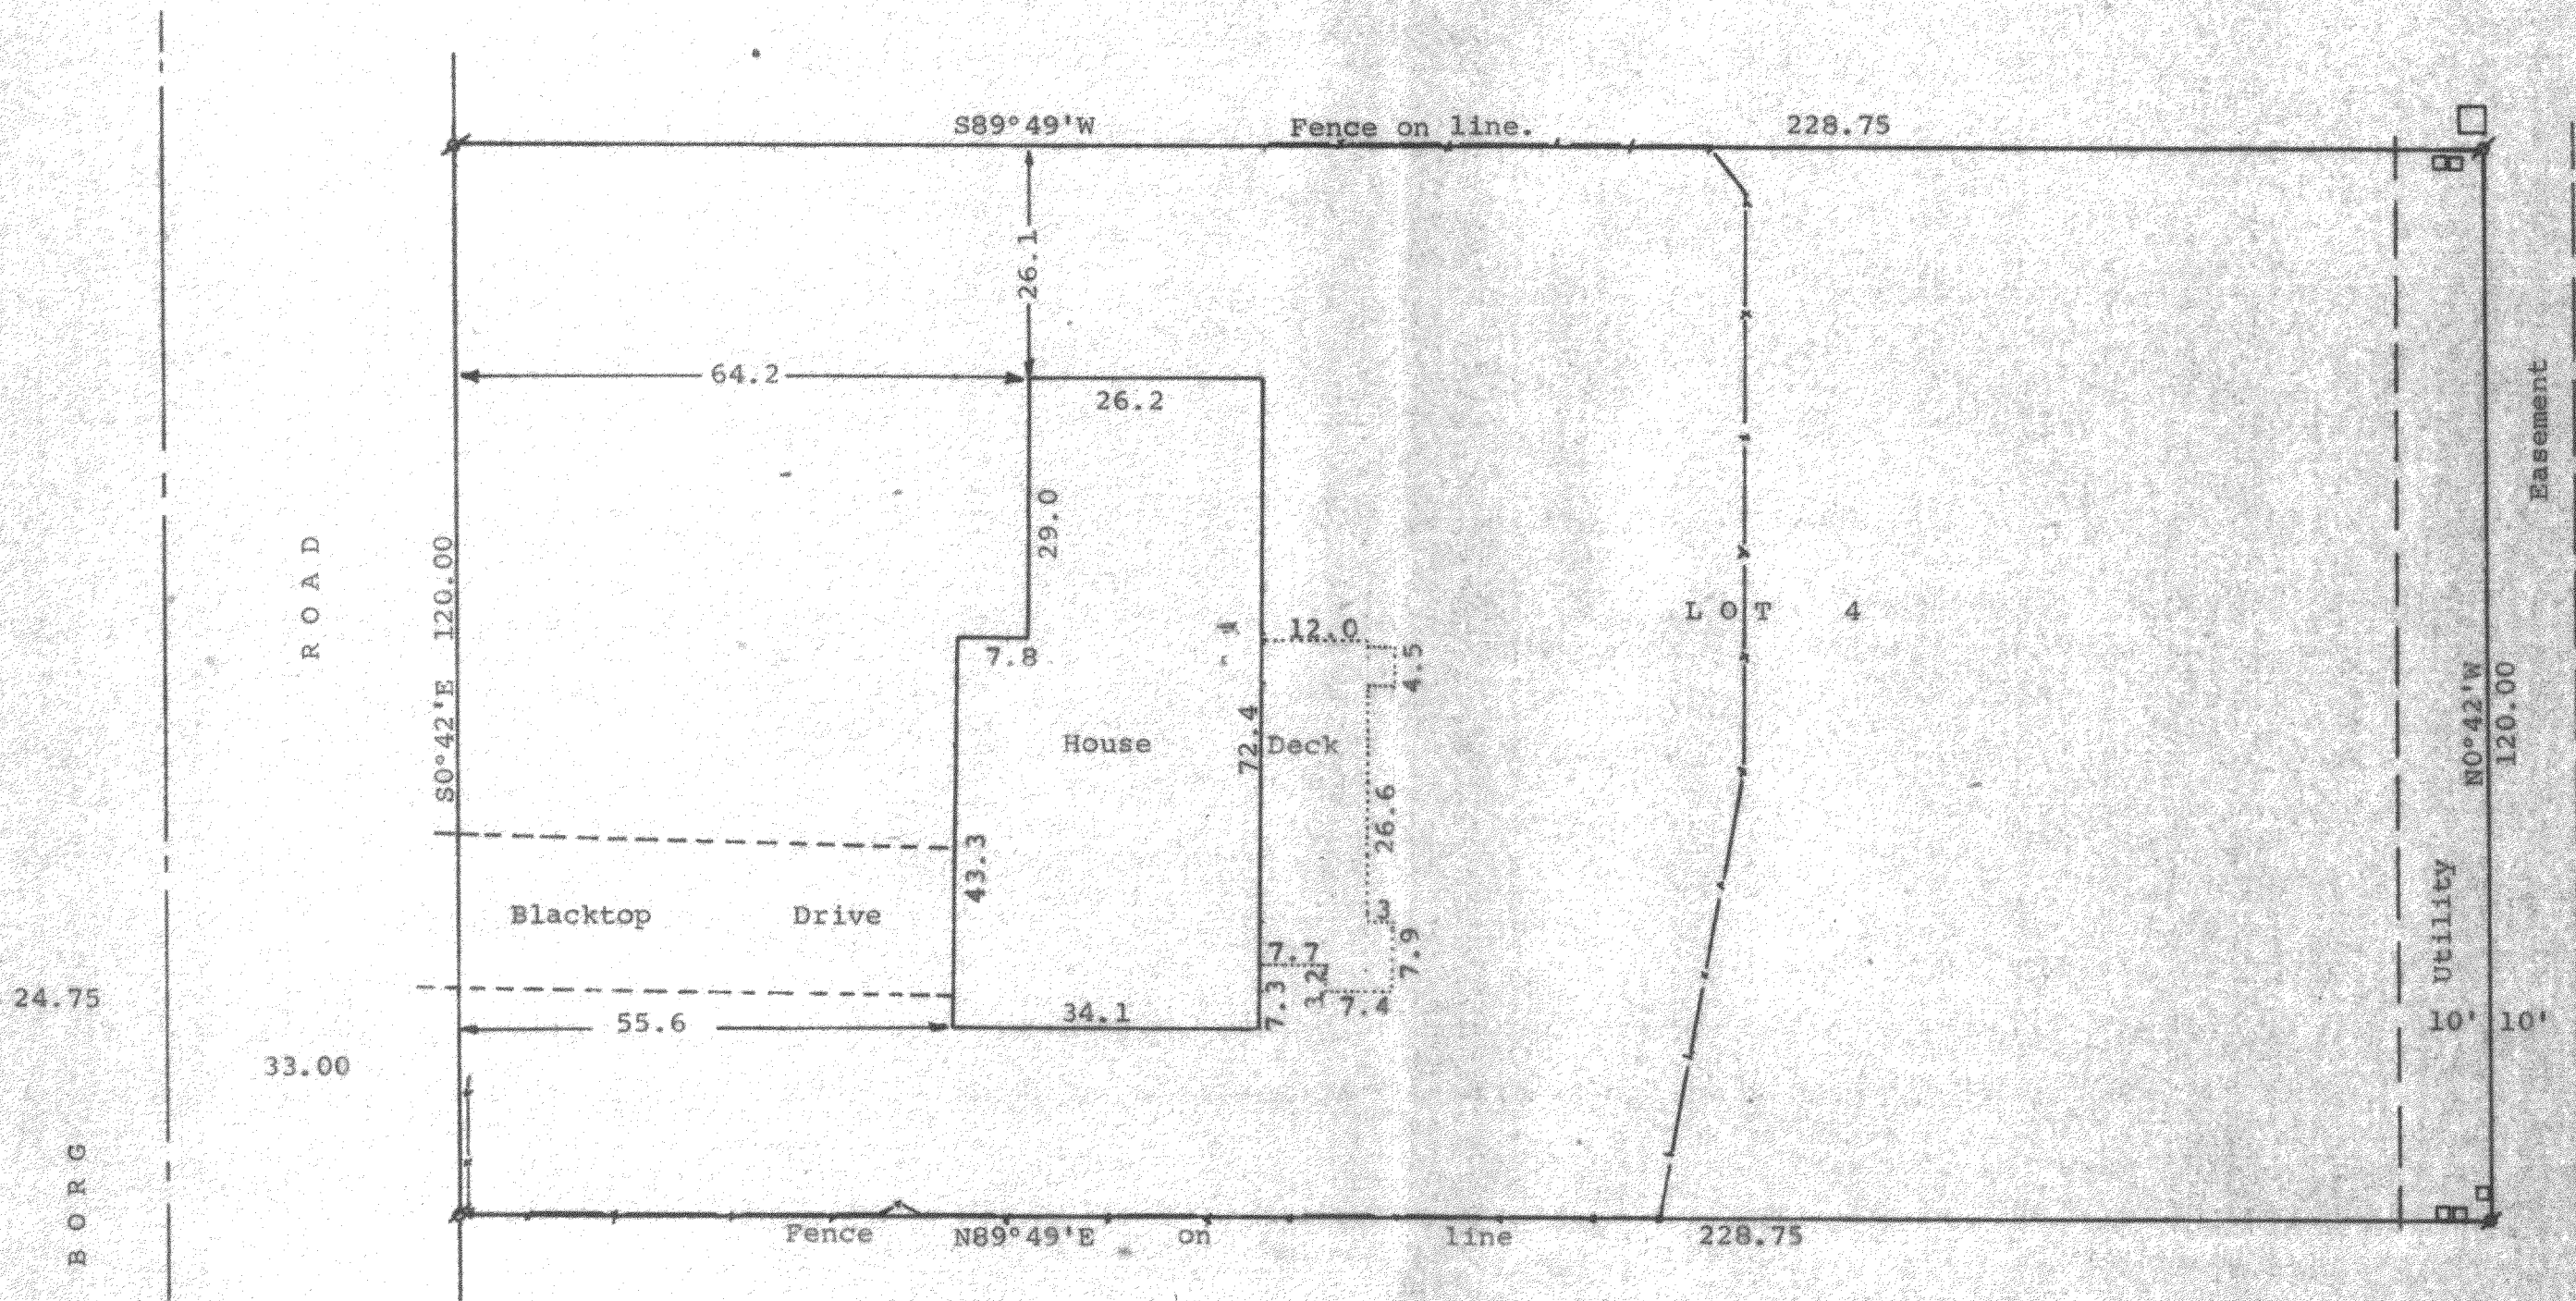

Scale - 1" = 20'  
o = 1/2" Iron Rod Found

- = Fence
- = Telephone or Electric Pedestal
- = Electrical Transformer

Bearings are those of record.  
Survey Ordered By: The Rauland Agency  
607 E. Walworth Ave.  
Delavan, Wisconsin 53115  
118 Kenosha Street  
Walworth, WI 53184



STATE OF WISCONSIN)  
COUNTY OF WALWORTH)

I, Richard C. Schulz, Surveyor, certify that I have surveyed the property described as follows, Lot 4, Oak Meadow Subdivision, located in the Northeast 1/4 of Section 29, T2N, R16E, Town of Delavan, Walworth County, Wisconsin, and that the above map is a true representation thereof and shows the size and location of the property, its exterior boundaries, the location of all visible structures and dimensions of all principal buildings thereon, boundary fences, apparent easements, roadways and visible encroachments, if any, and that I have surveyed the property hereon described according to the official records, to the best of my knowledge and belief.


July 27, 1983  
Dated & recertified this  
10th day of Feb., 1988

*Richard C. Schulz*  
Richard C. Schulz, Surveyor

*George T. Dunham*  
George T. Dunham, Surveyor

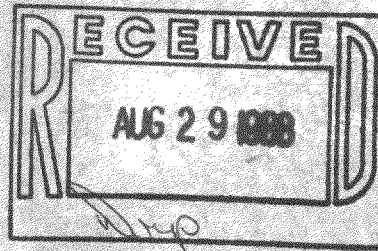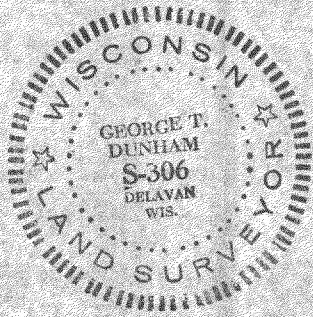

DUNHAM SURVEYING, S.C.  
SURVEYING & SUBDIVIDING  
DELAVER, WISCONSIN 53115

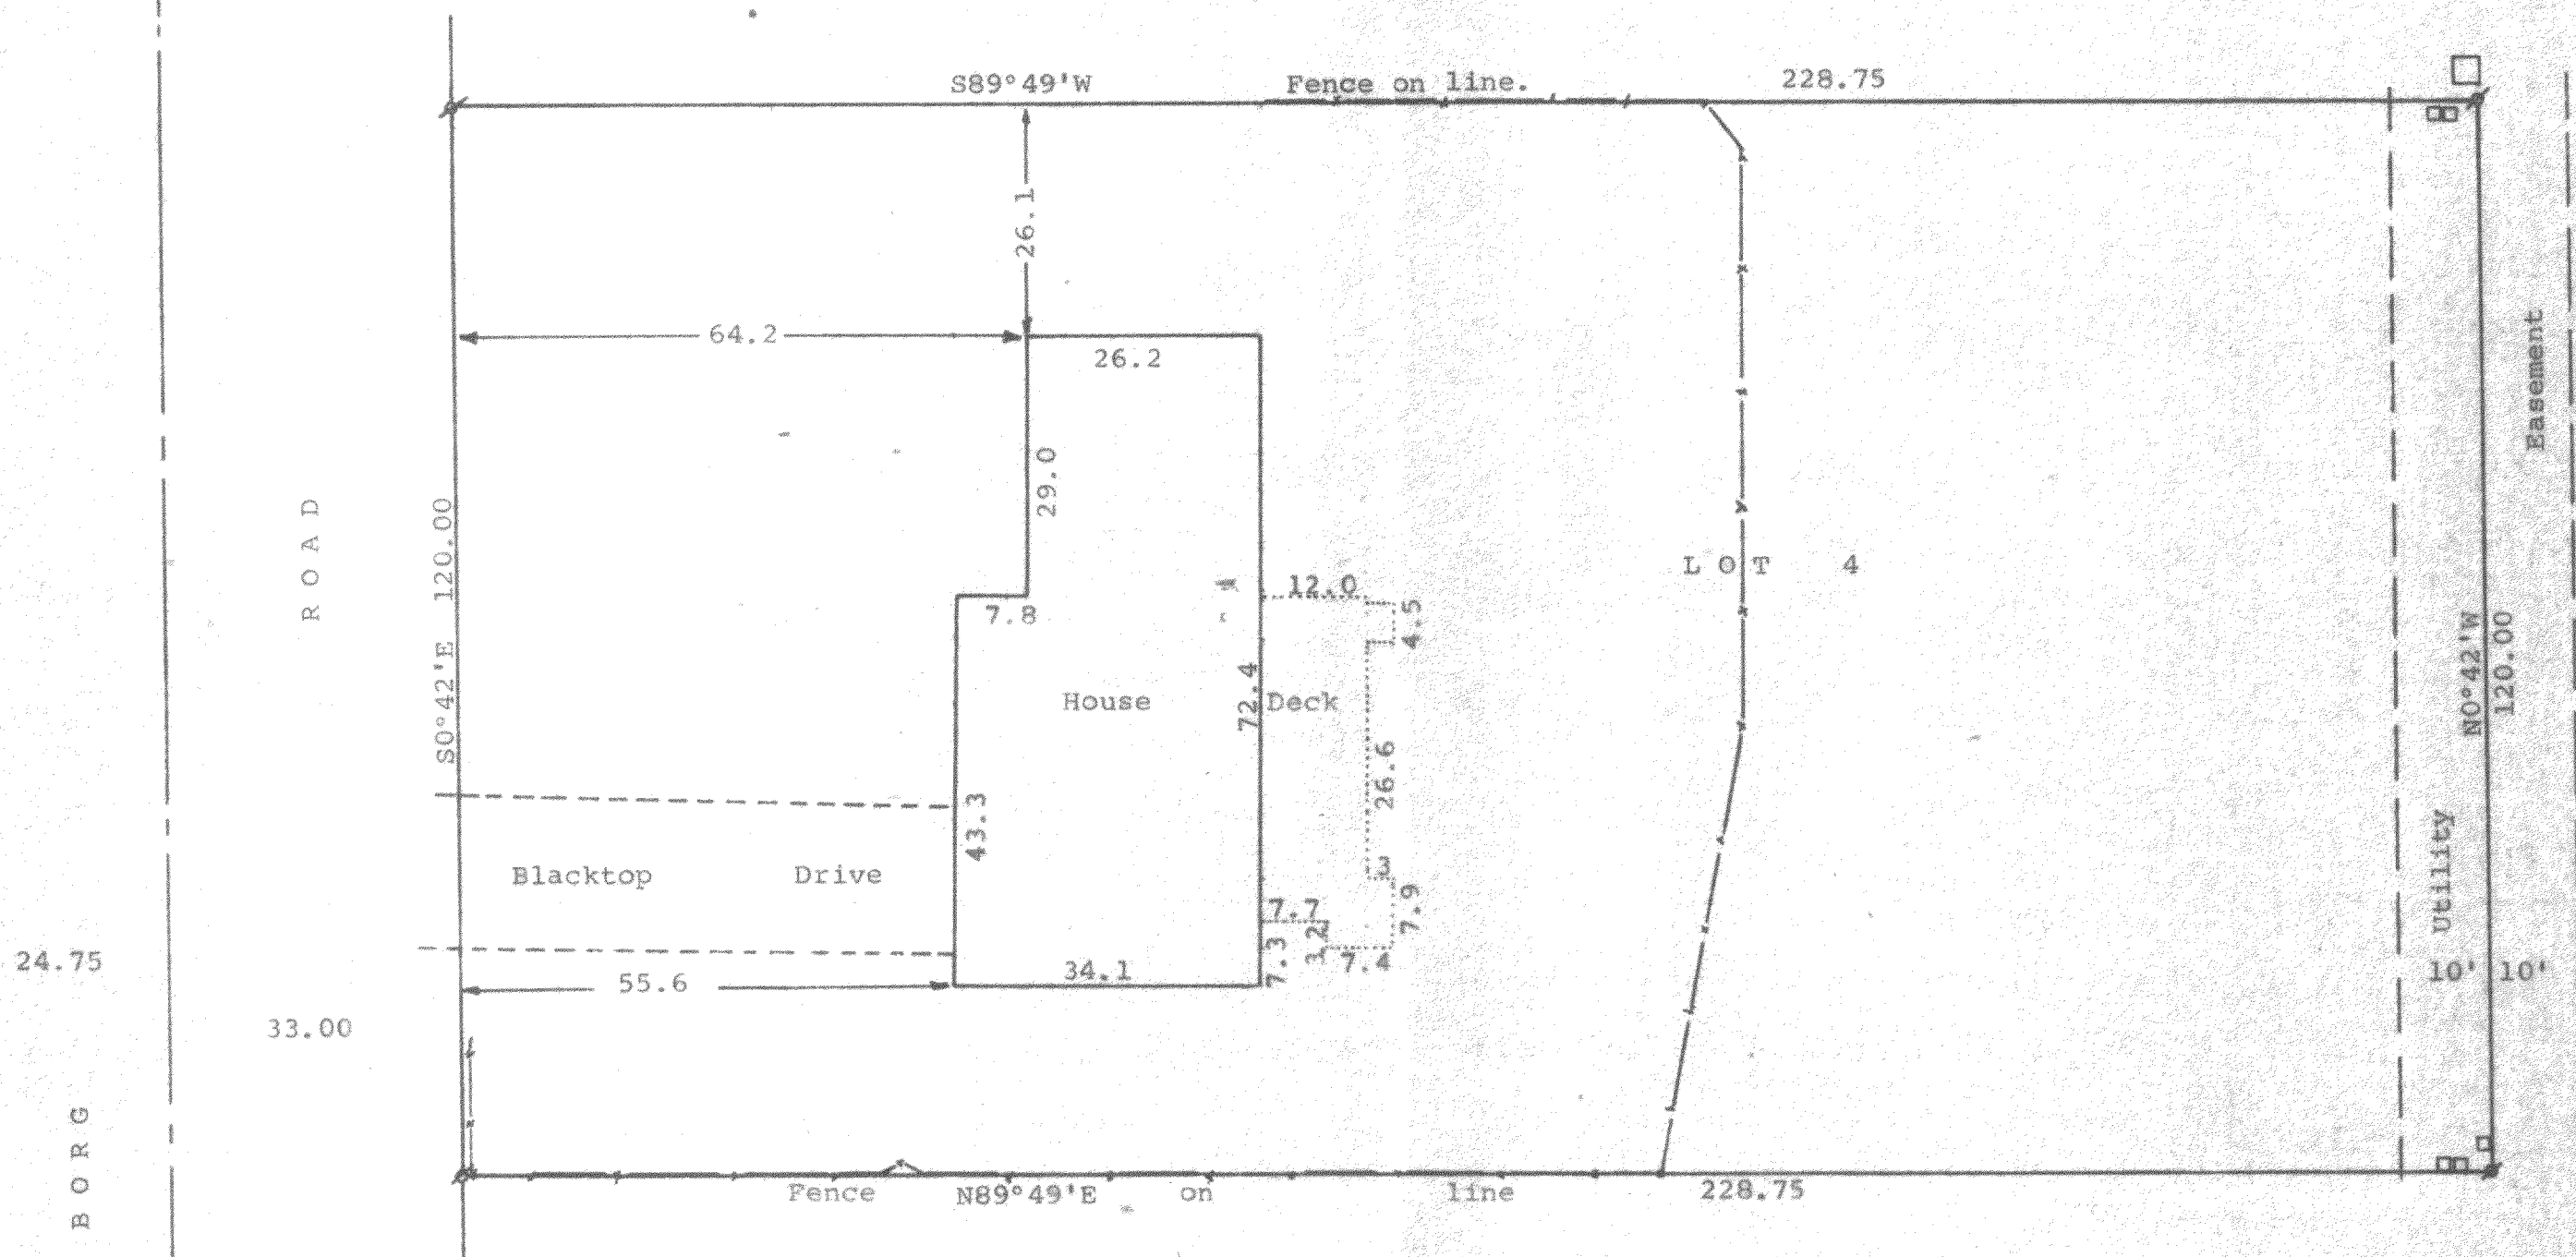



STATE OF WISCONSIN)  
COUNTY OF WALWORTH) SS

I, Richard C. Schulz, Surveyor, certify that I have surveyed the property described as follows,  
Lot 4, Oak Meadow Subdivision, located in the Northeast 1/4 of Section 29, T2N, R16E, Town of Delavan, Walworth County, Wisconsin,  
and that the above map is a true representation thereof and shows the size and location of the property, its exterior boundaries, the location of all visible structures and dimensions of all principal buildings thereon, boundary fences, apparent easements, roadways and visible encroachments, if any, and that I have surveyed the property hereon described according to the official records, to the best of my knowledge and belief.  
July 27, 1983

Dated & recertified this  
10th day of Feb., 1988

*Richard C. Schulz*  
Richard C. Schulz, Surveyor

*George T. Dunham*  
George T. Dunham, Surveyor

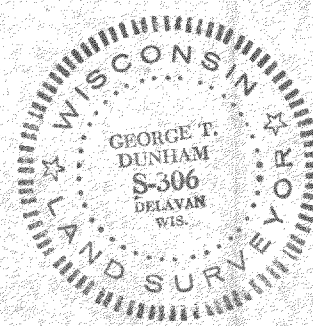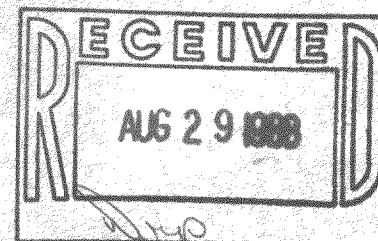

Scale - 1" = 20'  
o = 1/2" Iron Rod Found

--- = Fence  
□ = Telephone or Electric Pedestal  
□ = Electrical Transformer

Bearings are those of record.  
Survey Ordered By: The Rauland Agency  
607 E. Walworth Ave.  
Delavan, Wisconsin 53115  
118 Kenosha Street  
Walworth, WI 53184