

**SURVEYING & SUBDIVIDING
DELAN, WISCONSIN 53115**


Flood Light 0.4' East
of property line

- = concrete monument found
- = 3/4" Iron Pipe Found
- = 1" Iron Pipe Found
- = 1 1/4" Iron Pipe Found
- = 1 1/4" X 24" Iron Pipe Set
- = 3/4" X 24" Iron Pipe Set

Survey ordered by: Century 21, Skandia Realty
312 South 7th Street
Delavan, WI 53115

I, George T. Dunham, Surveyor, certify
that I have surveyed the property described as
follows:

March 14, 1988

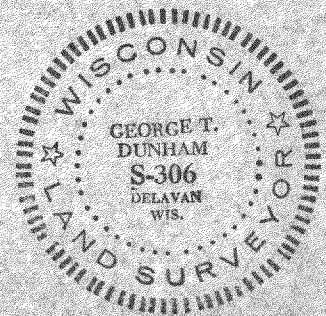

ROBBIN

216-1064