


DUNHAM SURVEYING, S.C.
SURVEYING & SUBDIVIDING
DELAVER, WISCONSIN 53115

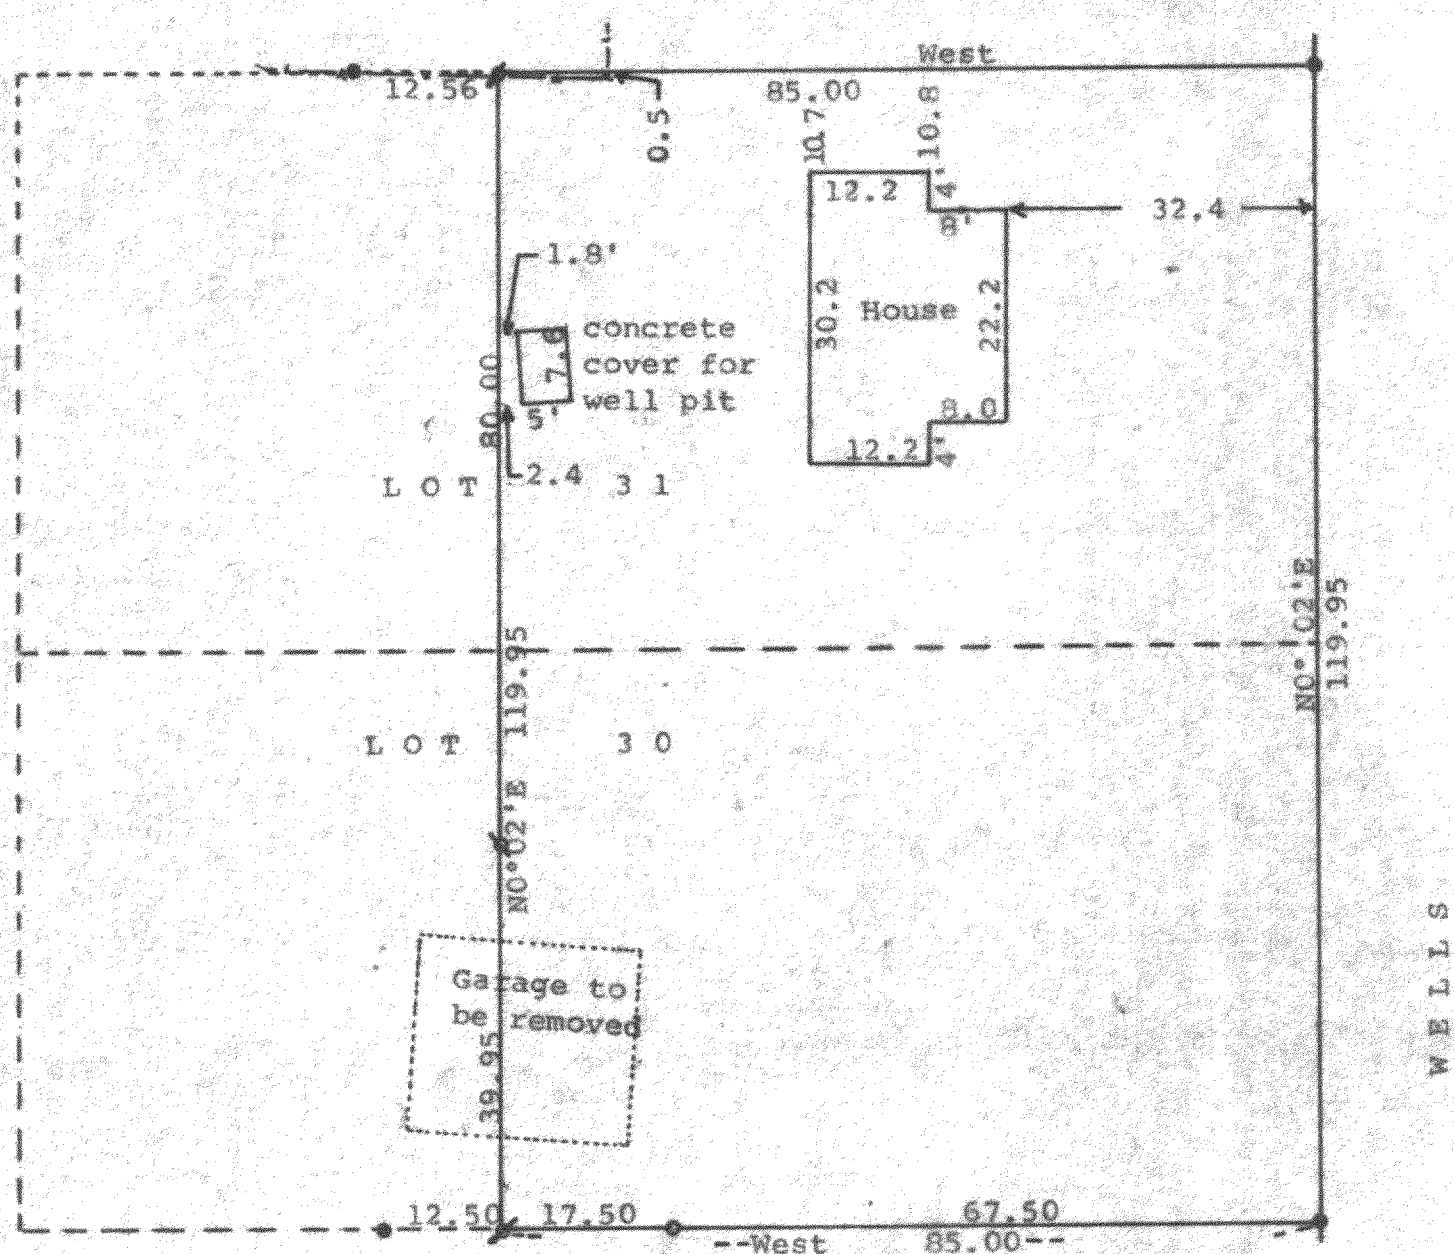

Scale - 1" = 20'

- = 1" Iron Pipe Found
- = 1 1/4" Iron Pipe Found
- ⊕ = 3/4" X 24" Iron Pipe Set
- ⊙ = 1/2" X 24" Iron Pipe Set


Bearings referenced to the assumed bearing of West along the north line of Lot 31
Survey ordered by:
Realty World, Carmin Realtors, Inc.
811 East Geneva Street
Delavan, WI 53115
--- = fence line

STATE OF WISCONSIN)
COUNTY OF WALWORTH)

I, George T. Dunham, Surveyor, certify that I have surveyed the property described as follows:

The East 85.00 feet of Lots 30 and 31 in Block 15 of Delmar Subdivision located in Section 27, T 2 N, R 16 E, Walworth County, Wisconsin,

and that the plat shown hereon is a correct representation thereof and shows the size and location of the property, its exterior boundaries, the location of all visible structures and dimensions of all principal buildings thereon, boundary fences, apparent easements, roadways and visible encroachments, if any, and that I have surveyed the property hereon described according to the official records, to the best of my knowledge and belief.
June 28, 1988

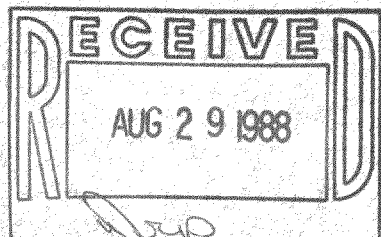

George T. Dunham
George T. Dunham, Surveyor

